


Book FW-27  
page 47



W. — E.

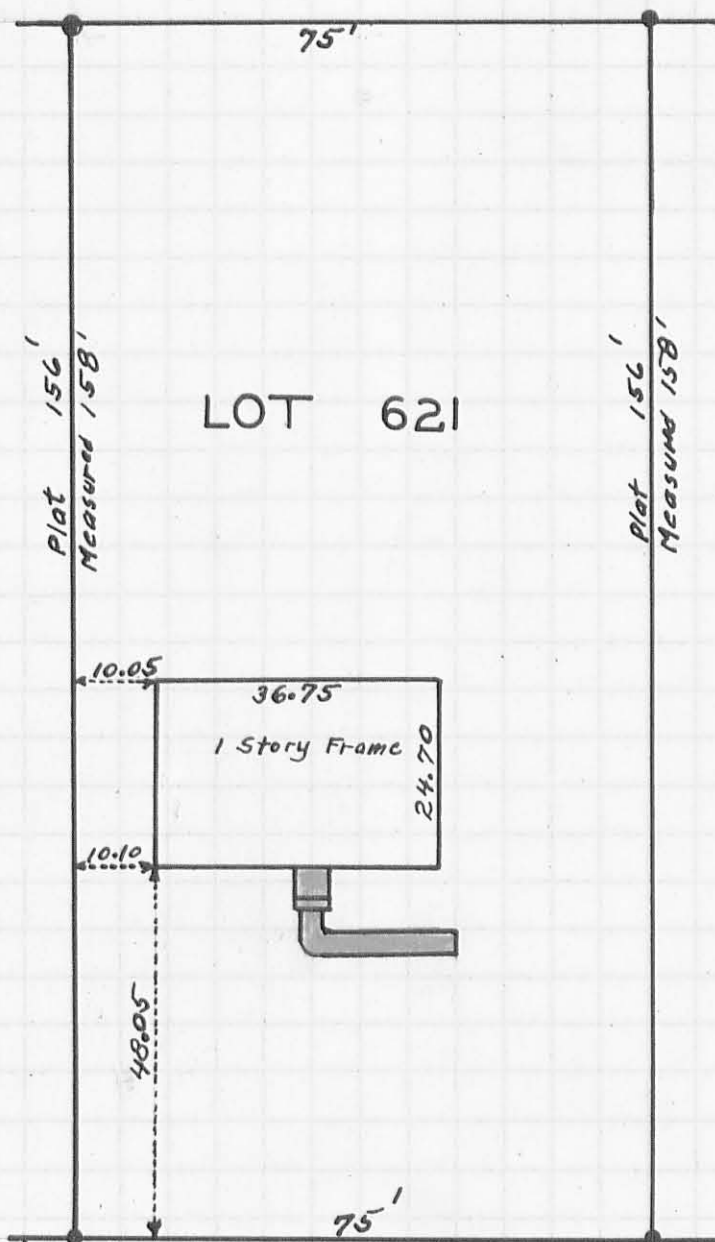

● Irons found  
 Lot 621 "Garden Acres  
 Allotment"  
 I find no encroachments  
 on Lot 621 Dec. 12, 1953  
*F. F. Wright*

2460 IP

INDEXED ON MAP

60'

LINDEN STREET

ELMORE SURVEY  
 LOT 621  
 GARDEN ACRES ALLOTMENT  
 WEST LIBERTY OHIO  
 DECEMBER 12 1953 1" = 25'  
 FOSTER F. WRIGHT