


REC'D 4-23-07 SMMY OK

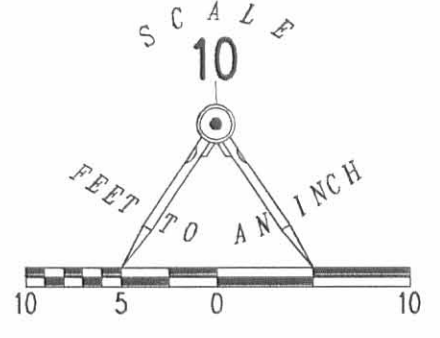

16.5' ALLEY

S 89°04'18" E
75.00'

14.3ft

35.0'

14.1ft

22.4'

VINYL SIDING

0.5ft ENCROACHMENT

19.6'

19.6'

0.9' 1.5ft ENCROACHMENT

12.6'

1.6ft ENCROACHMENT

N 00°55'42" E
150.00'

2 STORY CHURCH
WITH BASEMENT

12.6'

150.00'

S 00°55'42" W

(ORIGINAL LOT 5)
LOT 82

(ORIGINAL LOT # 1 OF WESTERN ADDITION)
THE TRUSTEES OF THE METHODIST EPISCOPAL CHURCH LOT
VOL. L, PG. 454

TUPPER STREET (60 FEET WIDE)

1.4'

58.3'

56.2'

44.2'

10.7ft

VINYL SIDING

75.00'
N 89°04'18" W

25.2ft

30.00'

N 89°04'18" W
767.48'

30.00'

NEWELL STREET (60 FEET WIDE)

A RETRACEMENT SURVEY OF
THE TRUSTEES OF THE METHODIST
EPISCOPAL CHURCH LOT
VOLUME L, PAGE 454
BEING ORIGINAL LOT # 1 OF
WESTERN ADDITION TO THE
VILLAGE OF WEST LIBERTY
PLAT CABINET A, SLIDE 65
LIBERTY TOWNSHIP
LOGAN COUNTY, OHIO

FUSON STREET

SURVEYED BY:

WILLIAM K. BRUCE
PROFESSIONAL SURVEYOR 7437
APRIL 18, 2007

COPYRIGHT 2007 BY:
LEE SURVEYING & MAPPING CO., INC.
117 North Madriver Street
BELLEFONTAINE, OHIO 43311
(937) 593-7335
surveys@lsminc.us



ORIGINAL STAMP IN GREEN

INDEXED ON MAP
MAY 18 2007

ADW D0407 4405047 L-4405047-2

2 WORKING DAYS
BEFORE YOU DIG
CALL TOLL FREE 800-362-2764
OHIO UTILITIES PROTECTION SERVICE