

Oder to Boyd Survey Description  
October, 1972

Being situated in the Village of West Liberty, Liberty Township,  
Logan County, Ohio; and being a part of Section 27, Town 5, Range 13.

Beginning at the southwest corner of Lot 268 of the Village of  
West Liberty.

Thence with the north line of County Road 175, N  $87^{\circ} - 30'W$  36.0  
feet to a iron.

Thence N  $2^{\circ} - 30'E$  140.0 feet to the true place of beginning for  
this description, passing thru the center of Mac-O-Chee Creek at 120.0  
feet.

The following three courses are up on the north and east bank of  
Mac-O-Chee Creek.

Thence N  $87^{\circ} - 30'W$  85.3 feet.

Thence N  $47^{\circ} - 04'W$  111.4 feet.

Thence N  $35^{\circ} - 58'W$  242.0 feet more or less to the waters edge on  
the north side of Mad River.

Thence with the waters edge of Mad River N  $70^{\circ} - 06'E$  366.0 feet  
more or less to the northeast corner of LaVerne C. Atha's 2.75 acre tract.

Thence with the west line of a 9.93 acre tract S  $2^{\circ} - 30'W$  356.0  
feet more or less to the northeast corner of a 0.08 acre tract.

Thence with the north line of said 0.08 acre tract N  $87^{\circ} - 30'W$   
18.0 feet.

Thence S  $2^{\circ} - 30'W$  45.0 feet to the place of beginning.


Containing 1.91 acres more or less. Being surveyed from a 4.94 acre  
tract.

---

Owen K. Shirk  
Surveyor 4271

1D  
5130

ODER TO BOYD SURVEY - VILLAGE OF WEST LIBERTY  
 LIBERTY TWP., LOGAN CO., OHIO  
 SEC. 27, T-5, R-13

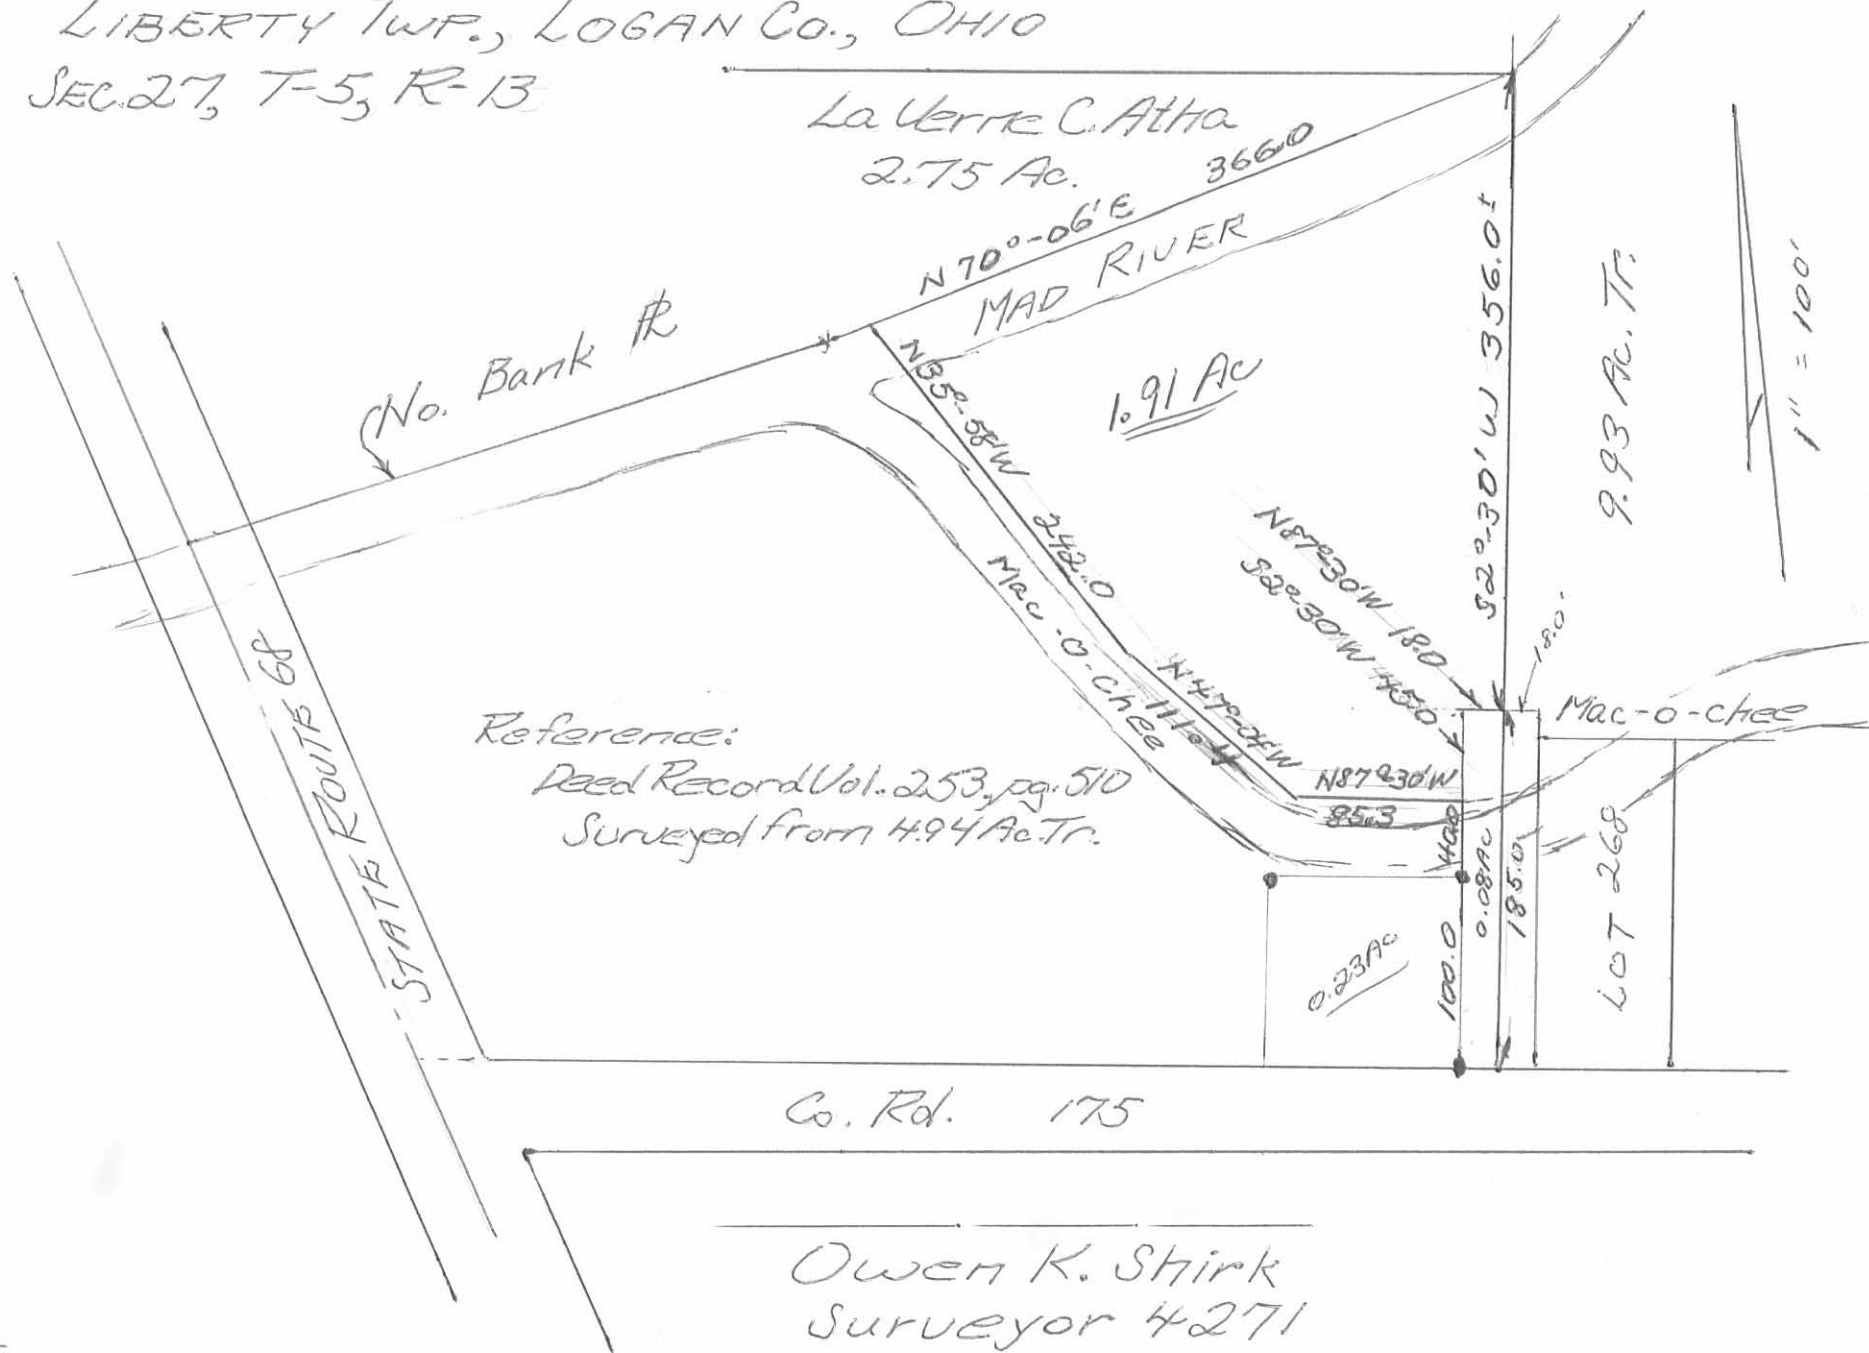

Reference:  
 Deed Record Vol. 253, pg. 510  
 Surveyed from 4.94 Ac. Tr.

Owen K. Shirk  
 Surveyor 4271  
 Oct., 1972

1P  
 5130