

Woodruff Survey

Aug., 1973

Being situated in the Village of West Liberty, Liberty Township, Logan County, Ohio; and being a part of Section 27, Town 5, Range 13. Also being a part of Village Lots 1 and 2 that is described as follows:

Beginning at an iron at the southwest corner of Village Lot 1.

Thence with the south line of lot 1 S  $88^{\circ}-46'W$  200.7 feet to an iron at the southeast corner of lot 1.

Thence with the east line of lot 1 N  $36^{\circ}-42'E$  16.0 feet to an iron.

Thence N  $1^{\circ}-25'E$  44.7 feet to an iron, passing the line between lot 1 and lot 2 at 36.7 feet.

Thence parallel to and 8.0 feet north of the south line of lot 2 N  $88^{\circ}-42'W$  210.0 feet to an iron in the west line of lot 2.

Thence with the west line of lot 2 and lot 1 S  $1^{\circ}-25'W$  58.0 feet to the place of beginning.


---

Owen K. Shirk  
Surveyor 4271

WOODRUFF SURVEY FROM DEED VOL. 315, PAGE 43 & 44  
 WEST LIBERTY, LOGAN COUNTY, OHIO  
 LIBERTY TWP., SEC. 27, TOWN 5, RANGE 13  
 1" = 30'

Owen K. Shirk  
 Surveyor 4271  
 Aug 21 & 22, 73

NOTE: from the known points that establish  
 the north line of 3 & the south line of 1, I find  
 they are not quite parallel.  
 BAIRD ST.

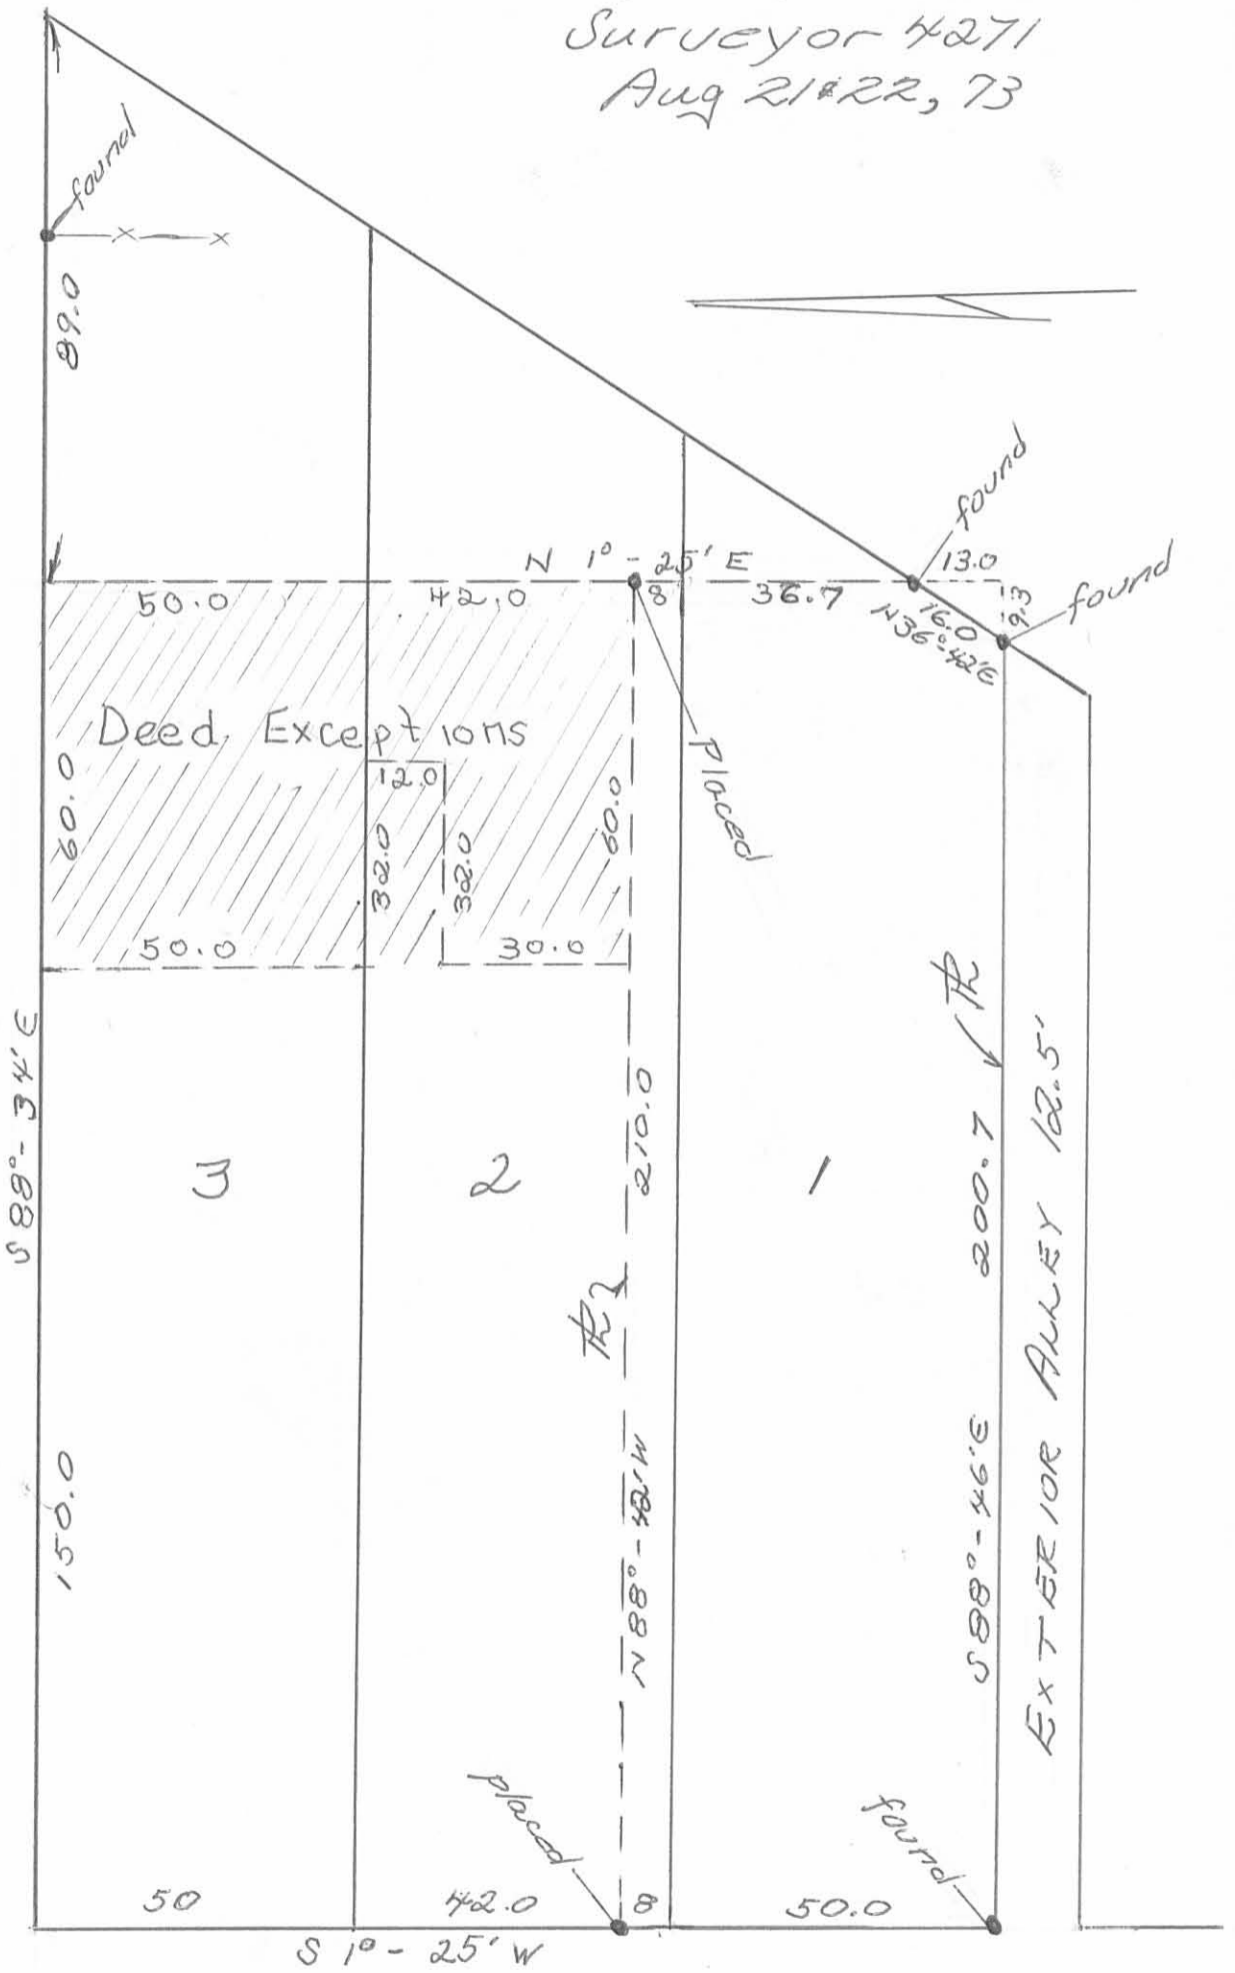

DETROIT ST