

117


LOTS 530-531-532 & W $\frac{1}{2}$ of 533
 PICKERELLTOWN ROAD
 WEST LIBERTY

- A = Remains of old Hub found
 See D Bk 2 pg 73
- B = Remains of old Hub found - "F"
 Bk 2 pg 73
- C = $\frac{3}{4}$ " pipe found "G" Bk 2
- D = $\frac{3}{4}$ " ϕ Bar found "A" Bk 2
- E = $\frac{5}{8}$ " ϕ Bar Set
- F = $\frac{5}{8}$ " ϕ Bar found Bk 2 pg 74
- G = $\frac{1}{2}$ " pipe found " " "
- H = $\frac{5}{8}$ " ϕ Bar found
- I = " " "
- J = $\frac{5}{8}$ " ϕ Bar Set
- K = Tkd Hub Set - projected A-B to K
- L = P-K nail Set @ Alley @ E North St.
- M = " " " @ North @ N. Line
 of Pickerelltown Rd.

INDEXED ON MAP
 5581

Dodson
 Arrie


June 6, 1970
 57

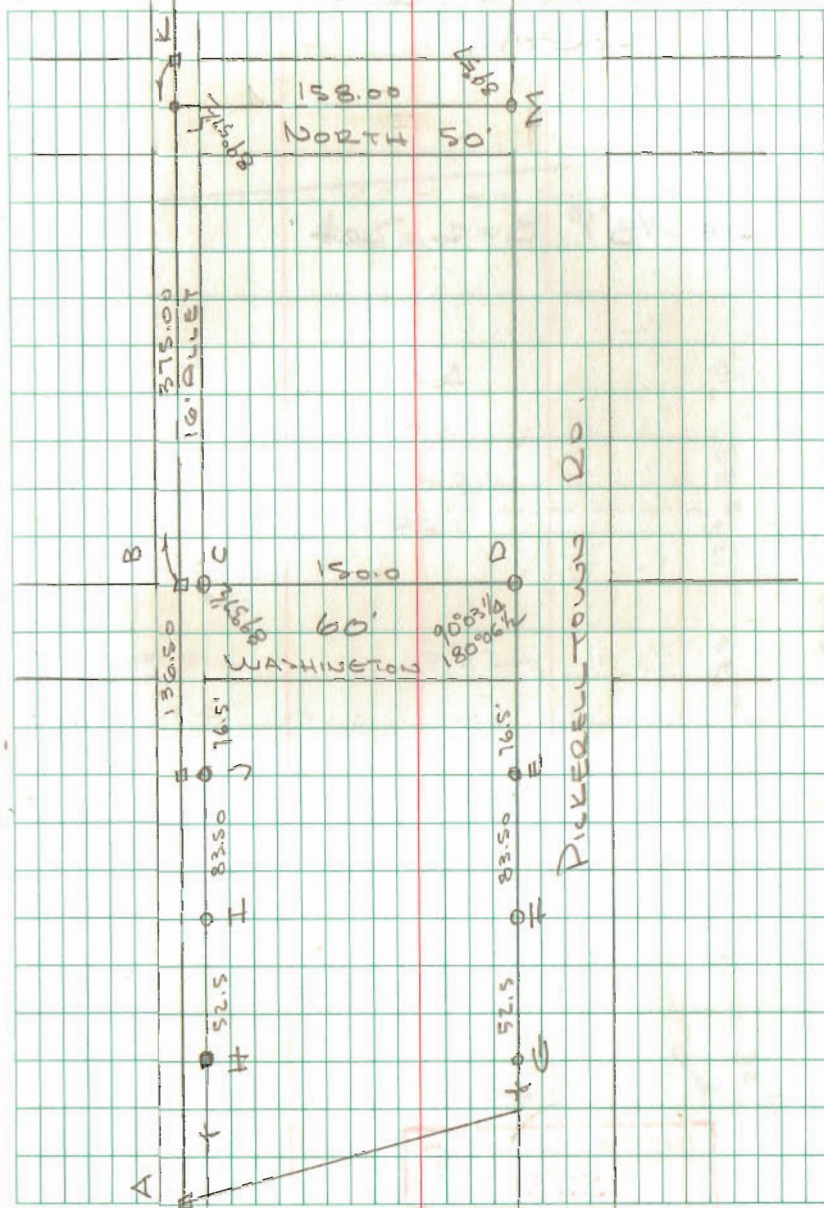

Lots 530-531-532-533
 WEST LIBERTY
 COVTD.

0 = 5/8" ϕ BAR Jet

June 6, 1970 58

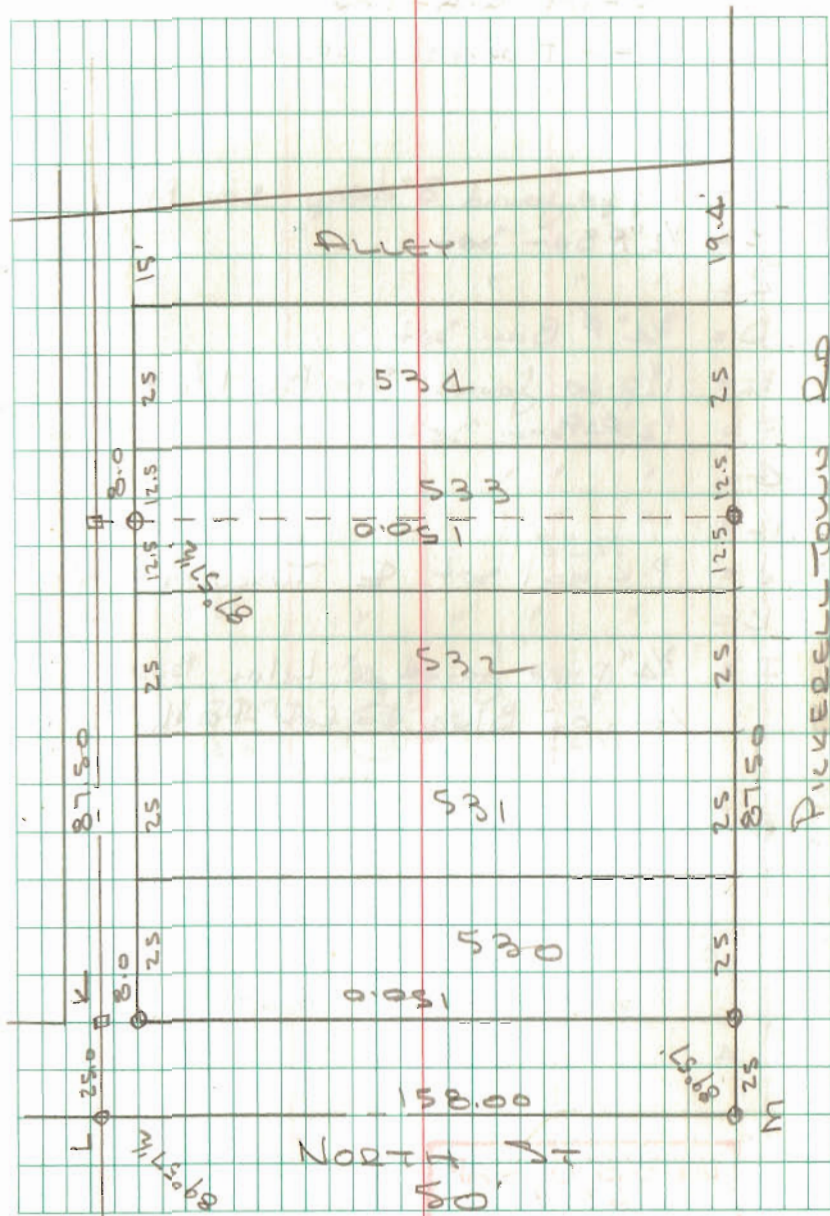

INDEXED ON MAP
 5581