


BY BHC DATE 6-22-74
CHKD. BY DATE

SUBJECT Survey for: William J. Conan
Being a part of lots No. 470 & 471
in the Happy Home Allotment to
the Village of West Liberty, Ohio

SHEET NO. 1 OF 1
JOB NO. 19-74

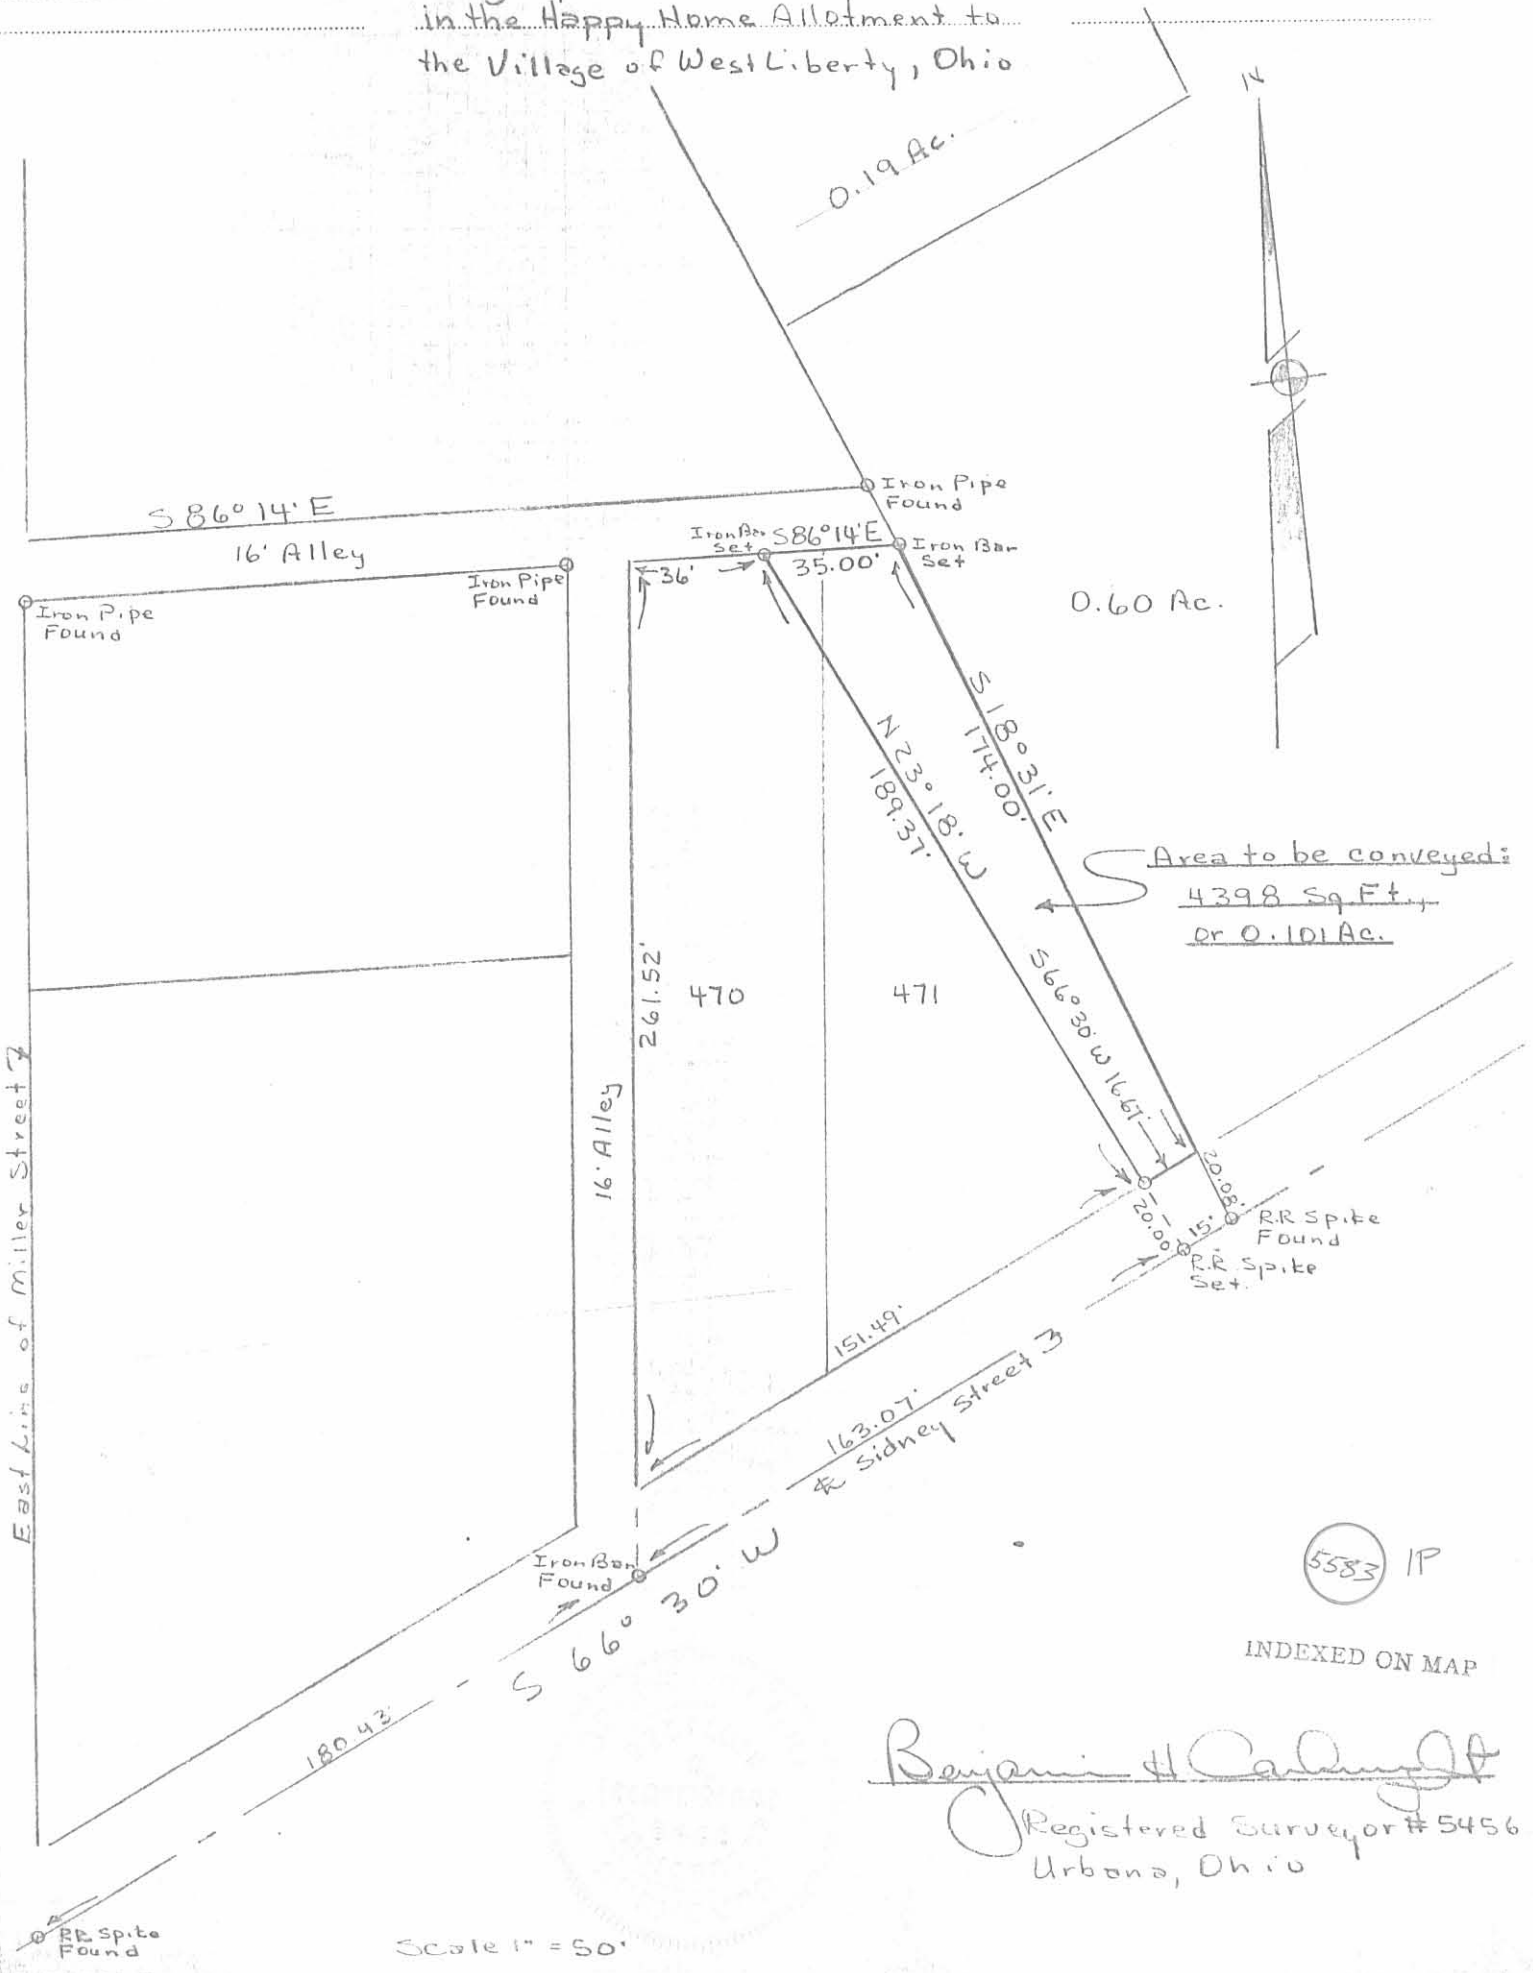

Area to be conveyed:
4398 Sq Ft.
or 0.101 Ac.

Benjamin H. Calm
Registered Surveyor # 5456
Urbana, Ohio

Scale 1" = 50'