

Lee Surveying and Mapping Co.



Farm Surveys • Lot Surveys • Topography • Subdivisions • Construction Layout

855 EAST SANDUSKY AVENUE
BELLEFONTAINE, OHIO 43311

(513) 593-5780

CLAYTON M. LEE, P.S.
JEFFREY I. LEE, P.S.

SOUTH PART OF LOT 50

Lying in the Village of West Liberty, Liberty Township, Logan County, Ohio and being the south part of Lot No. 50 as shown in the platted records of said village and better described as follows:

Beginning at an iron rod set at the southwest corner of said Lot No 50. This point lying southerly along the east line of Tupper Street a distance of 150.14 feet from the northwest corner of said Lot 50.

THENCE, northerly, along said east line of Tupper Street a distance of 46.24 feet to an iron rod.

THENCE, at right angles, easterly and parallel to the north line of Lot 50, a distance of 50.11 feet to an iron rod set in the east line of Lot 50.


THENCE, with said east line, Southerly, a distance of 46.24 feet to an iron rod set on the south line of said Lot 50.

THENCE, with said south line, Westerly, a distance of 50.11 feet to the point of beginning. Containing 0.05 acre.

Last preceding deed reference: Volume 329, Page 158.


Surveyed by:

Clayton M. Lee
Reg. Surveyor No. 6181
4-28-78

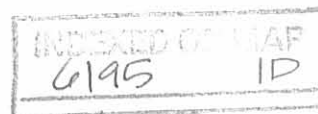

BAIRD STREET

TUPPER STREET

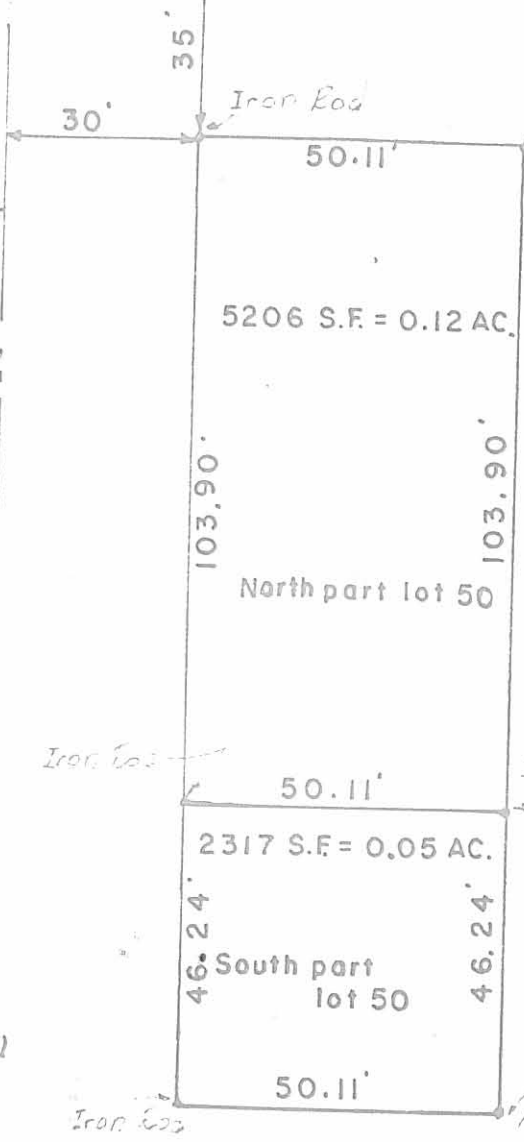

301.55' TO CENTER OF DETROIT ST.

NOTE:

There is an excess of 0.66 Lin. Ft. Between Tupper St. & Detroit St. center-lines. (381.66') Prorated=50.11' per each 50 ft. lot.

There is, presently, a frame residence & frame garage located on the north part lot and a frame residence on the south part.



SCALE - 1" = 30'

SURVEY & PARTITIONING OF LOT NO. 50 VILLAGE OF WEST LIBERTY LIBERTY TWP, LOGAN CO., OHIO



Surveyed by:

Clayton M. Lee

Clayton M. Lee
Reg. Surveyor 6181
4-28-78

6195 IP

INDEXED ON MAP

Lee Surveying & Mapping Co.
855 E. Sandusky Ave.
BELLEFONTAINE, OHIO 43311
(513) 593-5780

L-410-S