




Book FW-27
Page 21



6426 IP

INDEXED ON MAP

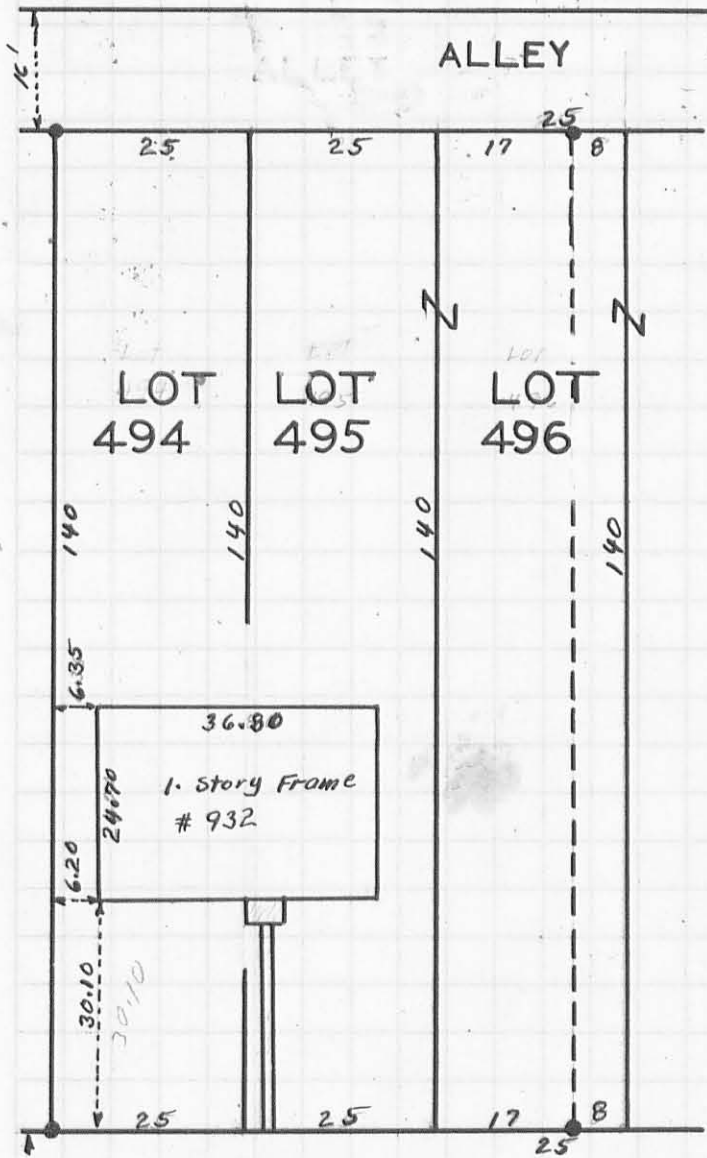

W. E.

ELMORE SURVEY

LOTS 494-495 & 17' OF 496
YODER SUBDIVISION NO. 1

LINDEN STREET

WEST LIBERTY OHIO,
AUGUST 1953 1 1/2" = 25'
FOSTER F. WRIGHT

I find no encroachments on
lots 494-495 and 17 feet off of
west side of Lot 946
August 8, 1953
Foster F. Wright

• Irons

60'