


Survey for Court of E.T. Winston
 Land in West Mansfield (Surv. 775)

July 9, 30 R.M. Renick
 J. S. Crane

Found Iron Bar at Herbert
 Cooks S.E. Corner.

1184
 INDEXED ON MAP

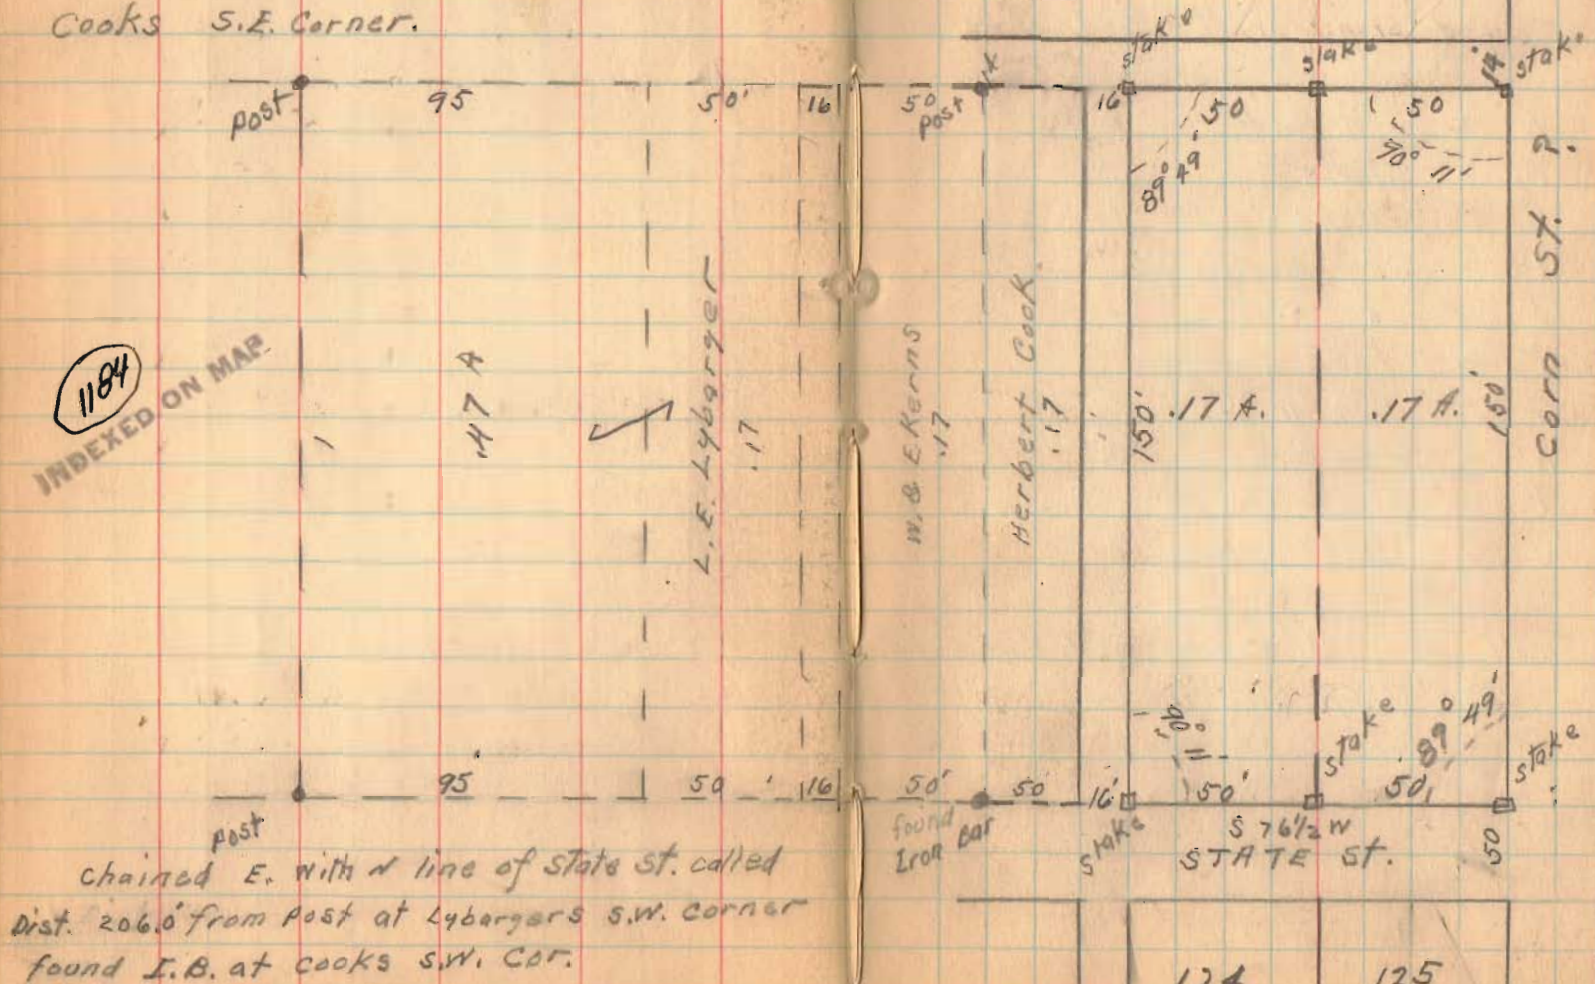


Survey for Common Pleas Court of Edward T. Winston
Land, Surv. 775 West Mansfield, Ohio.

A-B-C-D-E-F = 2"x2" STAKES
H=Post at Cooks N.W. Corner
C " " " S.W. " "
Surveyed by J. S. Brane
Deputy Co. Surveyor
July 9, 1930



Scale 1 Inch = 40 Feet

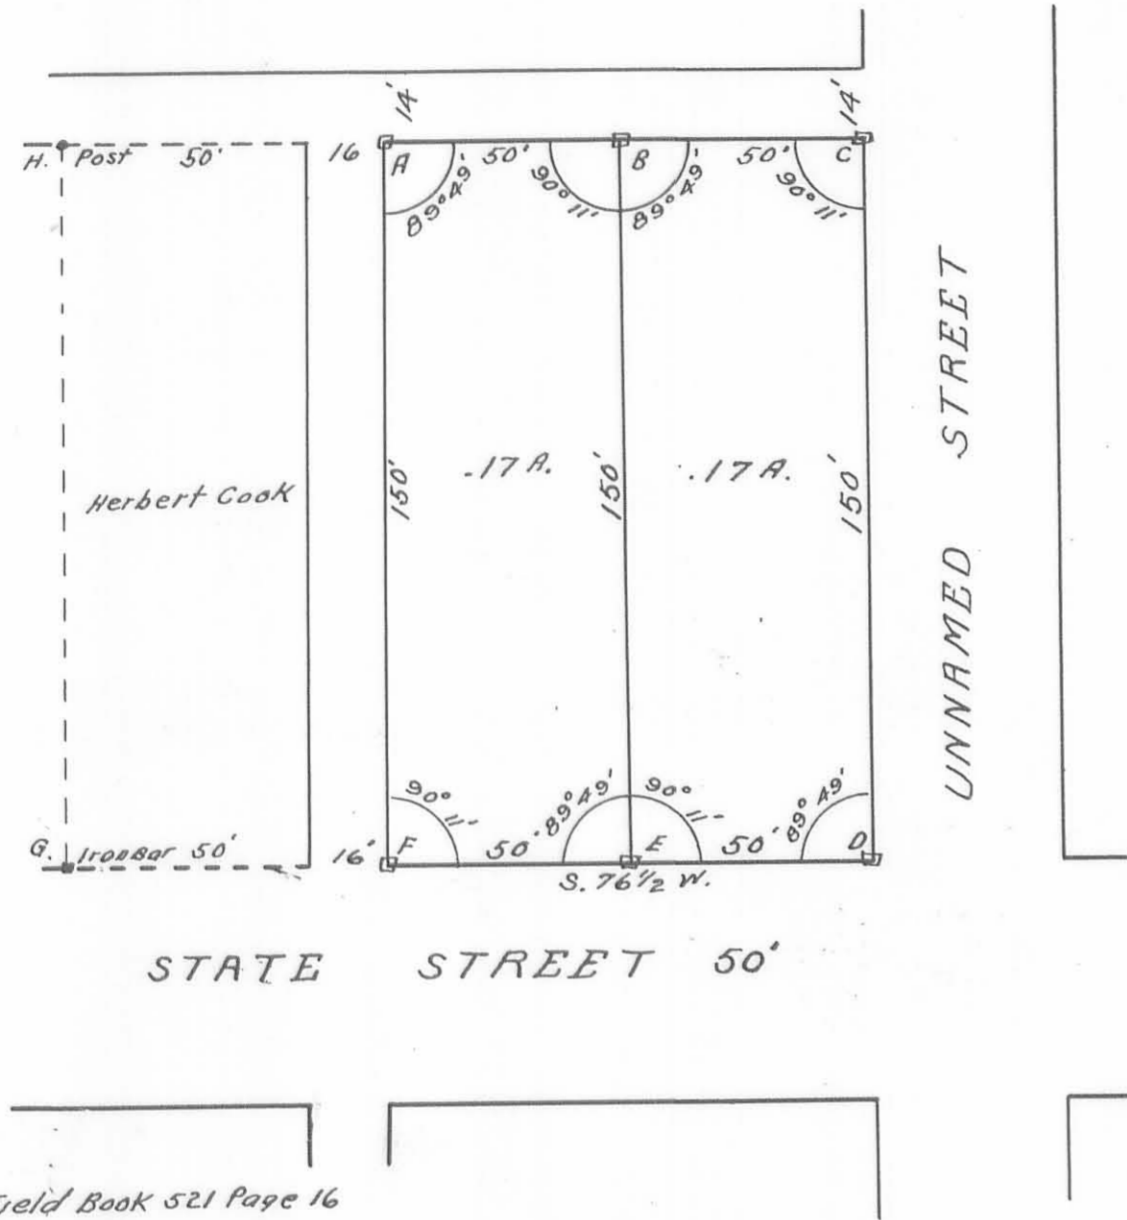

Survey Notes in Field Book 521 Page 16

1184
INDEXED ON MAP