

Spiker Survey Description

March, 1972

Being situated in the Village of West Mansfield, Bokescreek Township, Logan Countt, Ohio; and being a part of V.M.S. #775 - 6155.

Beginning at a iron at the intersection of the south right of way line of State Street extended and the east right of way line of Mann Street (Starrett Pike).

Thence with said east right of way line of Mann Street extended S 10° - $00'$ W 335.5 feet to a corner post in the north right of way line of the T. and O.C Railroad.

Thence with said north right of way line of the T. and O.C. Railroad N 35° - $07'$ W 275.5 feet to a iron.

Thence N 5° - $23'$ E 137.3 feet to a iron in the south line of State Street.

Thence with the south line of State Street S 81° - $11'$ E 206.4 feet to the place of beginning.

Containing 1.08 acres more or less. Being surveyed from a 1.35 acre tract.




Owen K. Shirk
Surveyor 4271

4916 10

INDEXED ON MAP

SPIKER SURVEY - VILLAGE OF WEST MANSFIELD
 BOKESCREEK TWP., LOGAN CO., OHIO.
 V.M.S. 775-6155; 1" = 50'; • DENOTES IRONS

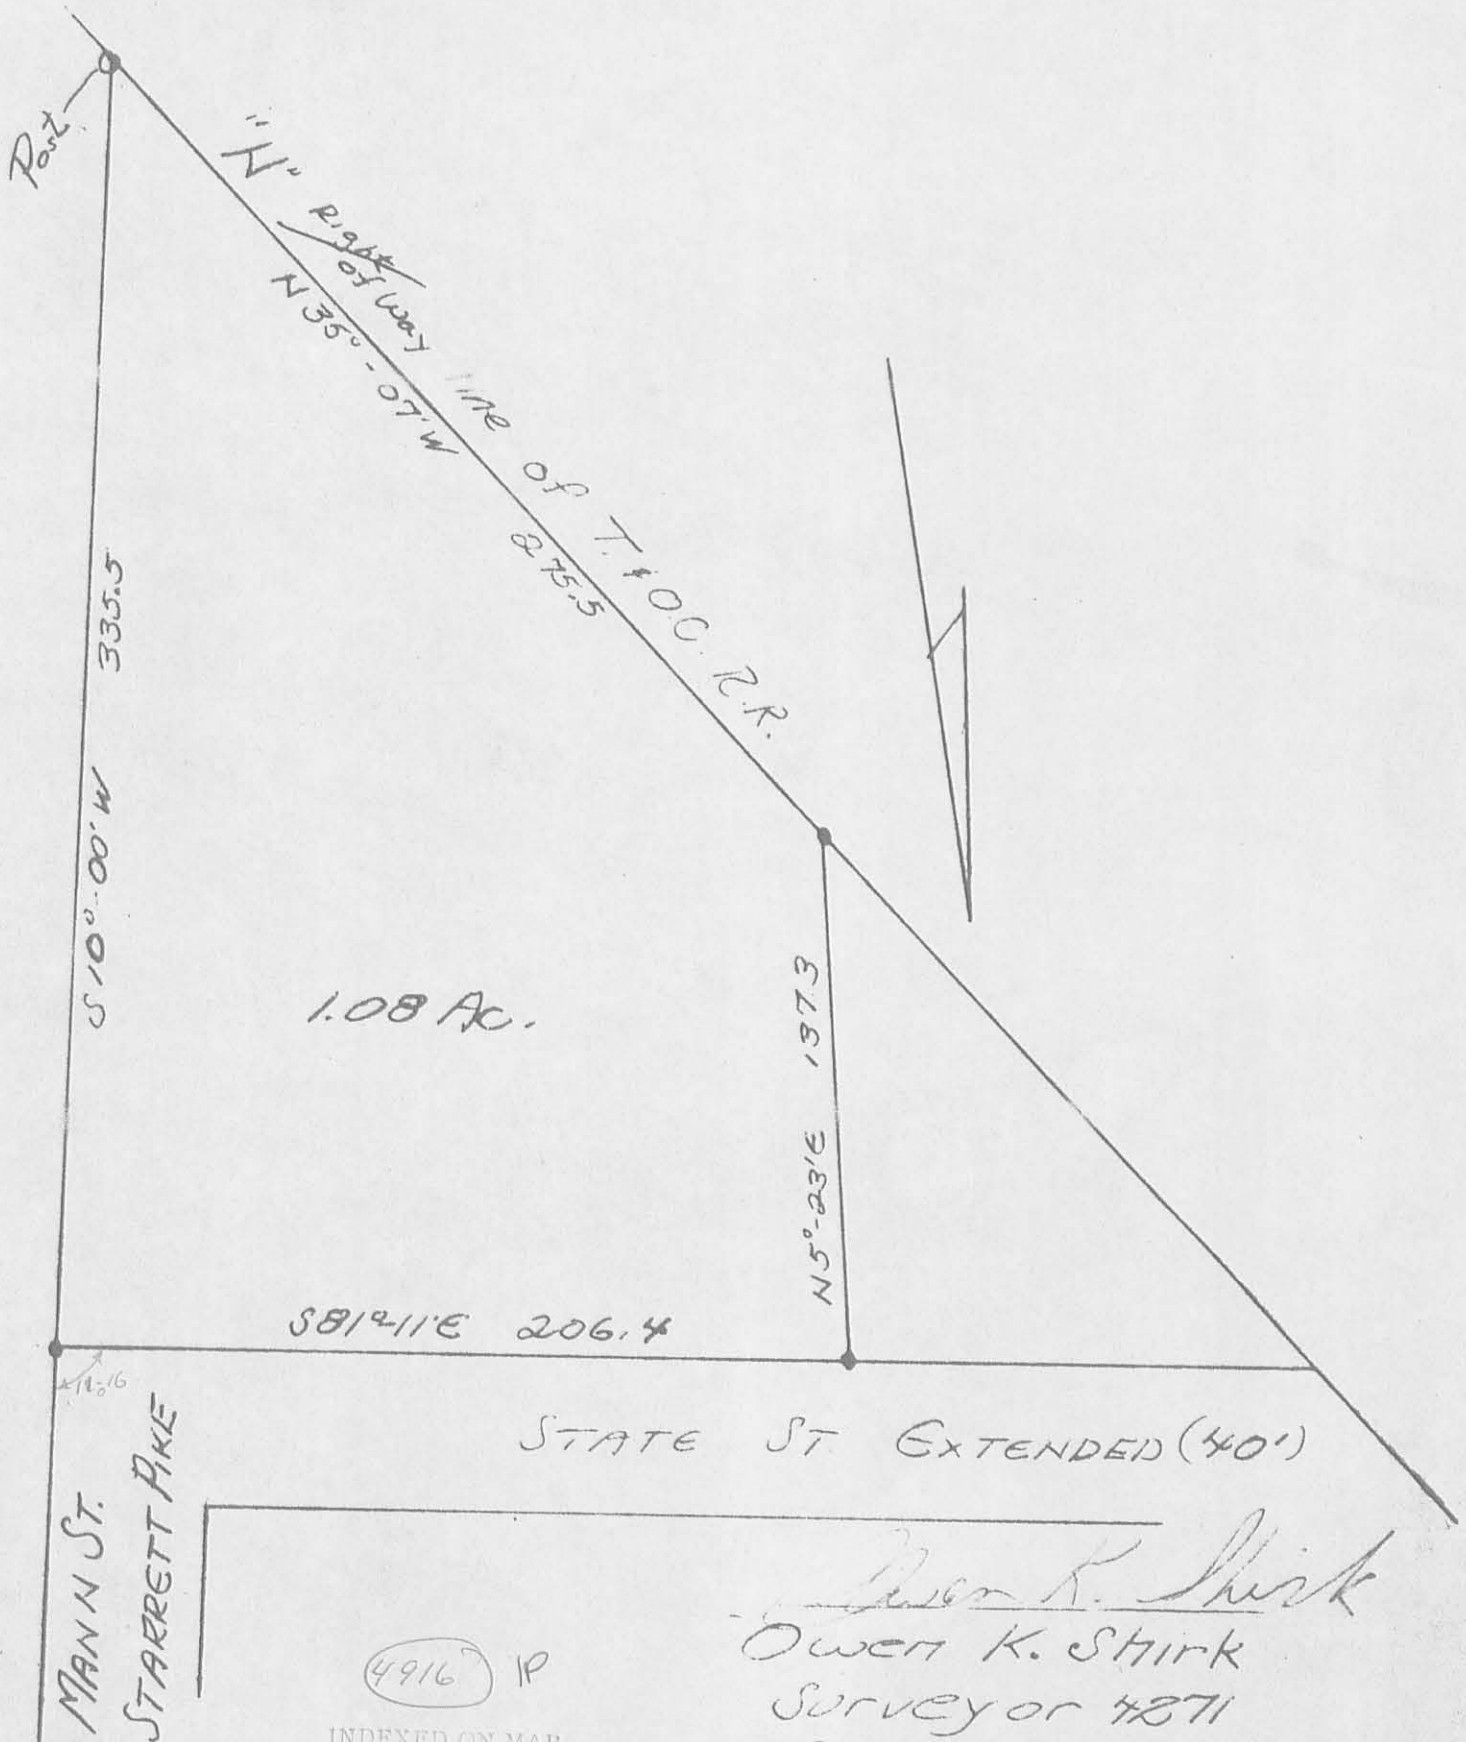

4916 IP

INDEXED ON MAP

Owen K. Shirk
 Owen K. Shirk
 Surveyor 4271
 Surveyed: 3-28-72