

Foreman Survey  
West Mansfield, Ohio

June 16, 1973

The following described real estate situated in the Village of West Mansfield, Township of Bokescreek, County of Logan, State of Ohio and being a part of Virginia Military Survey No. 775-6155 and being more particularly described as follows:

Beginning at an iron bar in the centerline of South Dean Street, that is S.  $13^{\circ} 30'$  E. 537.13 feet from the intersection of the centerlines of South Dean Street and State Street (formerly Mill Street); said iron bar being the northeast corner to Wilma Shirks present 0.42 Acre tract;

Thence with the line between Shirk and Foreman, N.  $76^{\circ} 42'$  W. 285.62 feet to round wood corner post, passing through an iron bar at the west side of South Dean Street at 22.41 feet;


Thence with an existing fence line, N.  $9^{\circ} 36'$  E. 58.00 feet to an iron bar, an interior corner to Arthur W. Wallace's present 0.71 Acre tract;

Thence S.  $76^{\circ} 42'$  E. 260.06 feet to a R. E. Spike in the centerline of South Dean Street, passing through an iron bar at the south west corner to Clyde F. Morrow's present 0.315 Acre tract, and an iron bar at the west side of South Dean Street at 237.65 feet;

Thence with the centerline of South Dean Street, S.  $13^{\circ} 30'$  E. 64.98 feet to the place of beginning, containing 0.363 Acres, more or less. Of the above described 0.363 Acres, there is 0.030 Acres are in the right of way of South Dean Street.

I hereby certify that this is a true and accurate description of a survey made by me on June 16, 1973.

*Daniel E. Gilbert*  
Daniel E. Gilbert, P.S.  
Reg. Sur. No. 5402  
1041 N. Main St.  
Bellefontaine, Ohio 43311

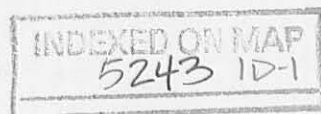

June 16, 1973

The following described real estate situated in the Village of West Mansfield, Township of Bokescreek, County of Logan, State of Ohio and being a part of Virginia Military Survey No. 775-6155 and being more particularly described as follows:

Beginning at a R. R. Spike in the centerline of South Dean Street, that is S.  $13^{\circ} 30'$  E. 336.00 feet from the intersection of the centerlines of South Dean Street and State Street (formerly Mill Street), said R. R. Spike being the southeast corner to Arthur W. Wallace's present 0.71 Acre tract;

Thence with the centerline of South Dean Street, S.  $13^{\circ} 30'$  E. 136.15 feet to a R. R. Spike, northeast corner to Bessie E. Foreman's present 0.363 Acre tract;

Thence with the line between Foreman and Morrow, N.  $76^{\circ} 42'$  W. 152.41 feet to an iron bar, an interior corner to Wallace's tract, passing through an iron bar at the west line of South Dean Street at 22.41 feet;

Thence with the east line of Wallace, N.  $10^{\circ} 00'$  W. 67.60 feet to an iron bar, an interior corner to Wallace;


Thence with a south line of Wallace, N.  $76^{\circ} 30'$  E. 132.00 feet to the place of beginning, passing through an iron bar at the west line of South Dean Street at 112.00 feet, containing 0.315 Acres, more or less. Of the above described 0.315 Acres, there is 0.060 Acres in the right of way of South Dean Street.

I hereby certify that this is a true and accurate description of a survey made by me on June 16, 1973.

*Daniel E. Gilbert*

Daniel E. Gilbert, P.S.  
Reg. Sur. No. 5402  
1041 N. Main St.  
Bellefontaine, Ohio 43311

INDEXED ON MAP  
5243 1D-2

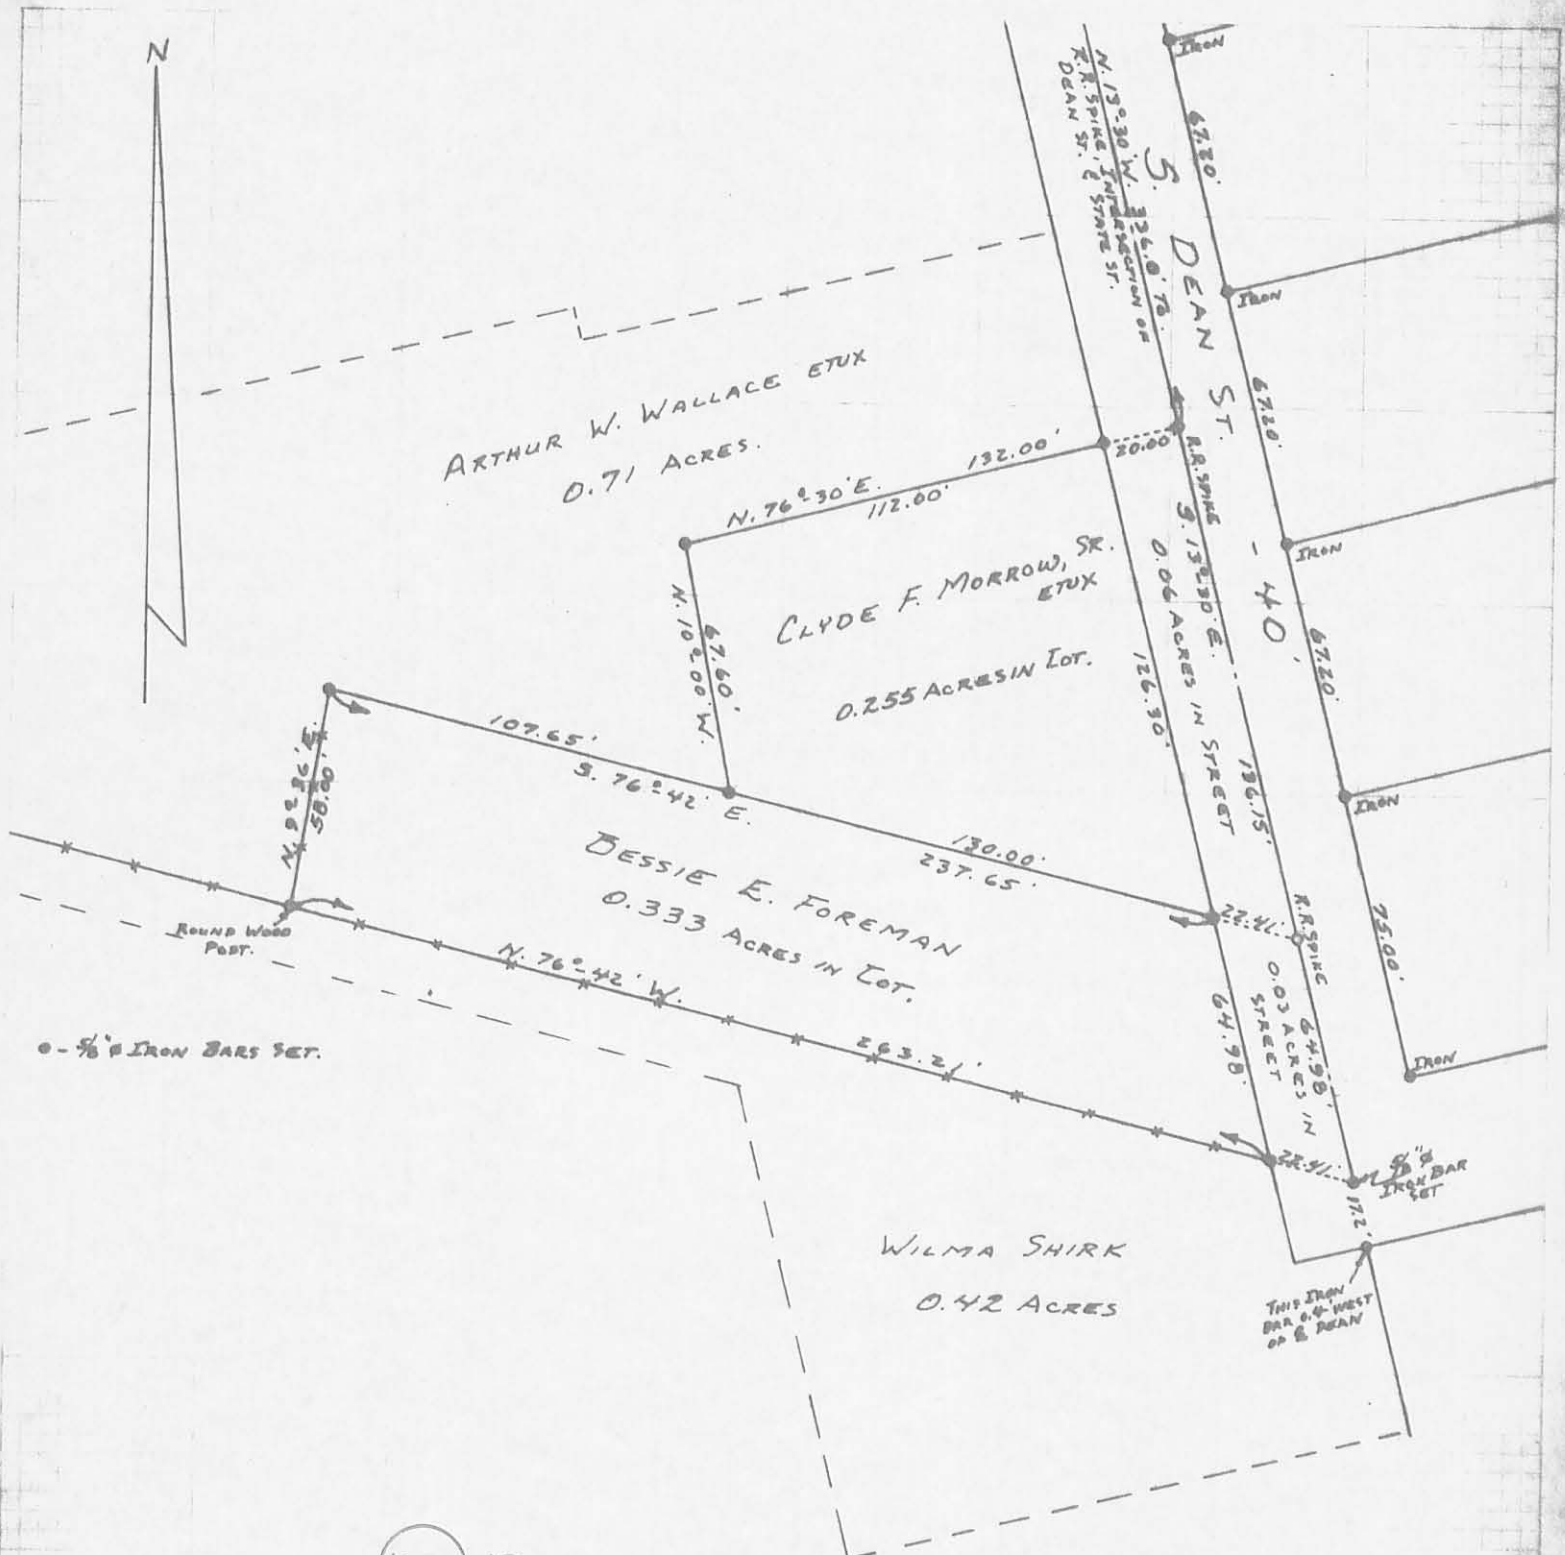

5243 IP

INDEXED ON MAP

SURVEYED AND PLATTED BY:  
 DANIEL E. GILBERT, P.S.  
 REG. SUR. NO. 5402  
 1041 N. MAIN ST.  
 BELLEFONTAINE, OHIO 43311

FOREMAN & MORROW SURVEYS  
 V.M.S. No. 775-6155  
 VILLAGE OF WEST MANSFIELD  
 BOKESCREEK TOWNSHIP  
 LOGAN COUNTY, OHIO  
 JUNE 16, 1973

SCALE: 1" = 50'