


LEGEND:

- = P.K. NAIL
- = 5/8" IRON BAR
- = R.R. SPIKE
- = 1/4" DRILL HOLE LOT 26

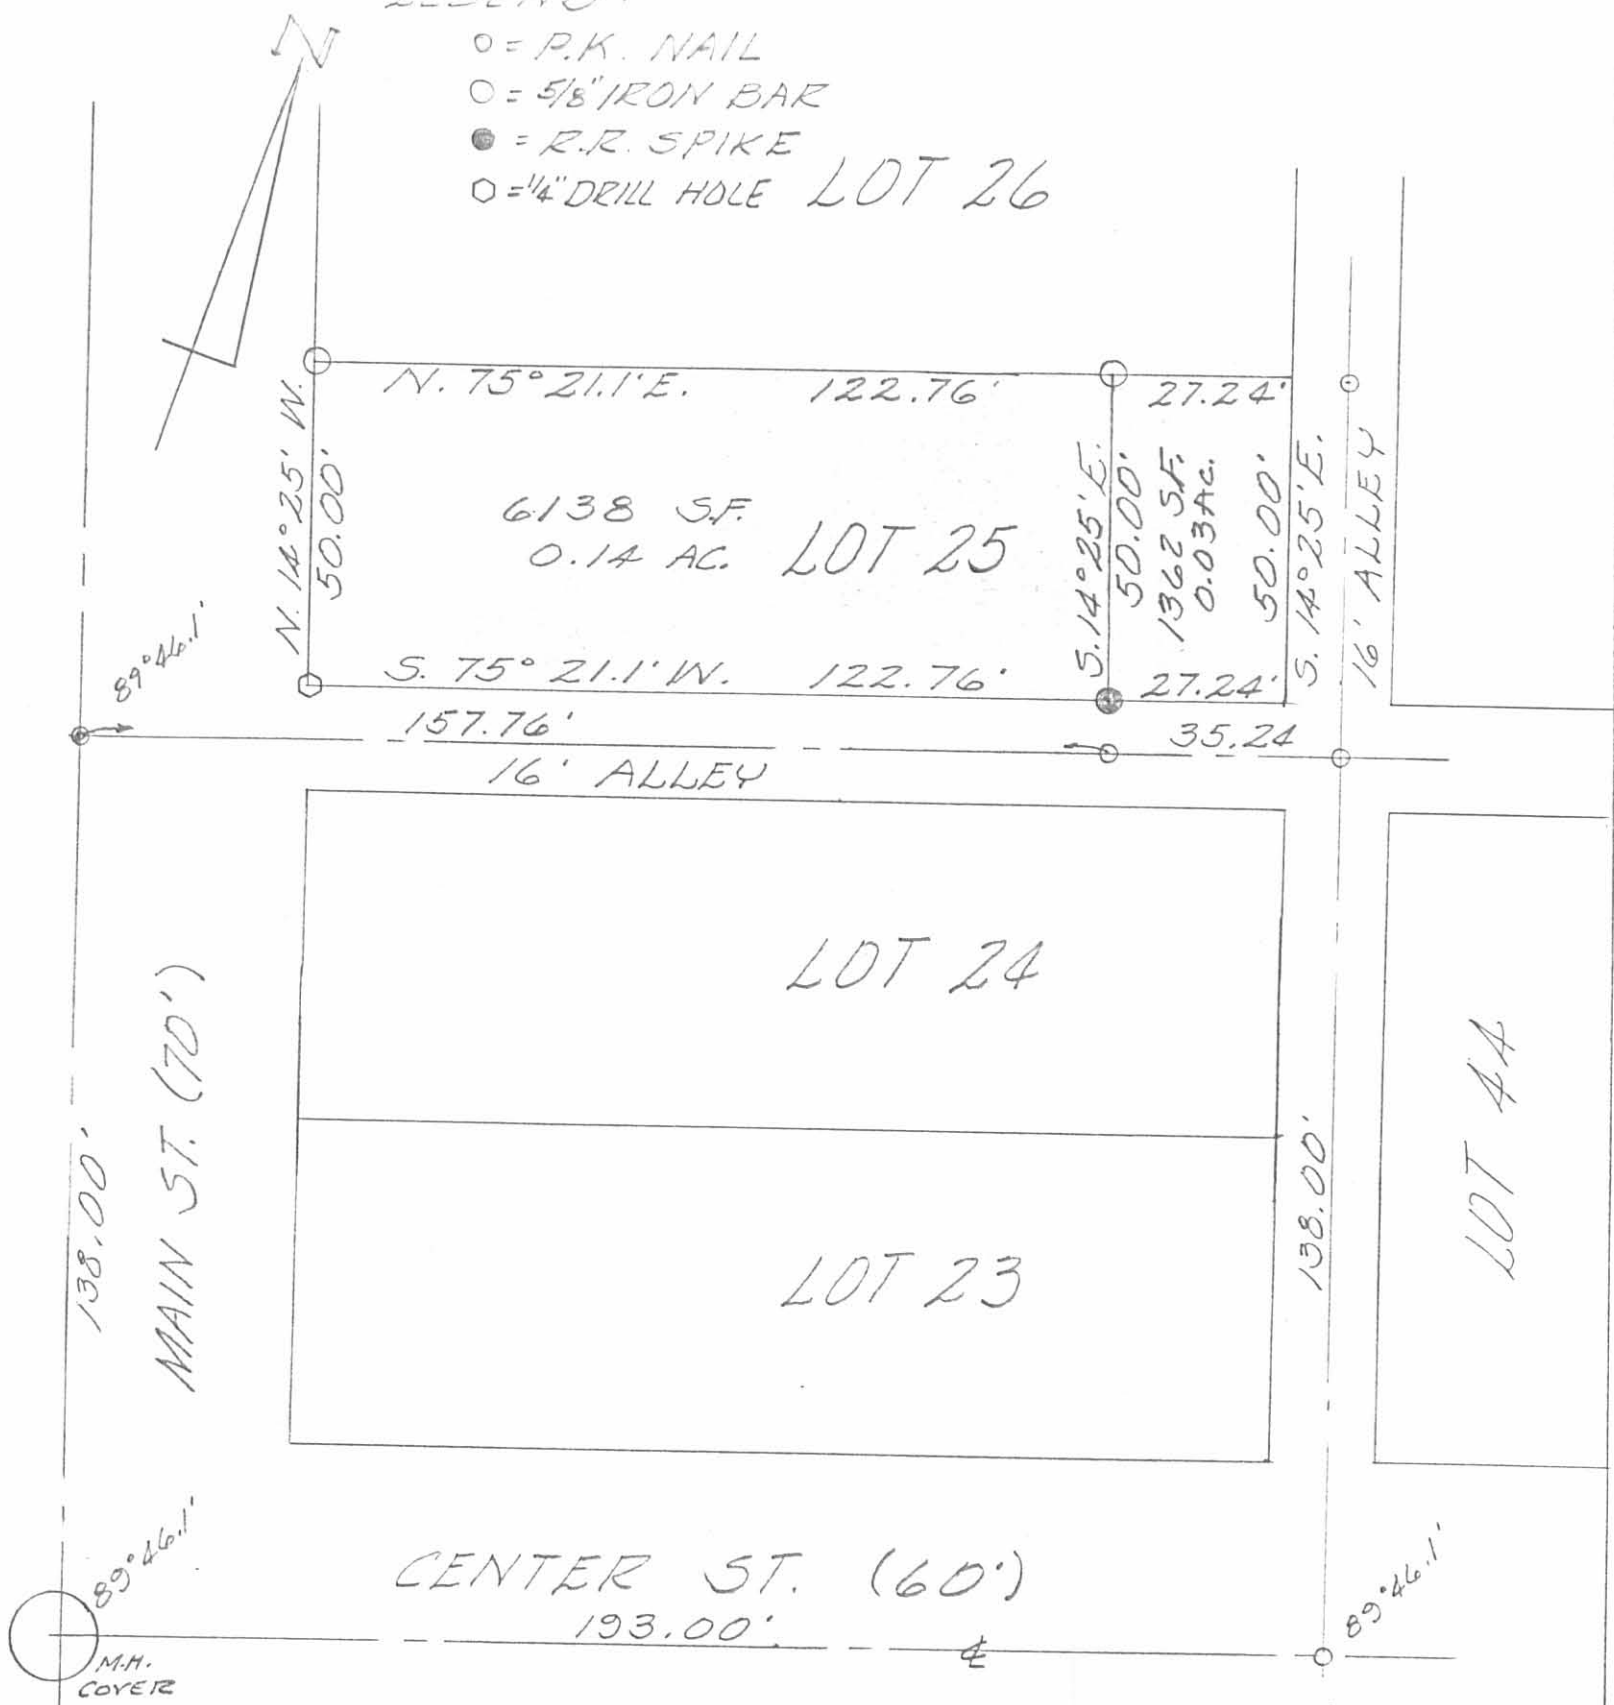

SURVEY OF LOT 25 IN
 THE VILLAGE OF WEST
 MANSFIELD, OHIO
 APRIL, 1981
 SCALE: 1"=30'

6612 IP

INDEXED ON MAP



LESLIE H. GEESLIN
 RUSHSVLVANIA, OHIO