



REC'D 10-9-96 sur

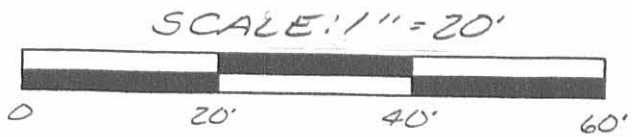

LEGEND:
 O = 5/8 INCH IRON
 BAR SET


SURVEY OF LOT 148 OF HOMESTEAD
 ALLOTMENT ADDITION IN THE VILLAGE
 OF WEST MANSFIELD, BOKESCREEK
 TOWNSHIP, LOGAN COUNTY, OHIO FOR
 DAVID FRASIER ON
 OCTOBER 9, 1996

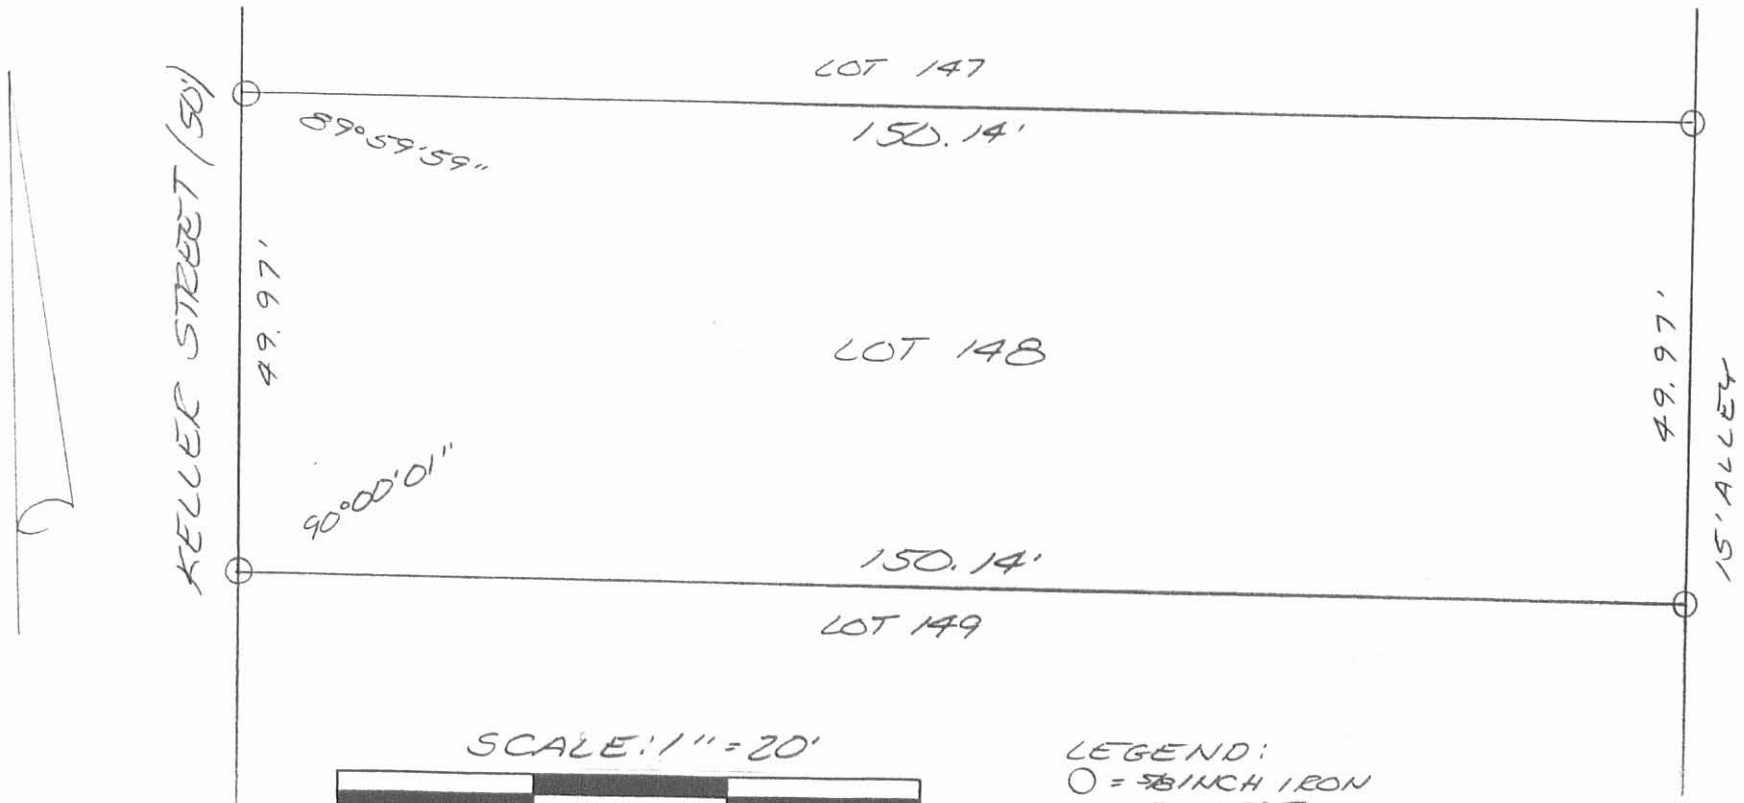

Leslie H. Geeslin
 LESLIE H. GEESLIN
 EUSHYLVANIA, O
 (513) 468-2793

INDEXED ON MAP
 7244 1P

JLB

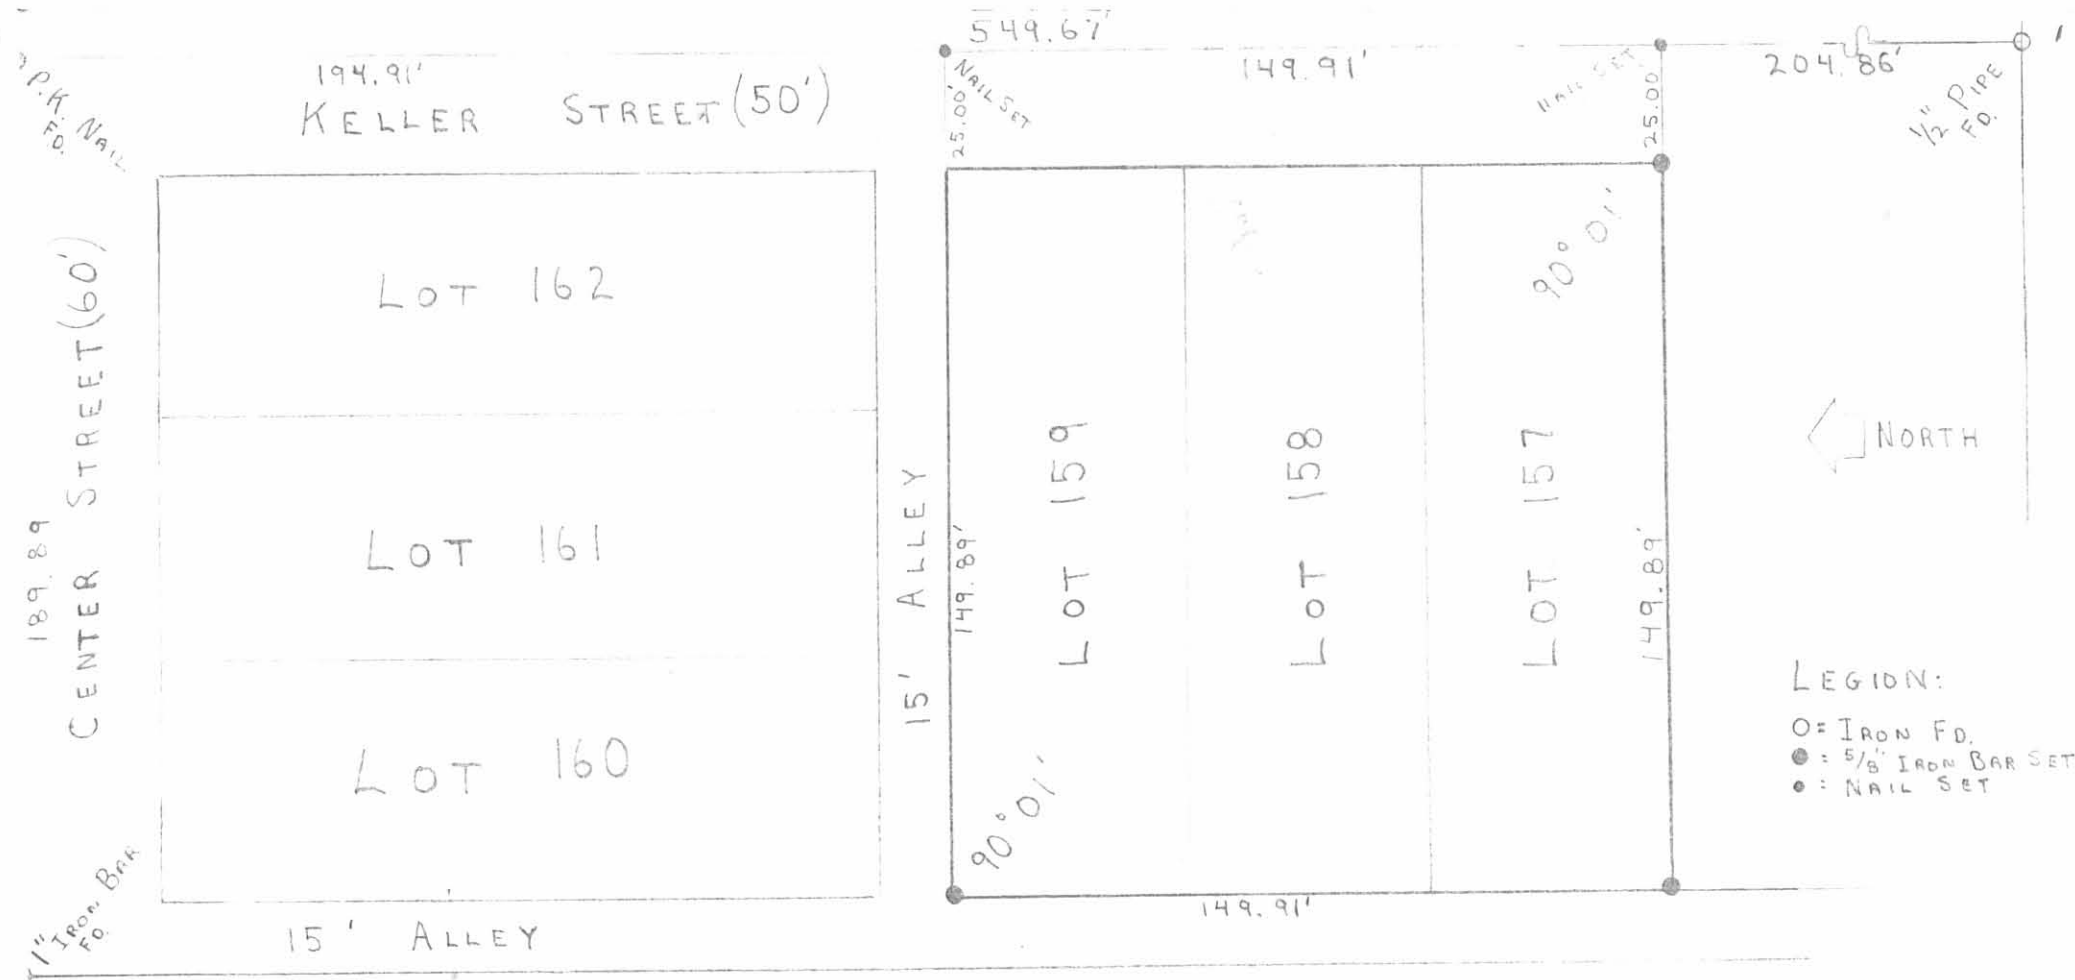

INDEXED ON MAP
7244 2P

SURVEY OF LOTS 157, 158, + 159
 HOME STEAD ALLOTMENT ADDITION
 TO WEST MANSFIELD, OHIO
 JUNE, 1986
 SCALE 1" = 40'
 LOGAN Co.
 BOKESCREEK TWP.

Leslie H. Geeslin
 LESLIE H. GEESLIN
 RUSHVILLE, OHIO

DRAWN BY: D.L.G.