


This road is now S.R. 559  
E.C.P. 10-7-87

Road 159  
zone Twp.  
(Fence stakes for Blackwell)

( Sec Book 596 Page 44 )  
( " " 599 " 43 )

INDEXED ON MAP

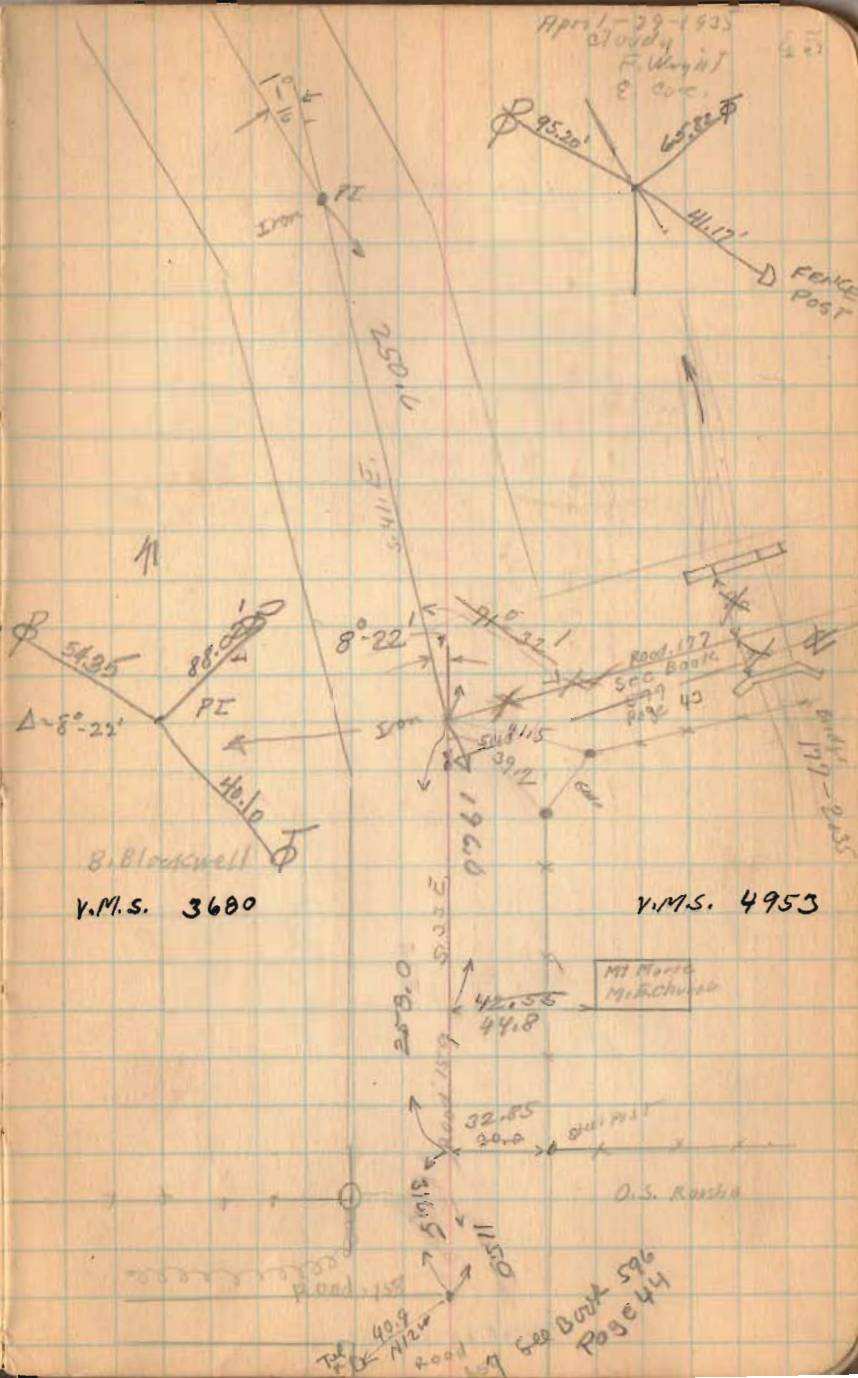

Road 159

4-26-35  
Rain

46

J. Stibishan

J. H. Bishop

New 8' x 10' post

52.50  
Hub.

37.90

Wood post in ground

B. Blackwell

B. Blackwell

11 story  
Frame

41.40

12" x 14" post

10' x 10' post

DRIVE

1654

INDEXED ON MAP