

April 1926

Pt. Lot #13 Zanesfield.

The following described land in Zanesfield, Logan County, Ohio and being part of Original Lot #13.

Beginning at a stake at the intersection of the North side of Columbus St. (Columbus St. being 60 feet wide) and the East side of Sandusky St. (Sandusky St. being 60 feet wide) said stake being also on the S.W. corner of Original Lot #13; thence North with the East side of Sandusky St. 54 feet to a point; thence East passing along the North side of a brick house (and also following a fence) 160 feet to a point in the South side of Cherry Alley; thence South along the West side of Cherry Alley 29.75 feet to a stake, said stake being the S.E. corner of Original Lot #13, thence with the North side of Columbus St. to the place of beginning.

A Survey of the above described ground having been made by F.F. Wright on April 17, 1926 and being shown in Surveyor's Field Book # 403 - Page 38.

(589) ID-1

INDEXED ON MAP

Lot #13 Zanesfield

The following described land in the Village of Zanesfield, County of Logan and State of Ohio and being part of Original Lot No. 13:-

Beginning at a stake on the East side of Sandusky St. (Sandusky St. being a 60' St.), said stake being 45'-0" North from the S.W. corner of Lot No.13; thence North with the East side of Sandusky St. 8' - 10"; thence East passing along the North side of a brick house 160' to the West side of Cherry Alley, thence South 7'-4" to a stake, said stake being 23'-0" North from the S.E. corner of Lot No.13, thence West 160' to the place of beginning.

A Survey of the above land having been made by F.F.Wright on April 17, 1926 and being shown in Surveyor's Field Book #403, Page 38.

(589) 1D-2

INDEXED ON MAP

Polk Survey

Zanesfield Lots.

See Notes on Page 36 of This Book
for lots as per original Plat

Note that this survey was made to
establish lot lines as per deeds

A	Same as A on Page	36
B	" B "	"
C	" C "	"
D	" D "	"
E	" E "	"
F	Hab. Placed by Wright Also Chisel mark on wall	
G	" "	"
H	" "	"
I	Hab. Placed by Wright	
J	" "	"
K	" "	"

Measured south from E 74° 6" and placed F 74° 6"
" " F 90° K 55° 6" " G 90° J
" " G 45° 0" " H.
" " J 23° 0" " I

All lots 160' deep.


Lot line F K Apparently ok.

Lot line G J Pised through brick
house as shown

(Continued on Page 39)

April 17-1926
Cloudy - Cool
Wright
Mr. Polk
Billy Wright

38

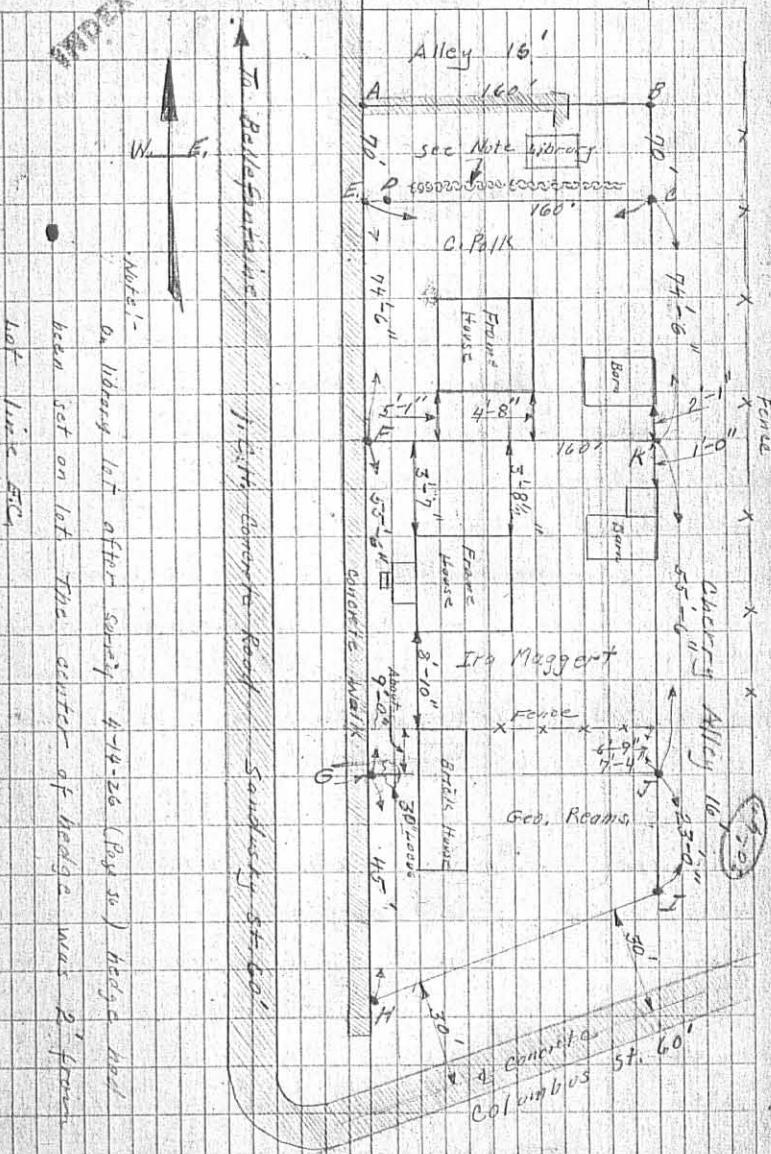

~~Polk Surrey Zanesfield Lots.~~

See Notes on Page 30 of this Book
for lots as per original Plat

Note that this survey was made to establish lot lines as per deeds.

	Some	as	A.	on	Page	36
B	"	"	B	"	"	
C	"	"	C	"	"	
D	"	"	D	"	"	
E	"	"	E	"	"	
F	Hub Placed by Wright Also Chiseled					
G	"	"	"	"	"	
H	"	"	"	"	"	
I	Hub Placed by Wright					
J	"	"	"	"	"	
K	"	"	"	"	"	

Measured south from E⁹⁰W^c 74°6' and placed F⁹⁰K.

" " " F⁹ W/K 55-6 " " " G⁹ W/J

11 - 16 " G 45'-0" " " H.

11 " 23° 0' " " I

All lots 160' Deep.

~~Lat line FK apparently OK.~~

Let wire GJ pass through brick house as shown.


(Continued on Page 39)

589

589

April 17-1926
Cloudy - Cool
Wright
Mr. Polk
Billy Wright

38

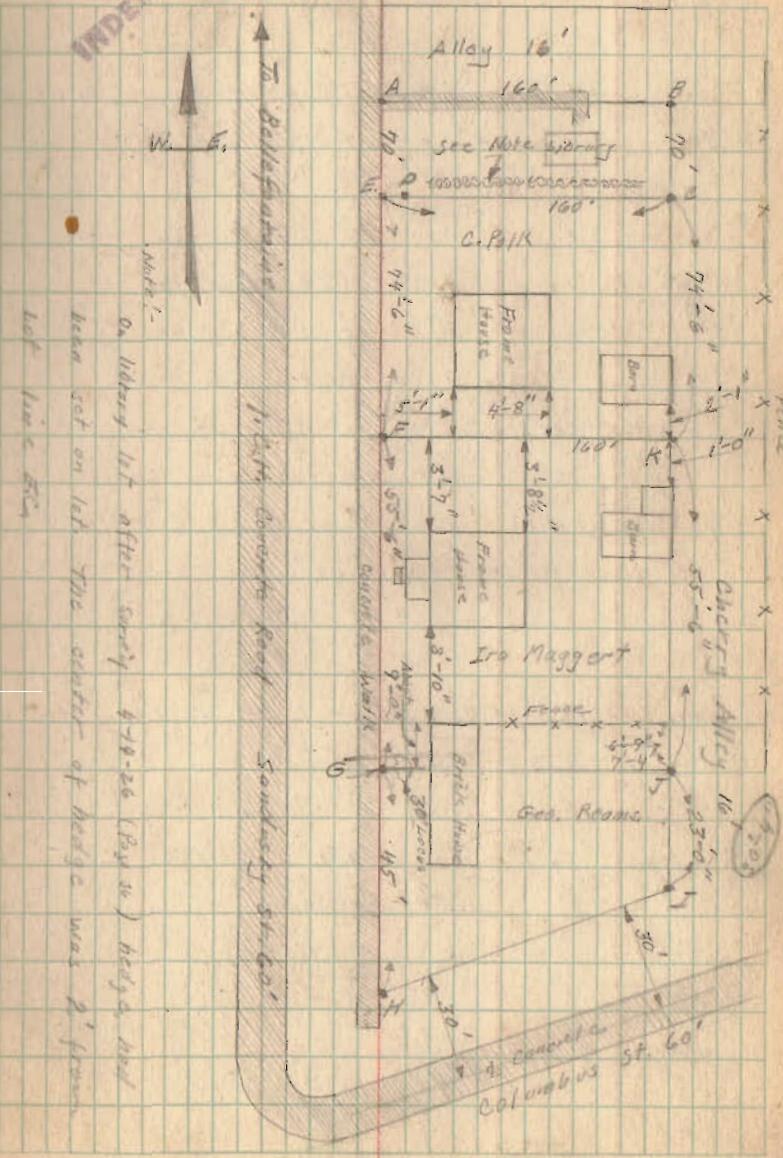

Polk Survey (Continued)

Geo Reams Deed Vol. 118 Page 206
South half of lot 13 (No distinct
given)

Ira Maggert Vol. 128 Page 171.
 $55\frac{1}{2}$ of N. $\frac{1}{2}$ of lot 13 being
60' off the N. Part of lot 13
except 4 $\frac{1}{2}$ ' on N. side of said lot.
(Note that this is as staked
 $4\frac{1}{2}$ off of #13 now being with lot 12
60' off of the original lot
would leave 45' for Reams)

Taylor To Thorton Vol. 44 Page 81
4 $\frac{1}{2}$ by 160'

Chas Polk Vol. 124 Page 265