

Main St. Zanesfield

4428

INDEXED ON MAR



Jan. 16, 1934
Clear - cold wind
Wing Mt 10
Ed. Corf

x 97x15

St.

7+99

Church
steps

7+851

Alley

7+721

5+5915

Alley

5+456

4+2275

Alley

x x x

4+12.0

x 0+72.7

$\frac{1}{2}$
x
 $\frac{1}{2}$

82.0+00

Buy
100.00

Walk

Columbus St.

Walk

5+24

Walk


Main St. Zounefield



176-34

11

14+24 present ~~to~~ Bellefontaine St

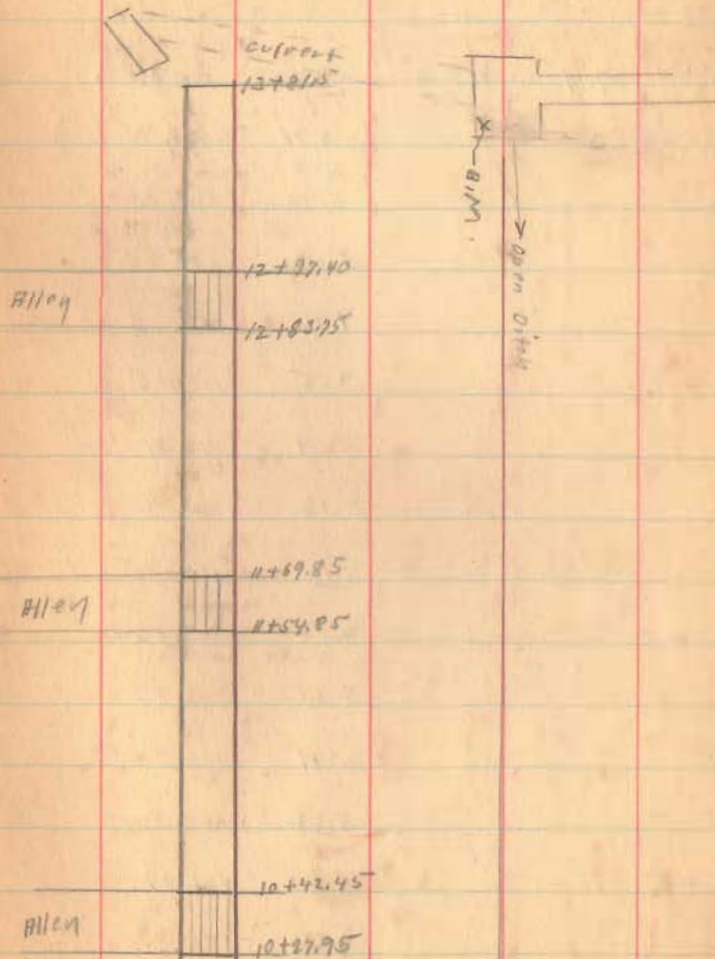

Columbus St.


Zanesfield,

S.H. 235

Route 32

To Columbus

1-16-34
17

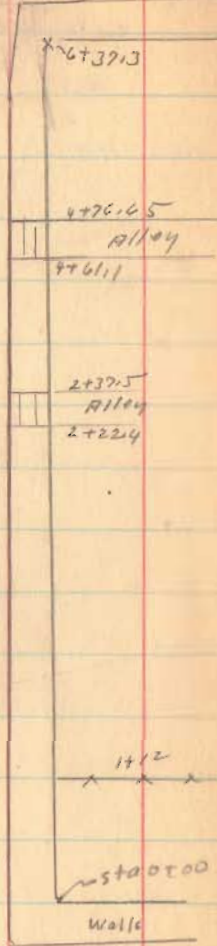

Main St.

Bellefontaine St. Eastfield


176-34

21

Sta 235
Route 52

6+53

472565
12/04
476961

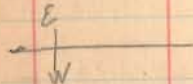

2+427
12/04
2+22

0+00

0+00
12/11

Main St