


SANDUSKY STREET

RUSH STREET

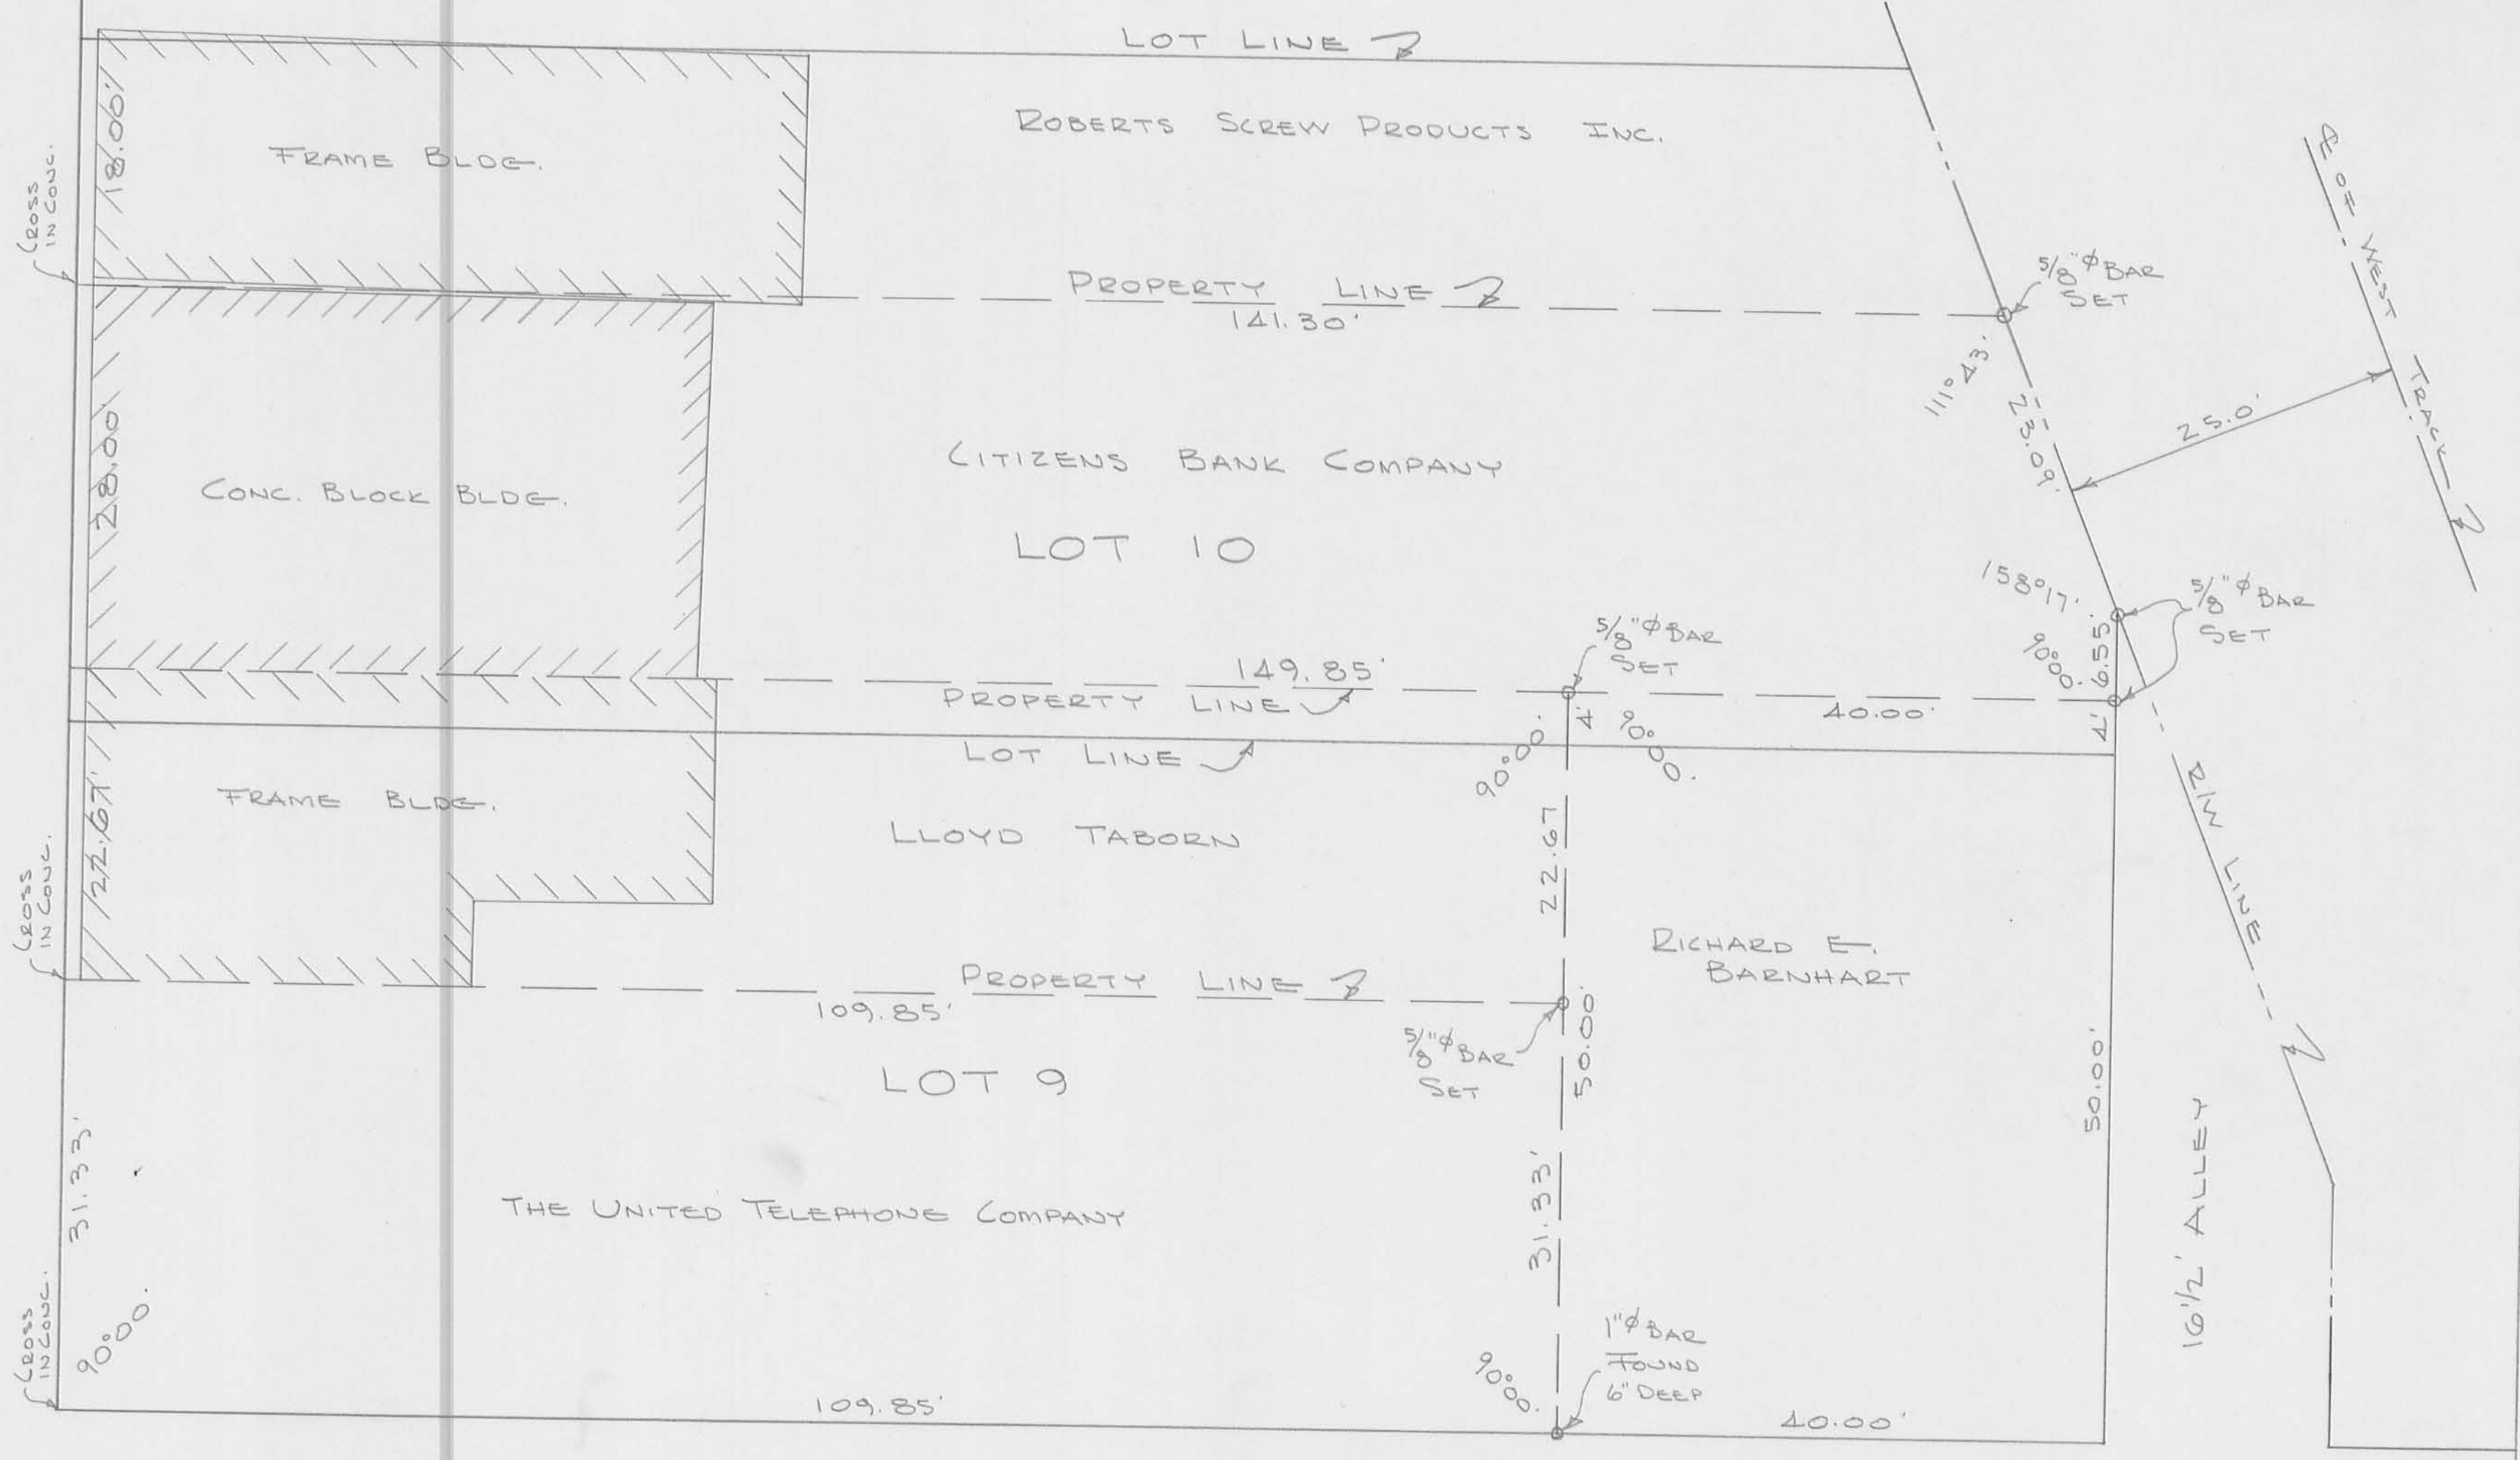

SURVEY OF PT. LOTS 9 & 10
 RUSHSYLVANIA, OHIO
 FOR
 THE LOGAN COUNTY BANK
 JUNE 19, 1971
 SCALE 1" = 10'

DAN L. DODSON
 REG. SURVEYOR 4270
 BELLEFONTAINE, OHIO