


N. MAIN ST.

N. OPERA ST. 16'

ALLEY 16'

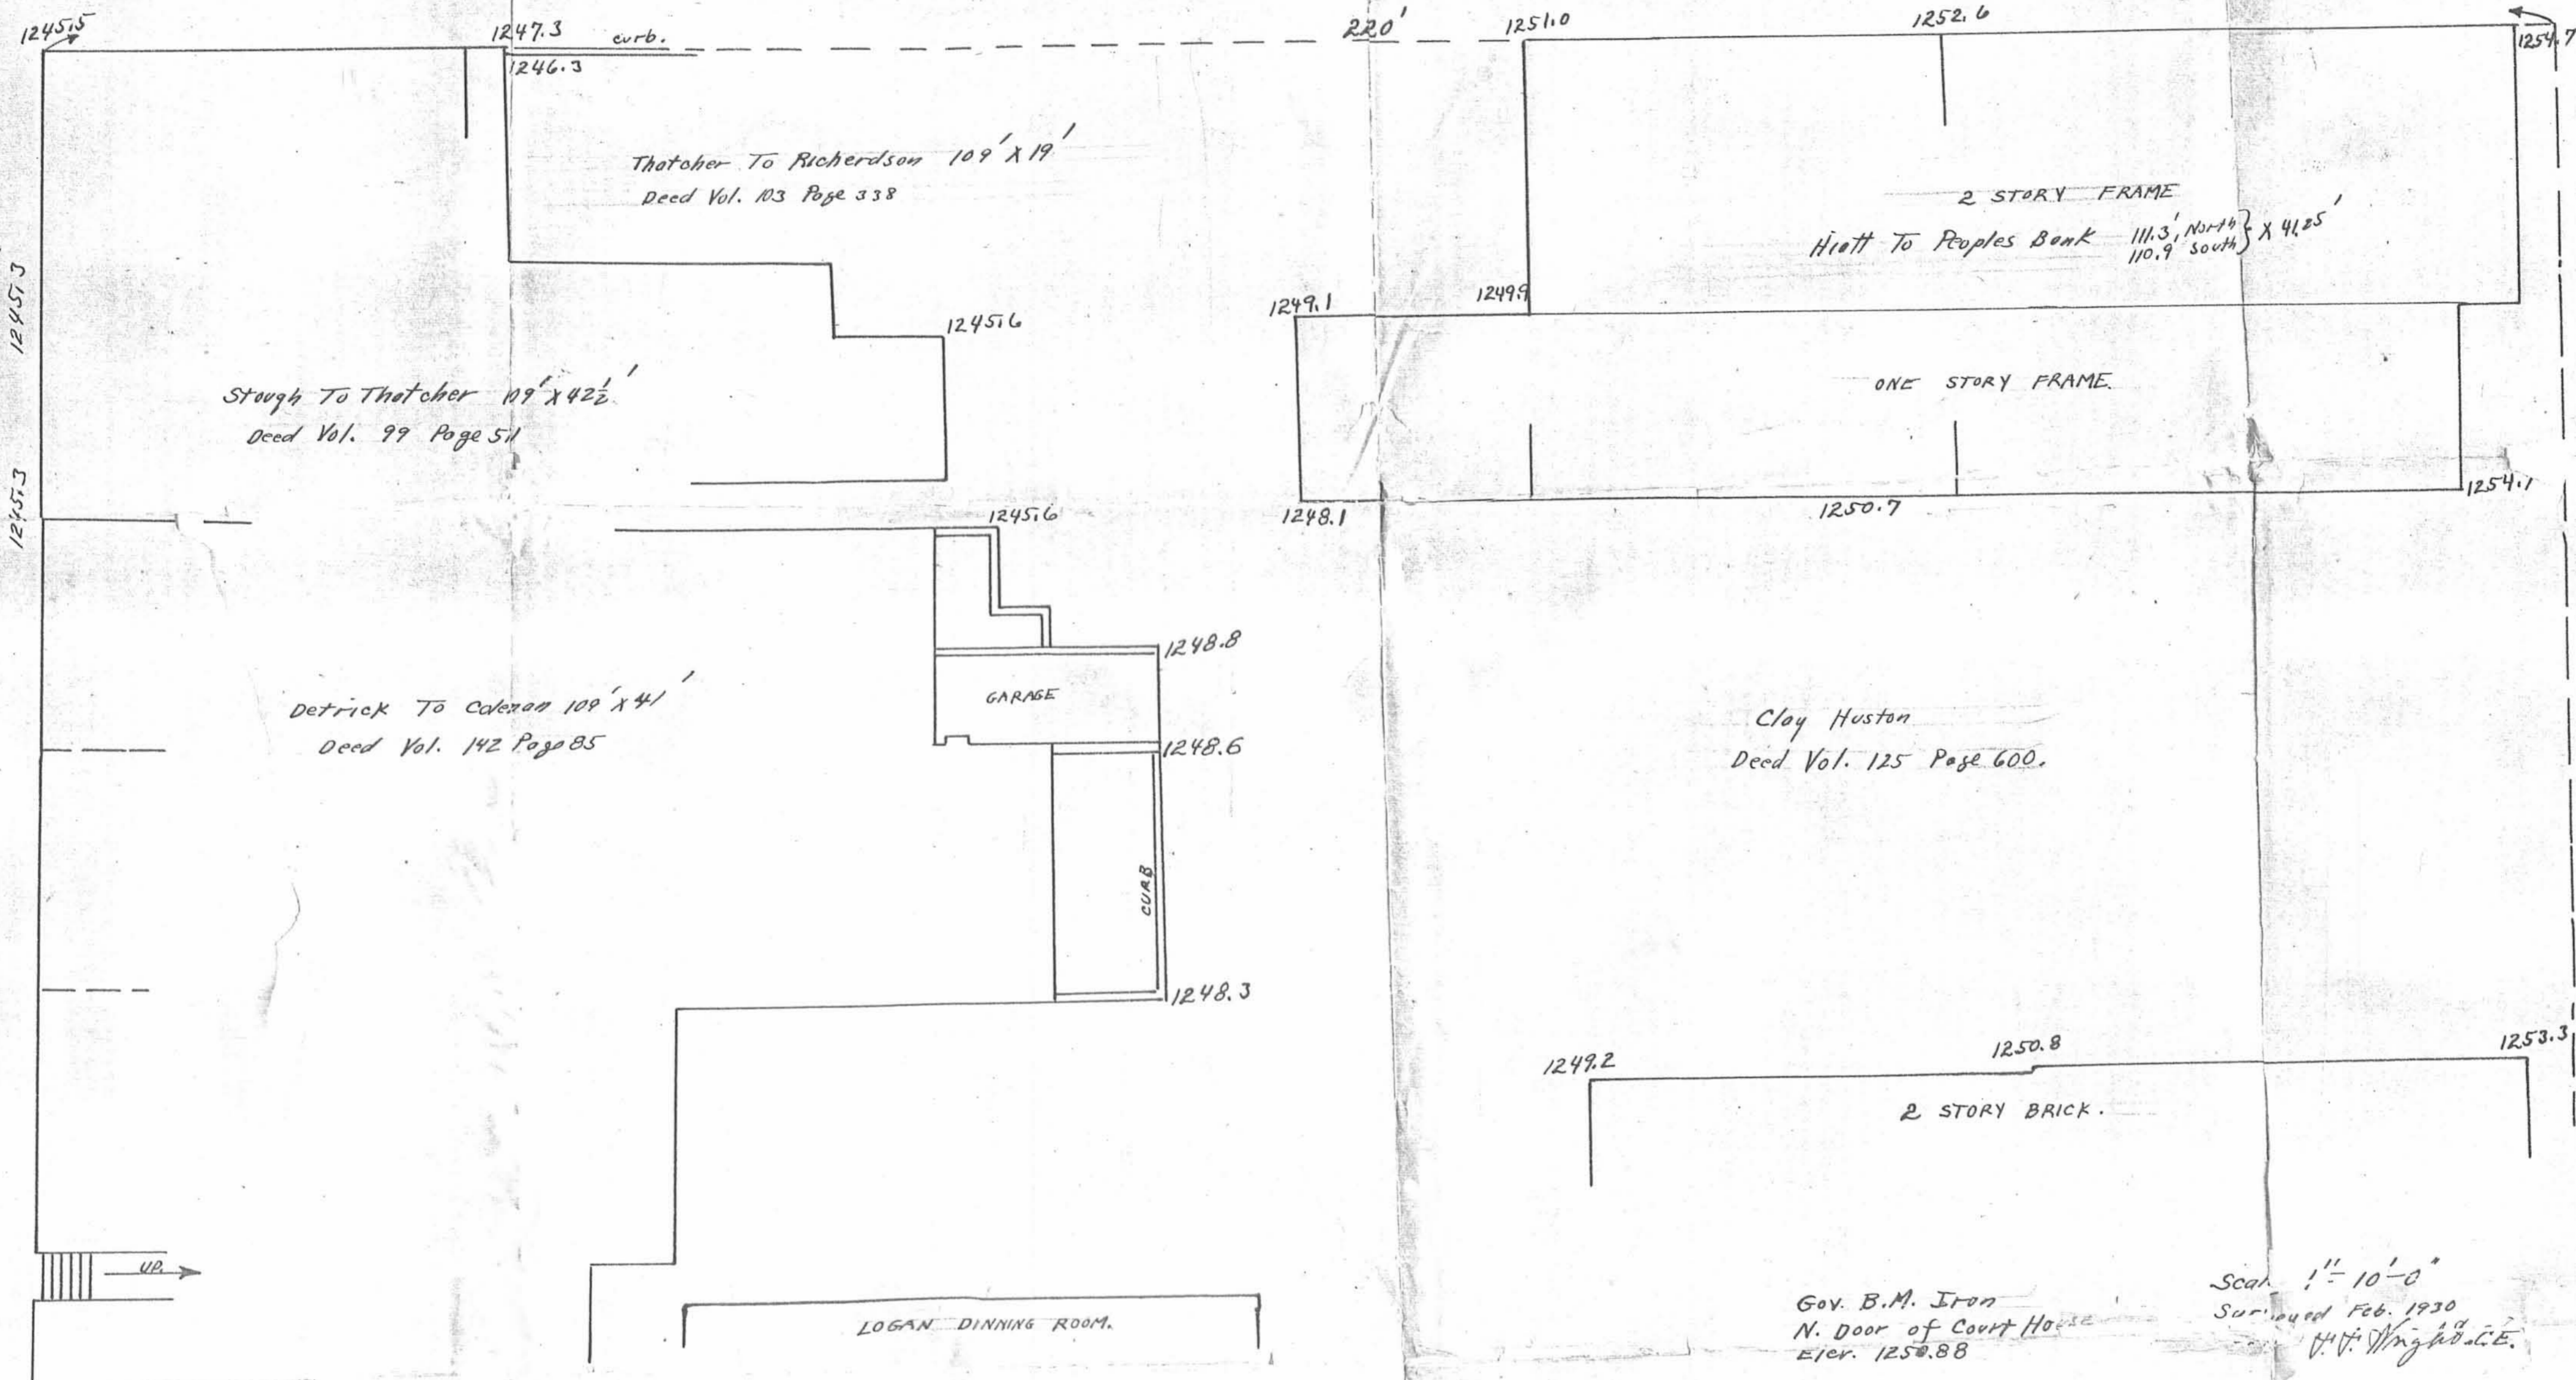

SURVEY LOT 137  
 BELLEFONTAINE  
 1930

Scale 1" = 10'-0"  
 Surveyed Feb. 1930  
 H. V. Wingard C.E.

1207