

Note:
 5/8" x 30" Rebar Fd. Bent.
 Set 5/8" x 30" Rebar (Capped).

Joyce K. Wynegar et al
 O.R. No. 18 P. 367 (4-23-1986)
 2.29 Acres




Scale: 1" = 100'

SYMBOLS:

- - R. R. Spikes Set.
- - 5/8" x 30" Rebars Set.
- ▣ - 2" Iron Bolt in a Monument Box Fd.

Charles R. Mouser et ux
 D. Vol. No. 288 P. 383 (6-7-1963)
 05-042-00-00-007.000

- 101.000 Acres
 - 2.356 Acres Surveyed
 - 98.644 Acres Remaining

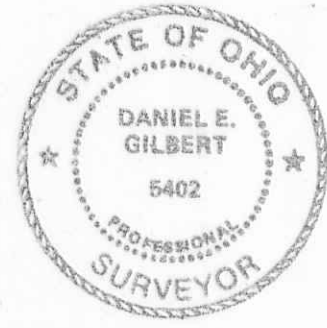

MOUSER SURVEY V. M. S. No. 9915, Bokescreek Township, Logan County, Ohio.		
SCALE: 1" = 100'	APPROVED BY:	DRAWN BY: DEG
DATE: 12-3-2003		REVISED:
<i>Daniel E. Gilbert</i> Daniel E. Gilbert, P.S. Reg. Sur. No. 5402		DRAWING NUMBER 2003-025

INDEXED ON MAP
 9461

S-389