



CHANNEL

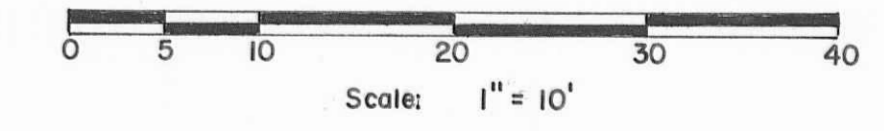

REFERENCE:  
MIDLAKE SUBDIVISION No. 2  
Plat Cab. A, Slide 327 (1-23-1956).

SYMBOLS:  
○ - Magnetic P.K. Nails Set.  
○ - 5/8" Rebar Fd.  
● - 5/8" x 30" Rebars Set.

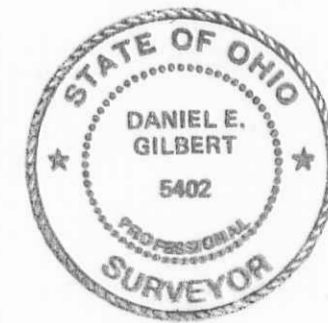

Survey of Lot No. 36 - Midlake Subdivision No. 2,  
V.M.S. No. 12276, Tecumseh Island,  
Stokes Township, Logan County, Ohio.

SCALE: 1" = 10'	APPROVED BY:	DRAWN BY: DEG
DATE: 10-18-2003		REVISED:

*Daniel E. Gilbert*  
Daniel E. Gilbert, P.S.  
Reg. Sur. No. 5402

DRAWING NUMBER: 2003-020