

SURVEYOR'S CERTIFICATE:

I hereby certify to CITIZENS FEDERAL SAVINGS AND LOAN CO., that on March 14, 2003, that I did personally locate the structures and improvements as shown on this plat and that there are no physical encroachments thereon.

Daniel E. Gilbert, P.S.

Daniel E. Gilbert, P.S.
Reg. Sur. No. 5402
513 N. Madriver St.
Bellefontaine, Ohio 43311

William Herbert Cronkleton
O. R. No. 33 P. 87 (12-5-1986)
05-027-00-00-036.000
Parcel I, Tract No. 1
30.70 Acres


05-041-00-00-002.000
Parcel I, Tract No. 2
10.93 Acres

Total Area - 42,138.725^{sq} ft or 0.967 Acres

24,298.860^{sq} ft or 0.556 Acres
05-041-00-00-004.000

17,920.000^{sq} ft or 0.411 Acres
05-041-00-00-005.000

05-041-00-00-003.000
Parcel I, Tract No. 2
10.93 Acres

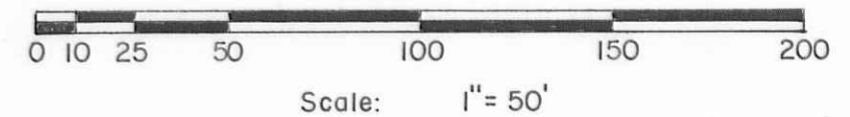

SYMBOLS:

- - P. K. Nails Fd.
- - 5/8" x 30" Rebars Fd.
- ⊙ - 3/4" Iron Pipes Fd.

REFERENCE:

Gordon B. McGinnis - O. R. No. 178 P. 62-63 (12-11-1992).

Mortgage Inspection Survey of Gordon B. McGinnis' present 0.97 Acre tract, V.M.S. No. 9938 and 10060, Bokescreek Township, Logan County, Ohio.

SCALE: 1" = 50'	APPROVED BY:	DRAWN BY: DEG
DATE: 3-14-2003		REVISED:

Daniel E. Gilbert
Daniel E. Gilbert, P.S.
Reg. Sur. No. 5402

DRAWING NUMBER
2002-030A



INDEXED ON MAP
2771

S-404

S. R. No. 292

N. 12° 18' 00" E.
Basis of Bearing
128.10'

60' (See Plan X-19 Sheet 6)

N. 12° 18' 00" E. 702.00' to 5/8" Rebar found at intersection of the centerlines of C.H. No. 117 (Early Pike) and S. R. No. 292.

3,848.720^{sq} ft or 0.088 Acres

R/W. Mon. Fd.
Sta. No. 671+00.00
Plan No. L-55

(See Plan L-55 Sheet 48)

V M S
M S
S NO.

10060
9938

30.97'

31.04'

N. 87°-26'-00" E.

20.0'

287.16'

(140)S

318.20'

S. 2°-34'-00" E.

127.90'

320.13'

(140)S
351.10'

S. 88°-05'-25" W.