


C-1 Curve Data
 $\Delta = 154^{\circ}-35'$
 $T = 30.83'$
 $R = 6.95'$
 Arc Dis. = 18.75'
 Chord Bearing -
 $N. 82^{\circ}-21'-19'' W.$
 Chord Distance -
 13.91'

Reference:
 Nicholson's 1st. Addition (3-25-1925).
 Plat Cab. A Slide 229.
 Lots No. 905, 906, 907 and 908.
 Carolyn Whited
 O. R. No. 394 P. 864 (1-5-1999).



- SYMBOLS:
- ⊙ - 1" Iron Pipe Fd.
 - - 5/8" Rebars Fd.
 - - 5/8" x 30" Rebars Set.

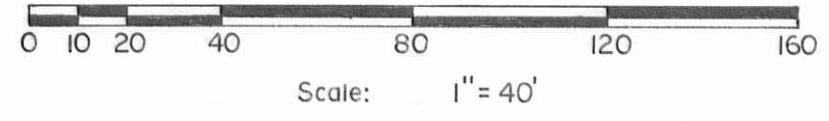

ReSurvey of Lots No. 905, 906, 907 and 908,
 Village of Russells Point, Washington Township,
 Logan County, Ohio.

SCALE: 1" = 40'	APPROVED BY:	DRAWN BY DEG
DATE: 10-19-2000		REVISED
<i>Daniel E. Gilbert</i> Daniel E. Gilbert, P.S. Reg. Sur. No. 5402		DRAWING NUMBER 2000-048

9-454

INDEXED ON MAP
9013