

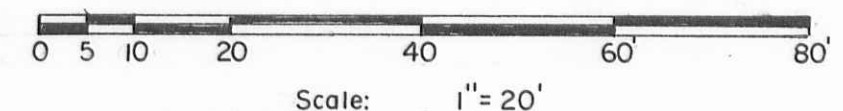


BARNES DRIVE -50'

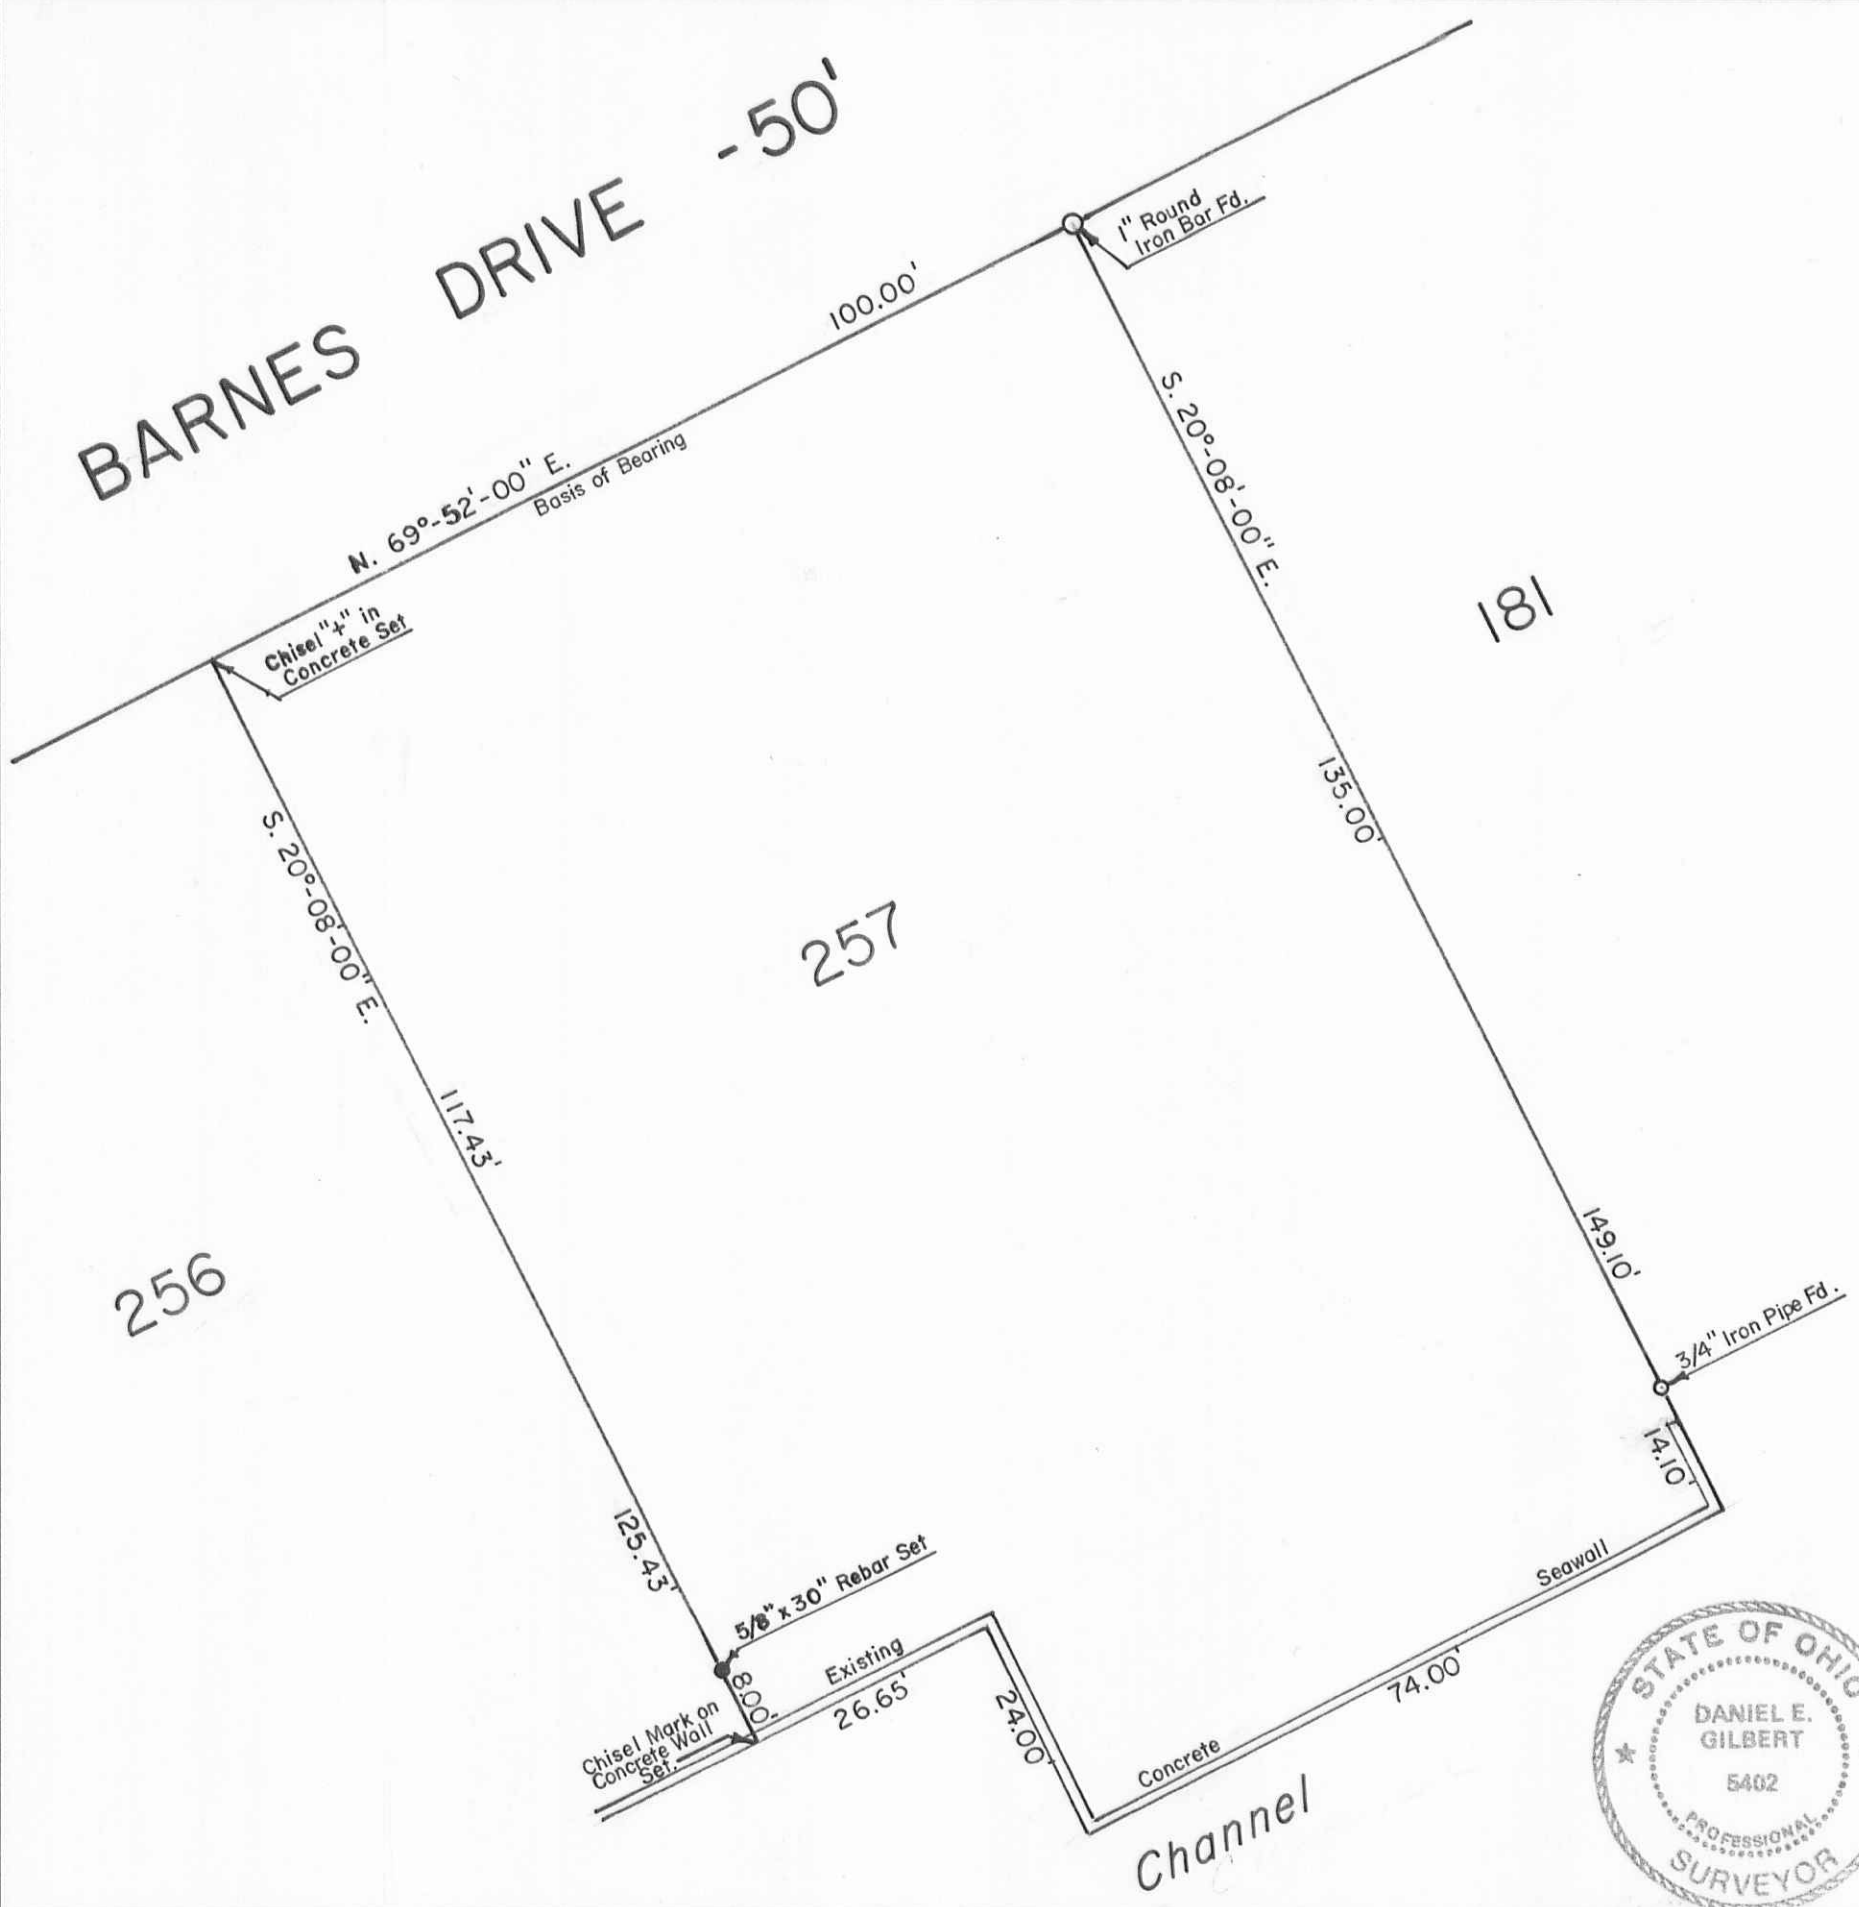

Reference:  
Indian Lake Shores Allotment No. 3  
Plat Cab. A Slide 40I (7-23-1962).

Robert Miller Survey - Lot No. 257 Indian Lake Shores Allotment No. 3 Richland Township, Logan County, Ohio.		
SCALE: 1" = 20'	APPROVED BY:	DRAWN BY DEG
DATE: 9-8-1999		REVISED
<i>Daniel E. Gilbert, P.S.</i> Daniel E. Gilbert, P.S. Reg. Sur. No. 5402		DRAWING NUMBER 099-035

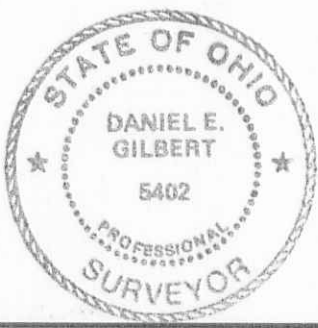

INDEXED ON MAP  
6598

S-487