

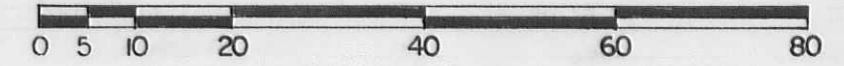


INDIAN LAKE

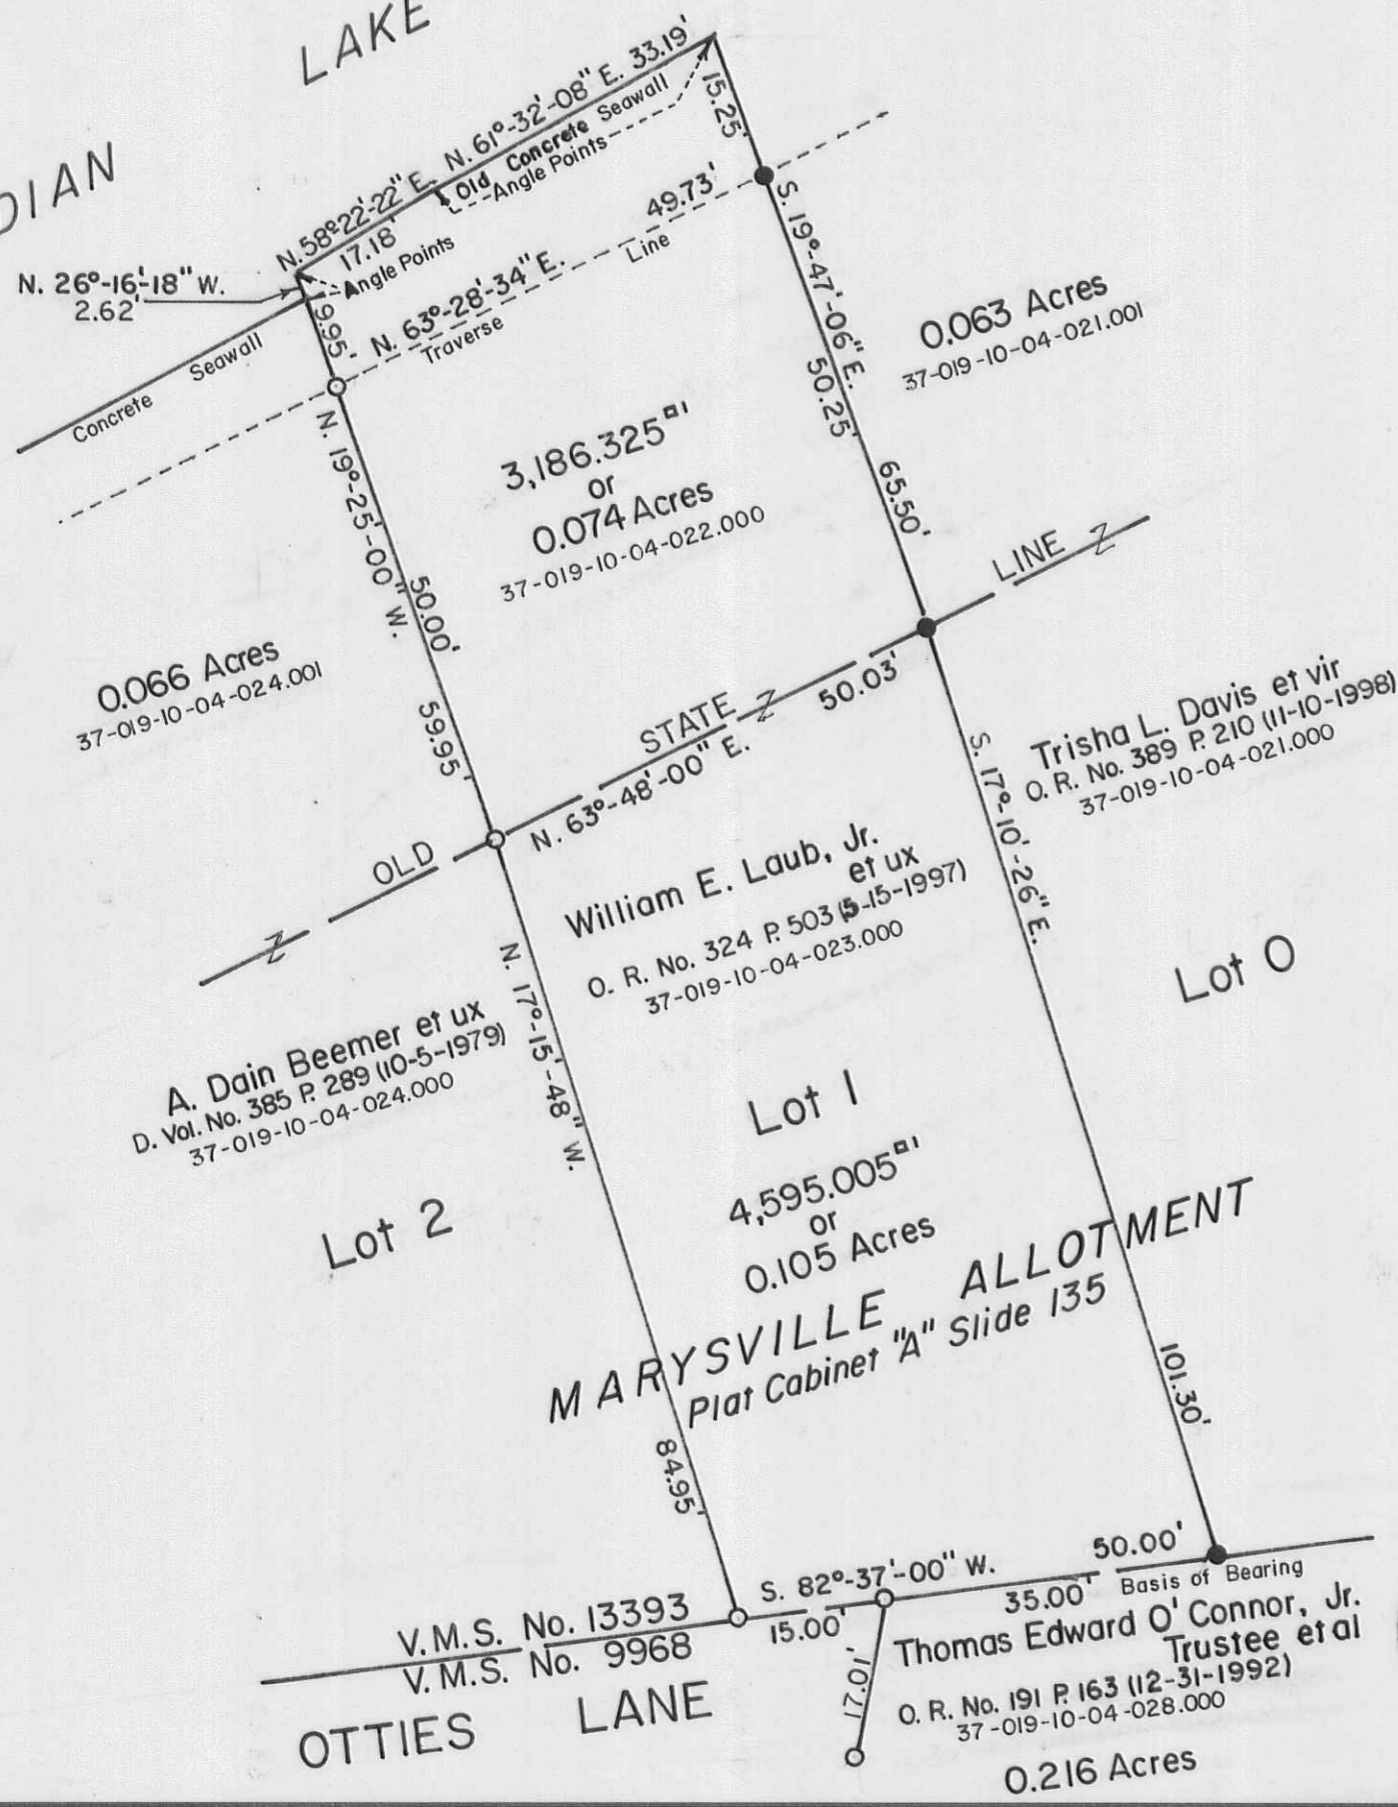

Scale: 1" = 20'

SYMBOLS:  
 ○ - 5/8" Rebars in Concrete Fd.  
 ● - 5/8" x 30" Rebars Set.  
 Reference:  
 The Marysville Allotment  
 Plat Cabinet A, Slide 135

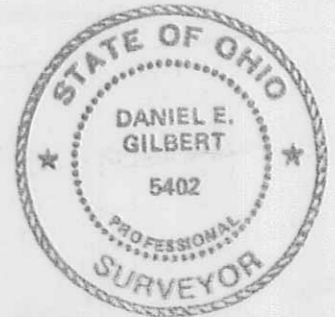

Resurvey of Lot No. 1 plus Extension V.M.S. No. 13393, Marysville Allotment, Richland Township, Logan County, Ohio.		
SCALE: 1" = 20'	APPROVED BY:	DRAWN BY DEG
DATE: 4-26-1999		REVISED
 Daniel E. Gilbert, P.S. Reg. Sur. No. 5402		DRAWING NUMBER 099-010

INDEXED ON MAP  
6217

S-508