


E. BAIRD ST. - 60'

N. 87°-30'-00" E. (Plat) Basis of Bearing

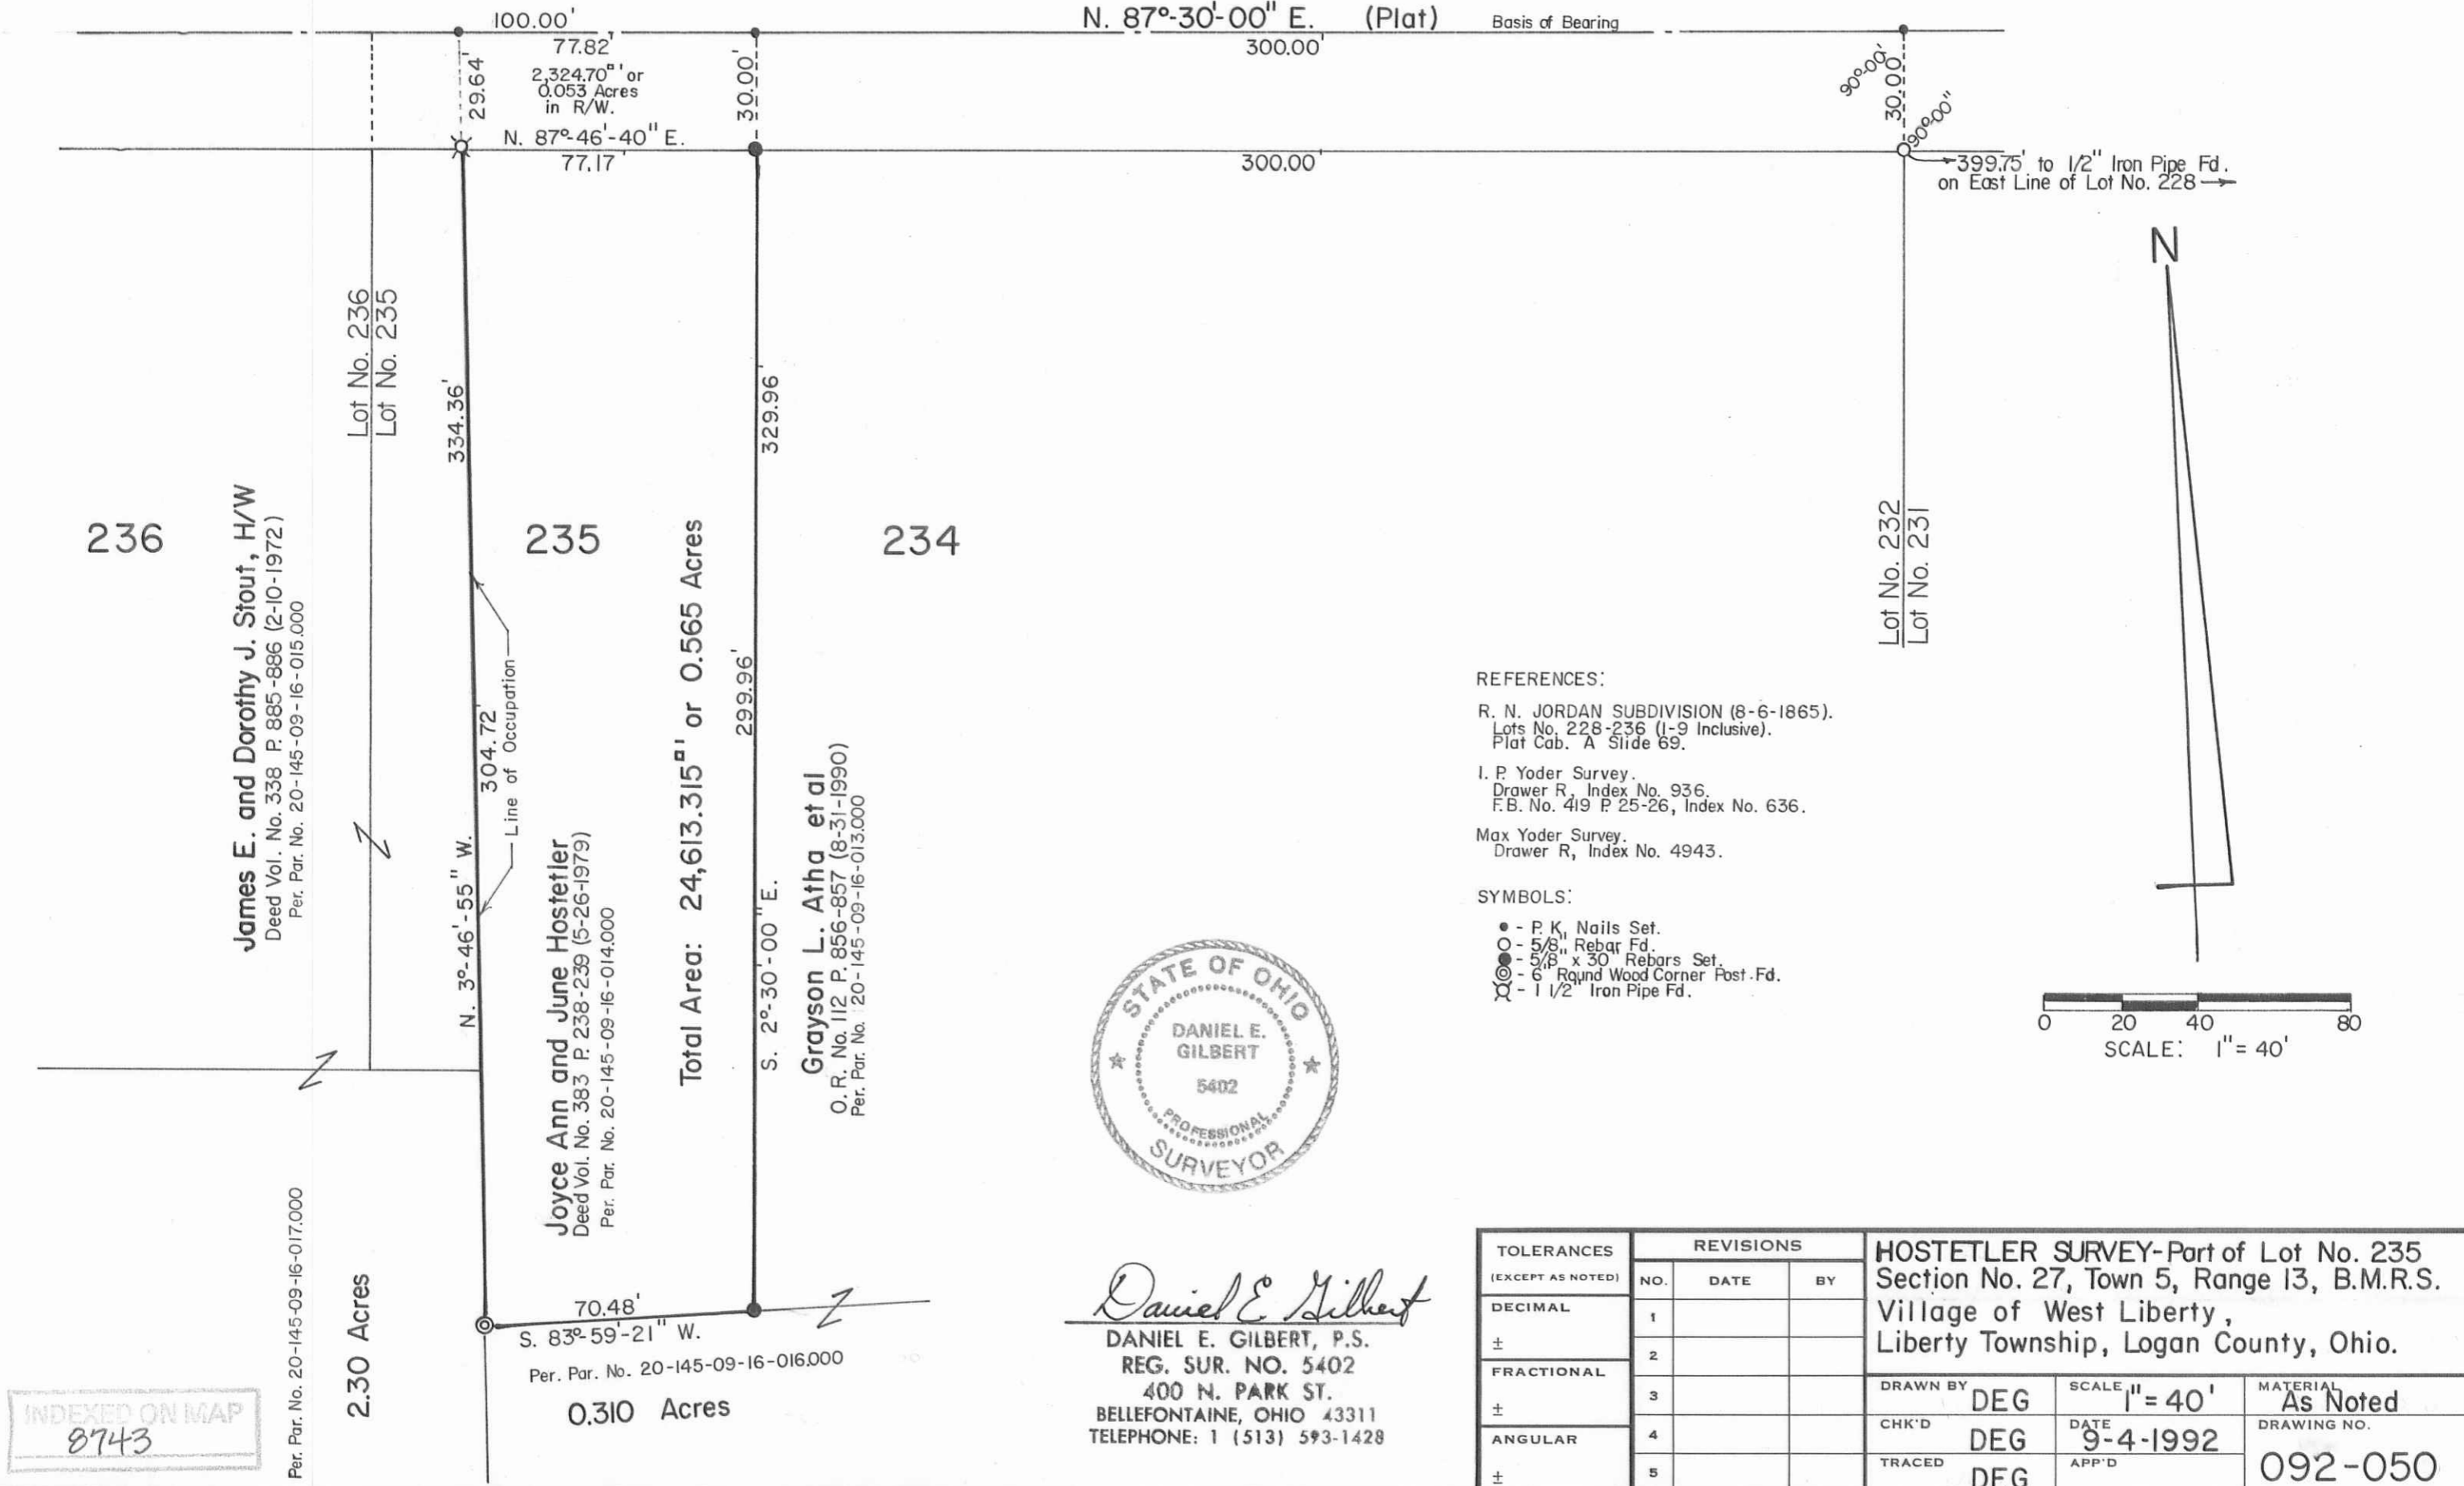

James E. and Dorothy J. Stout, H/W  
Deed Vol. No. 338 P. 885-886 (2-10-1972)  
Per. Par. No. 20-145-09-16-015.000

Joyce Ann and June Hostetler  
Deed Vol. No. 383 P. 238-239 (5-26-1979)  
Per. Par. No. 20-145-09-16-014.000

Grayson L. Atha et al  
O. R. No. 112 P. 856-857 (8-31-1990)  
Per. Par. No. 20-145-09-16-013.000

Total Area: 24,613.315<sup>±</sup> or 0.565 Acres

2.30 Acres

0.310 Acres




*Daniel E. Gilbert*  
DANIEL E. GILBERT, P.S.  
REG. SUR. NO. 5402  
400 N. PARK ST.  
BELLEFONTAINE, OHIO 43311  
TELEPHONE: 1 (513) 593-1428

REFERENCES:

- R. N. JORDAN SUBDIVISION (8-6-1865).  
Lots No. 228-236 (1-9 Inclusive).  
Plat Cab. A Slide 69.
- I. P. Yoder Survey.  
Drawer R, Index No. 936.  
F.B. No. 419 P. 25-26, Index No. 636.
- Max Yoder Survey.  
Drawer R, Index No. 4943.

SYMBOLS:

- - P. K. Nails Set.
- - 5/8" Rebar Fd.
- ⊙ - 5/8" x 30" Rebars Set.
- ⊗ - 6" Round Wood Corner Post-Fd.
- ⊗ - 1 1/2" Iron Pipe Fd.

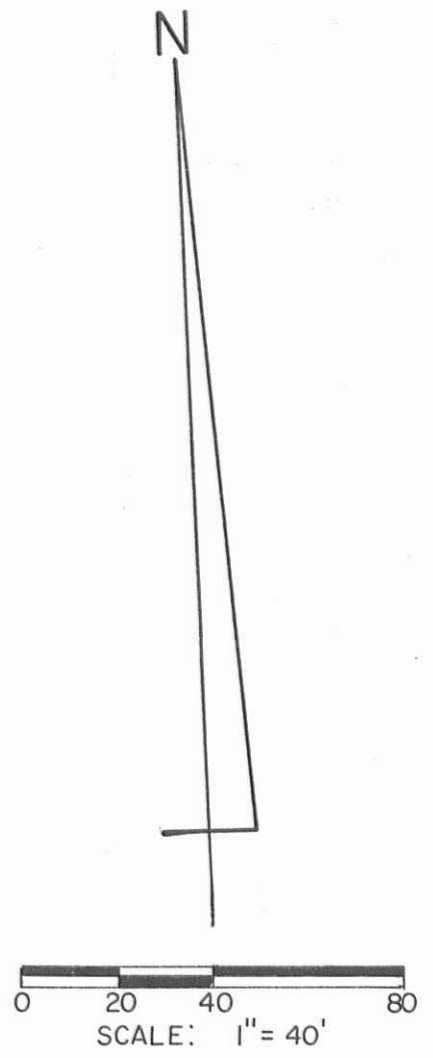

INDEXED ON MAP  
8743

TOLERANCES (EXCEPT AS NOTED)	REVISIONS			HOSTETLER SURVEY-Part of Lot No. 235 Section No. 27, Town 5, Range 13, B.M.R.S. Village of West Liberty, Liberty Township, Logan County, Ohio.
	NO.	DATE	BY	
DECIMAL	1			DRAWN BY DEG SCALE 1" = 40' MATERIAL As Noted
±	2			
FRACTIONAL	3			CHK'D DEG DATE 9-4-1992 DRAWING NO. 092-050
±	4			
ANGULAR	5			TRACED DEG APP'D
±				