
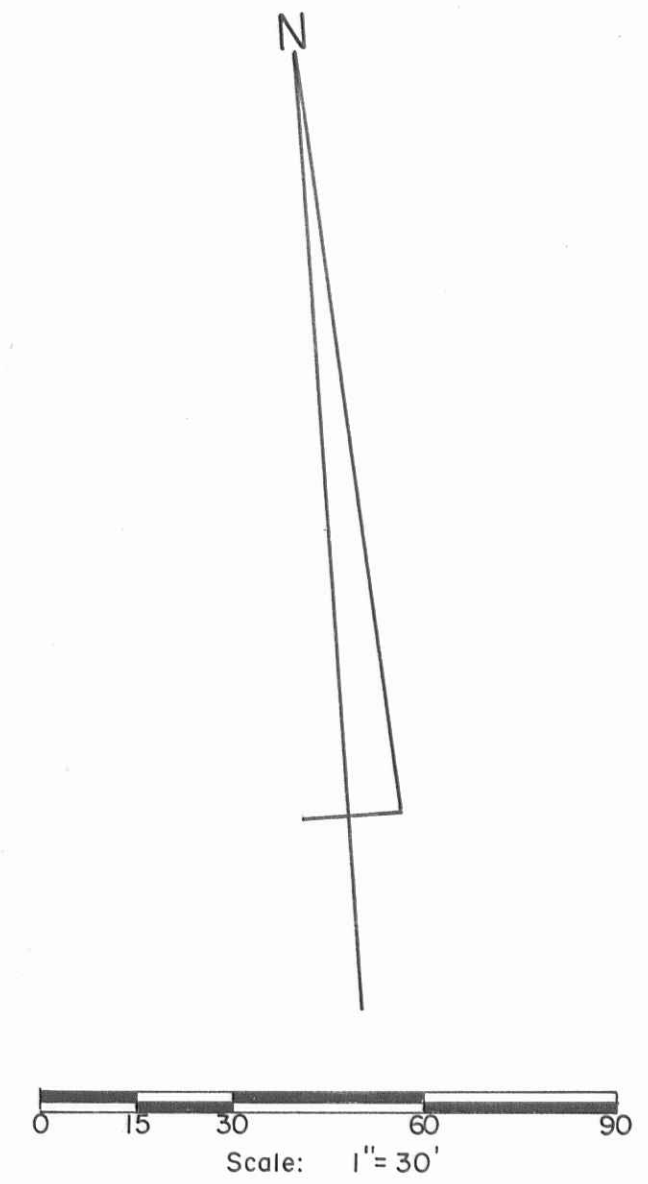


TRACEMORE

Asphalt Road

LANE

- 60'

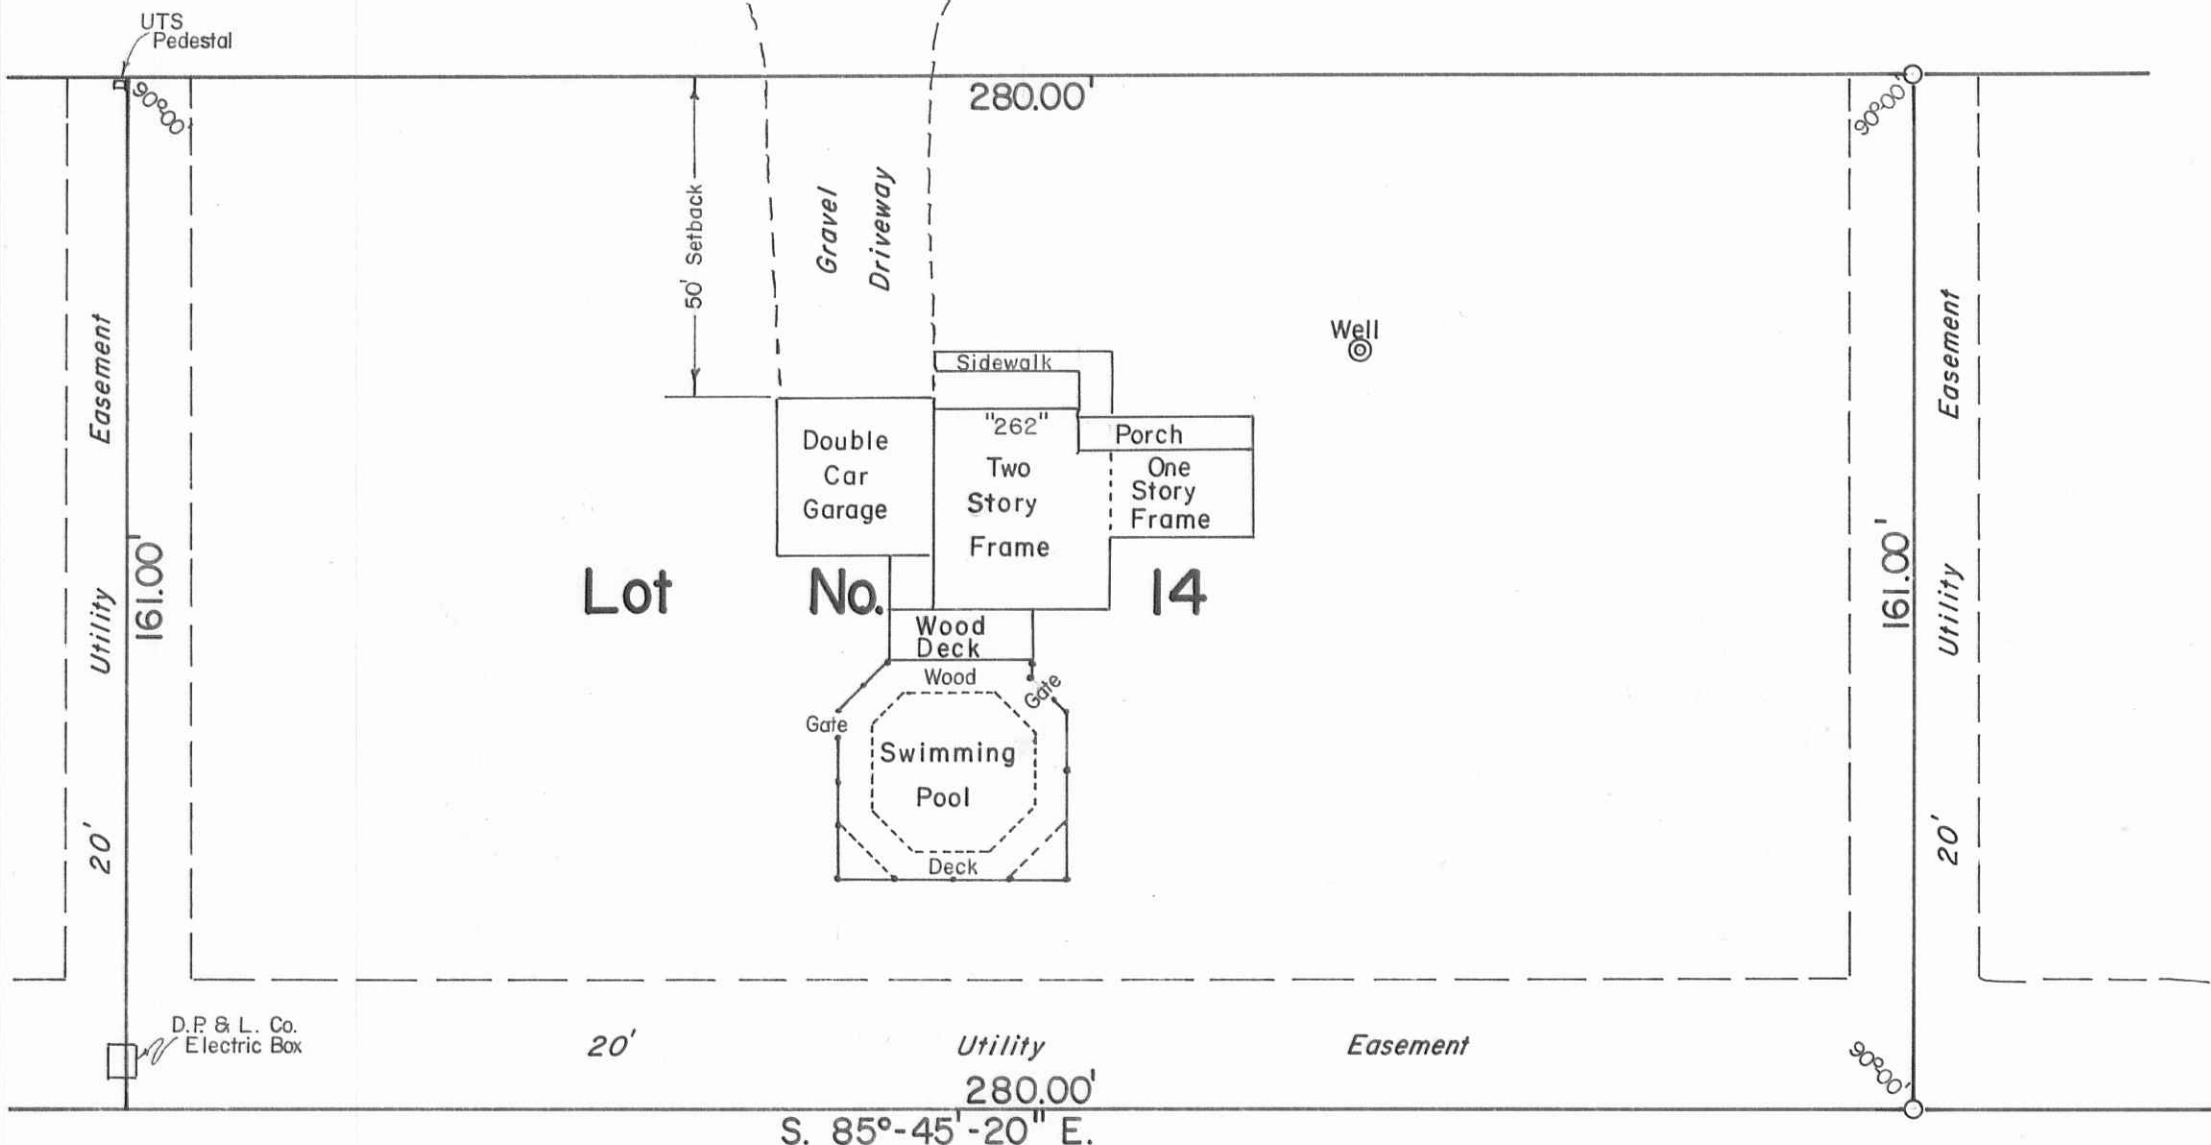

○ -5/8" Rebars Fd.

To whom it may concern:

I, Daniel E. Gilbert, P.S., Reg. Sur. No. 5402, do hereby certify to TRI-CITY RELOCATION and COMMONWEALTH TITLE AGENCY, that on November 16, 1993, I did personally examine the premises as shown on the accompanying plat and I did not find any physical encroachments upon the premises.

Daniel E. Gilbert
 Daniel E. Gilbert, P.S.
 Reg. Sur. No. 5402
 400 N. Park St.
 Bellefontaine, Ohio 43311-2448
 Telephone: 1 (513) 593-1428



Lot No. 14, Tracemore Oaks Allotment, Section No. 30 T.5 R.13 B.M.R.S. Liberty Township, Logan County, Ohio.		
SCALE: 1" = 30'	APPROVED BY:	DRAWN BY DEG
DATE: 11-16-1993		REVISED
<i>Daniel E. Gilbert</i> Daniel E. Gilbert, P.S. Reg. Sur. No. 5402		DRAWING NUMBER 093-051

INDEXED ON MAP
6223

S-734