

Carl E. Oliver et ux
 Vol. 260 P. 559-560 (7-31-1959)
 Per. Par. No. 23-050-00-00-065.000

1.000 Acre

Alice I. Gardner
 Vol. 387 P. 127-128 (3-11-1980)
 Per. Par. No. 23-050-00-00-066.000


Deed - 1.53 Acres
 Surveyed Area
 61,946.565^{sq} ft
 or
 1.422 Acres

Frederick P. Moyer et al
 O.R. No. 119 P. 851-852 (12-28-1990)
 Per. Par. No. 23-050-00-00-067.000

36.090 Acres


Note:
 Adverse Possession Laws May Apply.
 Legal Advice Is Recommended.

Symbols:
 X - R. R. Spike Fd.
 * - R. R. Spike Set.
 ● - 5/8" x 30" Rebars Set.

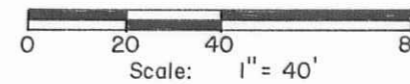

Daniel E. Gilbert
 DANIEL E. GILBERT, P.S.
 REG. SUR. NO. 5402
 400 N. PARK ST.
 BELLEFONTAINE, OHIO 43311
 TELEPHONE: 1 (513) 593-1428

INDEXED ON MAP
 8131

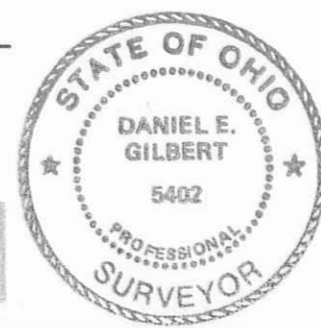

TOLERANCES (EXCEPT AS NOTED)	REVISIONS		
	NO.	DATE	BY
DECIMAL	1		
±	2		
FRACTIONAL	3		
±	4		
ANGULAR	5		
±			

GARDNER RESURVEY			
V.M.S. No. 9884, McArthur Township, Logan County, Ohio.			
DRAWN BY DEG	SCALE 1" = 40'	MATERIAL	
CHK'D	DATE 6-13-1991	DRAWING NO.	
TRACED	APP'D	091-028	

S-744