

Charles A. Bennett et ux
 O.R. No. 79 P. 558 (2-10-1989)
 23-035-00-00-028.001
 80.243 Acres


Rodney Bickham et ux
 O.R. No. 186 P. 584 (4-14-1993)
 23-035-00-00-028.002
 5.012 Acres

A
 122,734.58^{sq ft}
 or
 2.818 Acres


B
 138,582.90^{sq ft}
 or
 3.181 Acres

Ronald D. Justice et al
 O.R. No. 78 P. 244 (1-13-1989)
 23-049-00-00-001.001
 32.640 Acres

V.M.S. No. 9930
 V.M.S. No. 9929

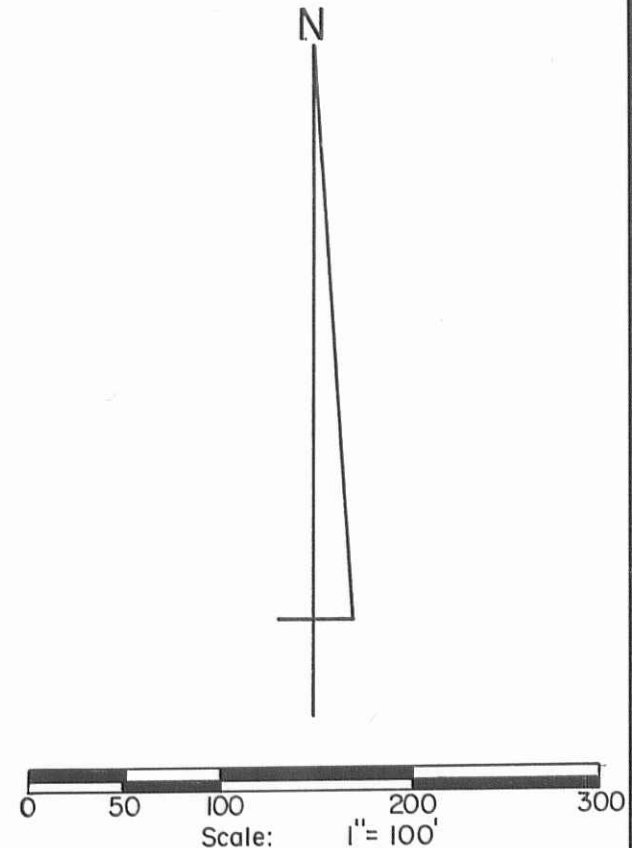

SYMBOLS:
 ○ - R.R. Spikes Set.
 ✖ - R.R. Spikes Fd.
 ○ - 5/8" x 30" Rebars Set.
 ● - 5/8" x 30" Rebars Fd.

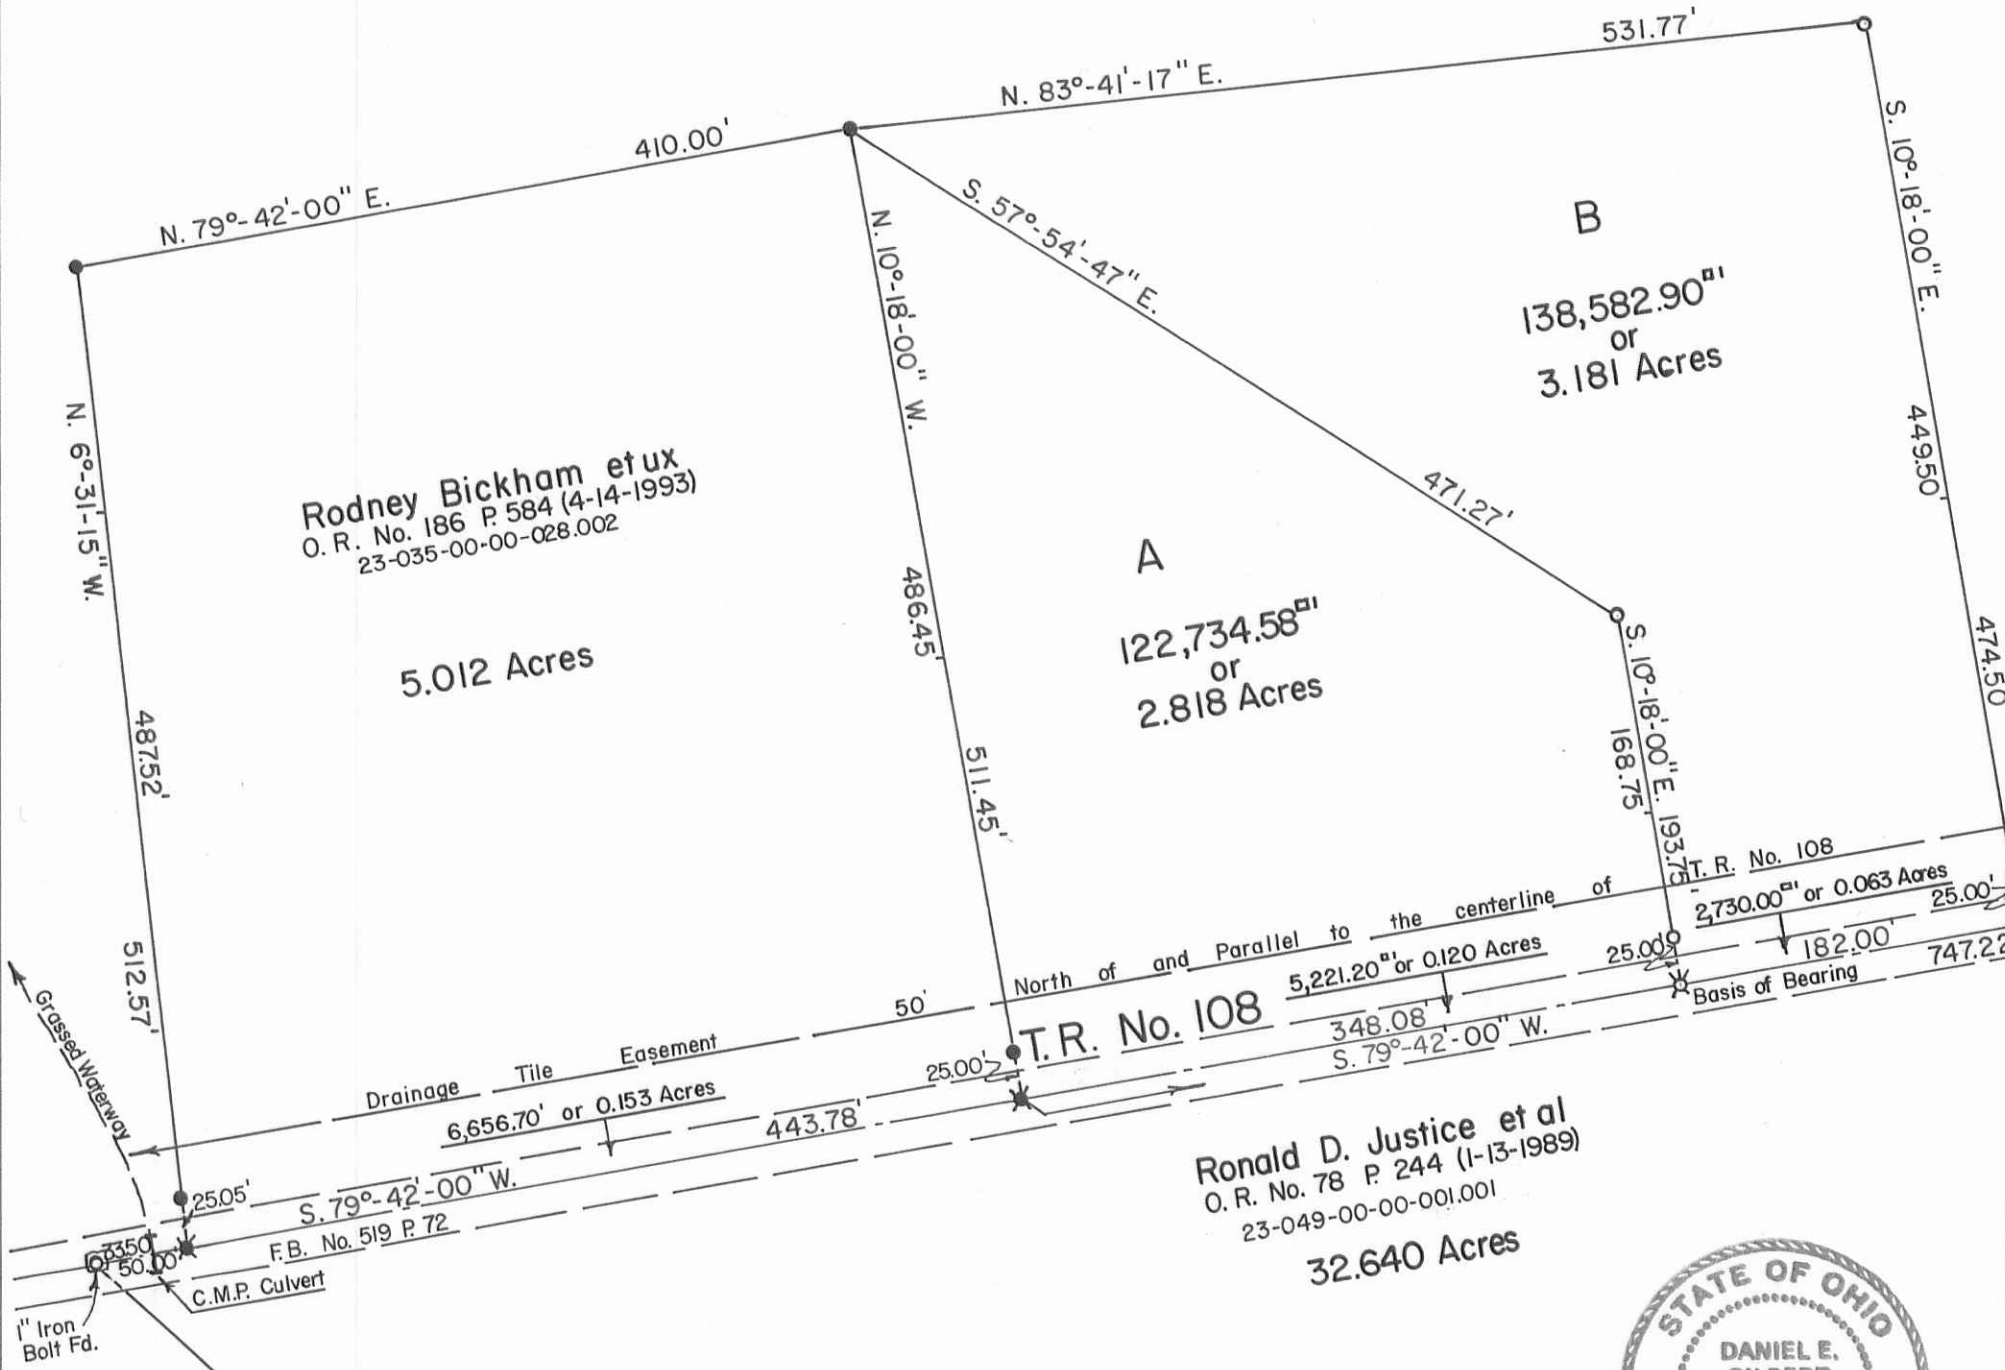

INDEXED ON MAP
 6172



BENNETT SURVEY - V.M.S. No. 9929		
McArthur Township, Logan County, Ohio.		
SCALE: 1" = 100'	APPROVED BY:	DRAWN BY DEG
DATE: 7-15-1993		REVISED
<i>Daniel E. Gilbert</i> Daniel E. Gilbert, P.S. Reg. Sur. No. 5402		DRAWING NUMBER 093-034

S-747