

Gene E. Blumenschein et al (Trustee)
 O.R. No. 221 P 933 (2-1-1994)
 34-103-00-00-031.000

25.00 Acres

S. 61°-10'-00" E.

Drainage Line Easement -20' Wide
 O.R. No. 66 P 137 (6-11-1988)

3/4" Iron Pipe Fd.

236.30'

271.00'

34.70'

311.07'
 131.38'

31,621.83^{sq}
 or
 0.726 Acres

Note: This part surveyed 7-13-1988 (088-047) DEG.

S. 61°-10'-00" E.

181.96'

216.66'

34.70'

Sandra J. Adams
 Vol. No. 344 P 805 (1-15-1973)
 34-118-00-00-006.000

1.488 Acres

33,186.09^{sq}
 or
 0.762 Acres

Leonard L. Cook et ux
 Vol. No. 306 P 675 (3-10-1966)
 34-118-00-00-005.000

2.46 Acres

N. 39°-03'-00" E.

179.69'

3/4" Iron Pipe Fd.

100.66'

N. 52°-57'-00" W.

133.00'

32.34'

1/2" Iron Pipe Fd.

221.73'
 6,731.65^{sq} or 0.155 Acres
 S. 59°-00'-00" W.


227.08'

Basis of Bearing
 See: F.B. No. 619 P. 12.

4,500.00^{sq} or 0.103 Acres
 S. 59°-00'-00" W.

116.75'
 60'


3/4" Rebar Fd.
 Sta. No. 82+50
 Δ=6°02' Lt.

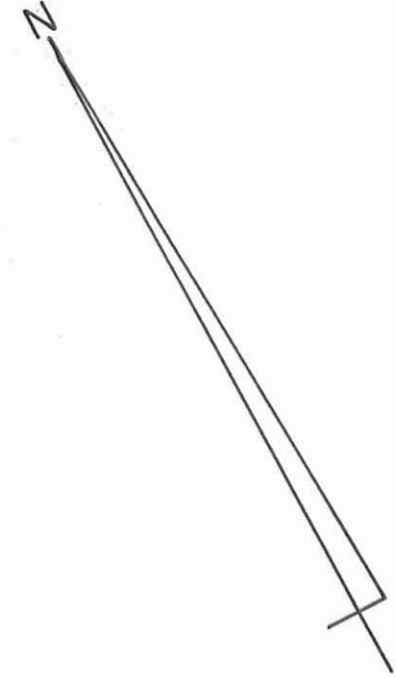

Scale: 1" = 40'

SYMBOLS:

- - R. R. Spikes Fd.
- - 1/2" or 3/4" Iron Pipes Fd.
- ✕ - 5/8" x 30" Rebars Fd.
- ⊗ - 5/8" x 30" Rebars Set.

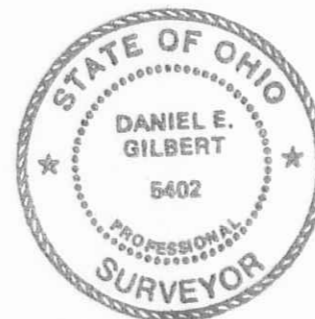

Sandra J. Adams Survey - South Part of Original 1.49 Acre Tract, Section No. 31 T.3 R.14 BMRS, Pleasant Township, Logan County, Ohio.

SCALE: 1" = 40'

APPROVED BY:

DRAWN BY DEG

DATE: 5-18-1994

REVISED 6-3-1994 DEG

Daniel E. Gilbert

Daniel E. Gilbert, P.S.
 Reg. Sur. No. 5402

DRAWING NUMBER
 094-022

INDEXED ON MAP
 3974

S-778