


Reference:
Fernwood Subdivision No. 1 (7-11-1923).
Plat Cab. A Slide 179.

INDEXED ON MAP
8896

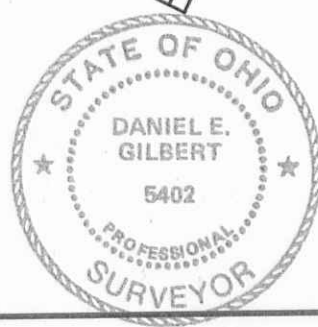

Per. Par. No. 36-019-10-01-044.000
Lot No. 39.
Floyd W. Murdock et ux.
Vol. No. 353 P. 912 (7-2-1974).

SYMBOLS:
⊙ - 1 1/2" O.D., Iron Pipe Fd.
○ - 5/8" x 30" Rebars Set.
● - Chisel Point in Concrete Walk Set.

**MURDOCK SURVEY - Lot No. 39 and Extension Thereto,
Fernwood Subdivision No. 1 - Long Island, V.M.S. No. 13393,
Richland Township, Logan County, Ohio.**

SCALE: 1" = 20'	APPROVED BY:	DRAWN BY: DEG
DATE: 4-20-1994		REVISED:
<i>Daniel E. Gilbert</i> Daniel E. Gilbert, P.S. Reg. Sur. No. 5402		DRAWING NUMBER 094-012

S-789