


To whom it may concern:

I, Daniel E. Gilbert, P.S., Reg. Sur. No. 5402, do hereby certify that on December 6, 1995, I did personally resurveyed and located the improvements as shown on the accompanying plat and I did not find any encroachments.

Daniel E. Gilbert
Daniel E. Gilbert, P.S.
Reg. Sur. No. 5402
400 N. Park St.
Bellefontaine, Ohio 43311
Phone: (513) 593-1428

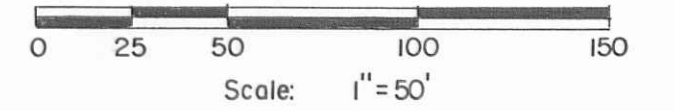

Thomas E. Hurley, Trustee
O. R. No. 272 P. 157 (5-22-1995)
37-033-00-00-036.000

115.050 Acres

S. R. No. 366
S. 49°-35'-00" E.

31" h. x 36" w.
Concrete Box
Culvert

Basis of Bearing
21,423.00[±] or
0.492 Acres

R.W. Marks et al
O.R. No. 249 P. 100
Plan L-11

Note: This monument
is broken off.

60'

151,978.035[±]
or
3.489 Acres

N. 49°-35'-00" W.




George R. Stevenson et al
Vol. No. 389 P. 37 (8-27-1980)
37-033-00-00-028.000

7.904 Acres

Reference Deed:
Charlotte W. Liston - 3.490 Acres.
O. R. No. 248 P. 154 (1-11-1995).
37-033-00-00-029.000

- Symbols:
- - P. K. Nails Set.
 - - 1" Iron Pipe Fd.
 - ▣ - 5/8" Iron Bar Fd.
 - - 2" Iron Pipes Fd.

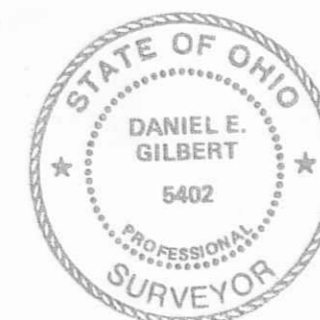

LISTON-SNYDER RESURVEY, Mortgage Inspection,
V. M. S. No. 9947, Richland Township,
Logan County, Ohio.

SCALE: 1" = 50' APPROVED BY: DANIEL E. GILBERT
DATE: 12-6-1995 DRAWN BY: DEG

Daniel E. Gilbert
Daniel E. Gilbert, P.S.
Reg. Sur. No. 5402

DRAWING NUMBER
095-055

INDEXED ON MAP
3334

S-815