
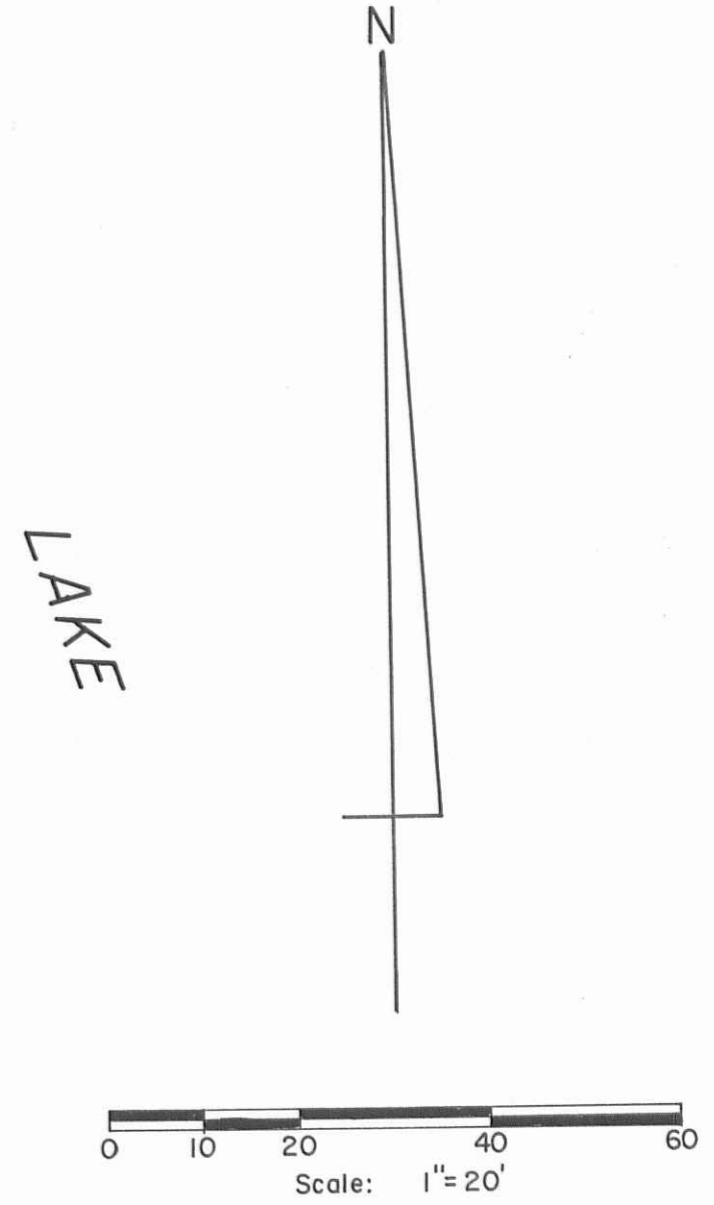


**SURVEYORS CERTIFICATION:**

I, Daniel E. Gilbert, P.S., Reg. Sur. No. 5402, do hereby certify to National City Bank and Eagle Land Title Co., that on August 23, 1993, that I made an accurate survey of the premises shown on this plat and that there are no visible easements or encroachments on the ground other than those shown. Buildings and other improvements shown were located from actual monumentation found or set as shown.

*Daniel E. Gilbert*

Daniel E. Gilbert, P.S.  
 Reg. Sur. No. 5402  
 400 N. Park St.  
 Bellefontaine, Ohio 43311  
 Phone: 1 (513) 593-1428

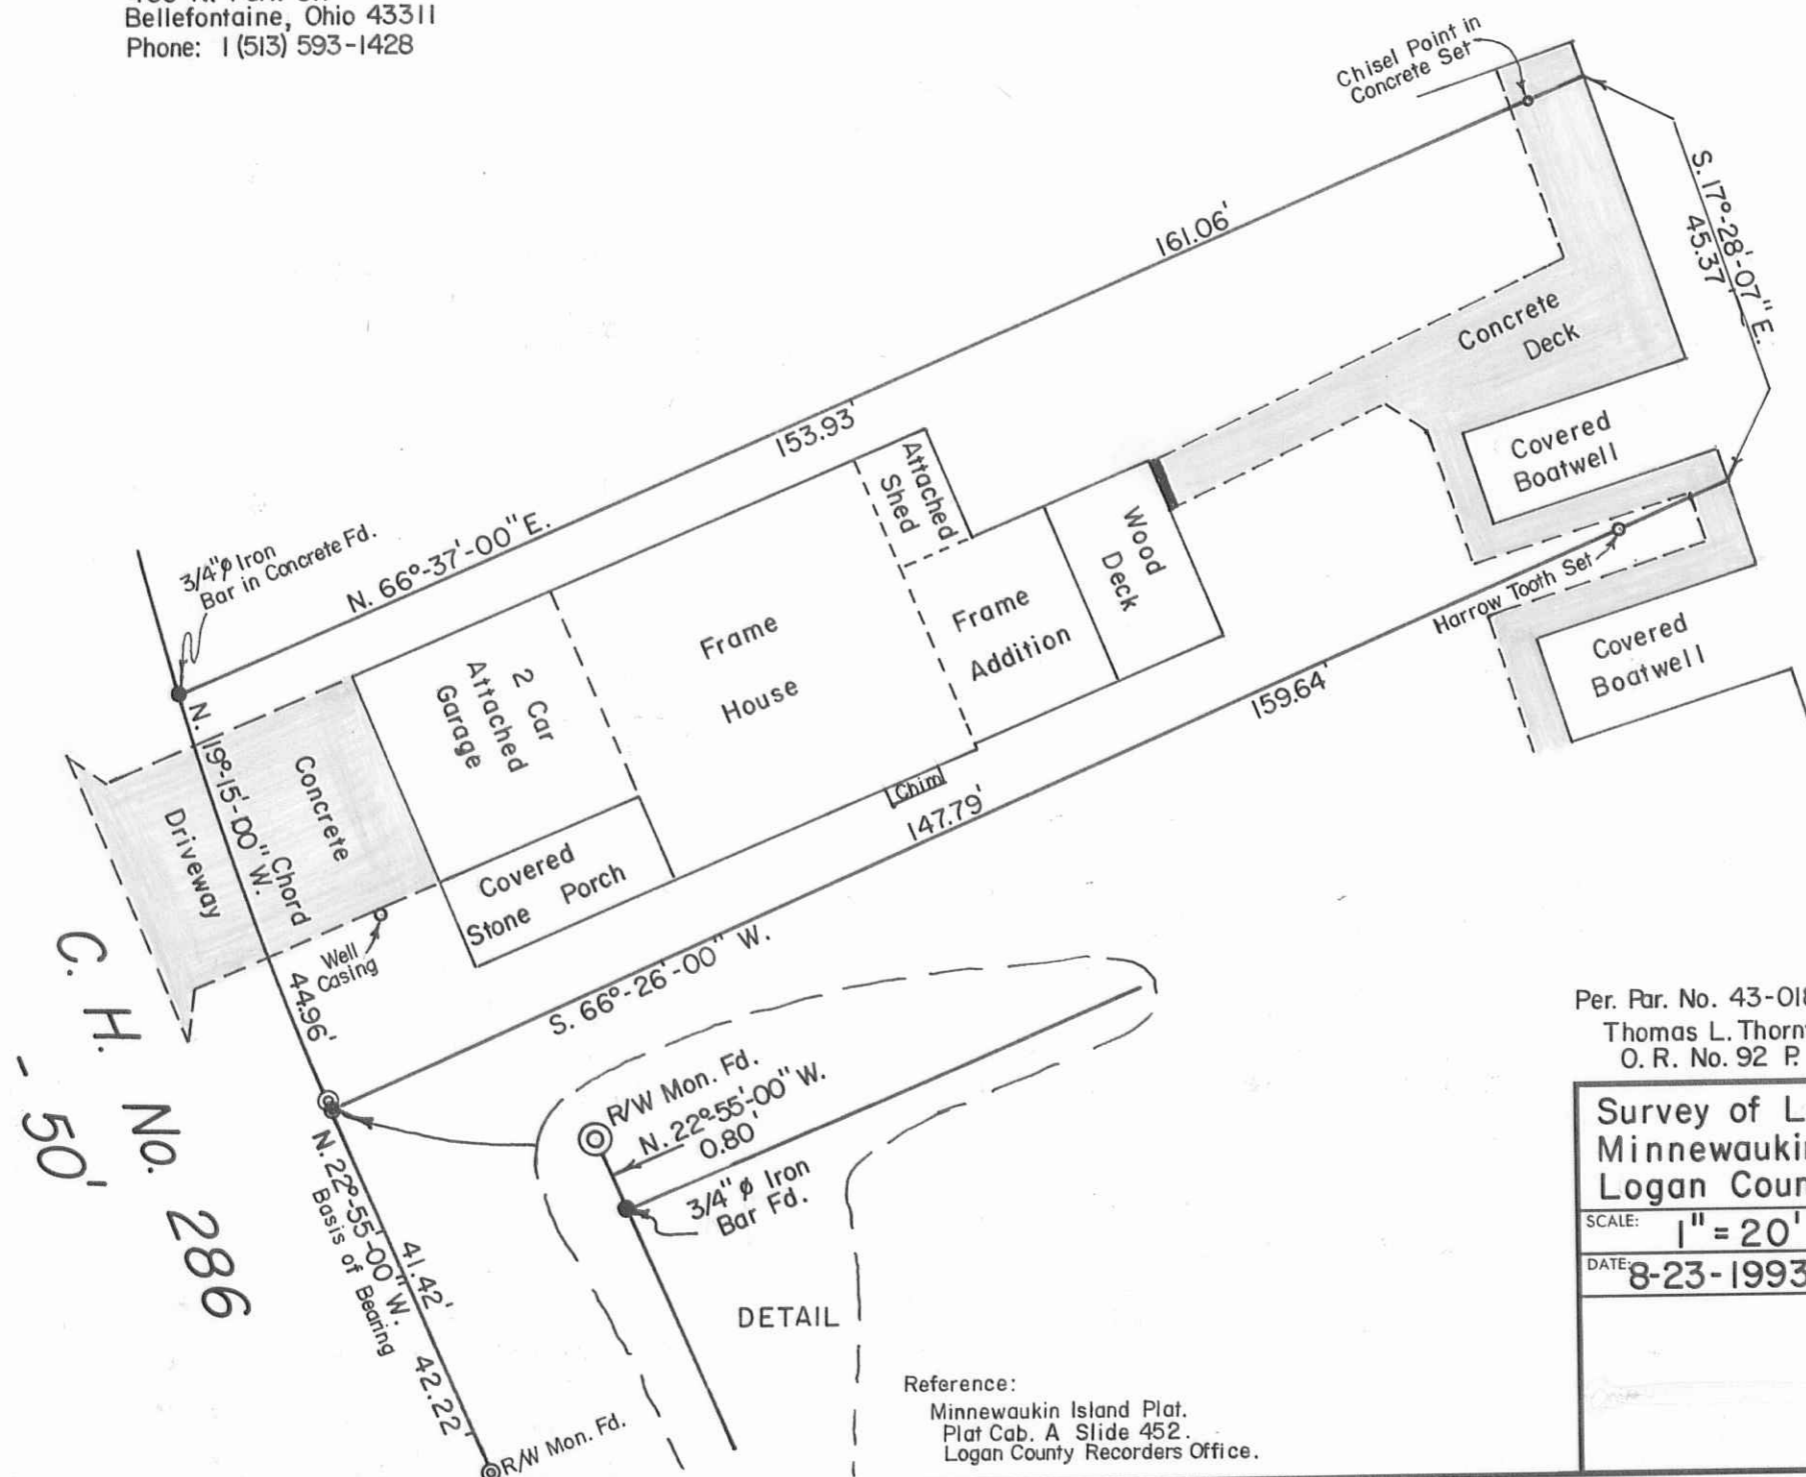

Per. Par. No. 43-018-19-04-036.000 (0.167 Acres).  
 Thomas L. Thornton et al  
 O. R. No. 92 P. 232 (9-5-1989).

Survey of Lot No. 46-223, V.M.S. No. 12276, Minnewaukin Island, Stokes Township, Logan County, Ohio.	
SCALE: 1" = 20'	APPROVED BY:
DATE: 8-23-1993	DRAWN BY: DEG
	REVISED:
	DRAWING NUMBER: 093-043

Reference:  
 Minnewaukin Island Plat.  
 Plat Cab. A Slide 452.  
 Logan County Recorders Office.

INDEXED ON MAP  
 8831

C. H. No. 286  
 50'

S-857