


BOKE SCREEK TOWNSHIP
 VIRGINIA MILITARY SURVEYS 12112 7161
 SCALE 10 CHAINS TO THE INCH

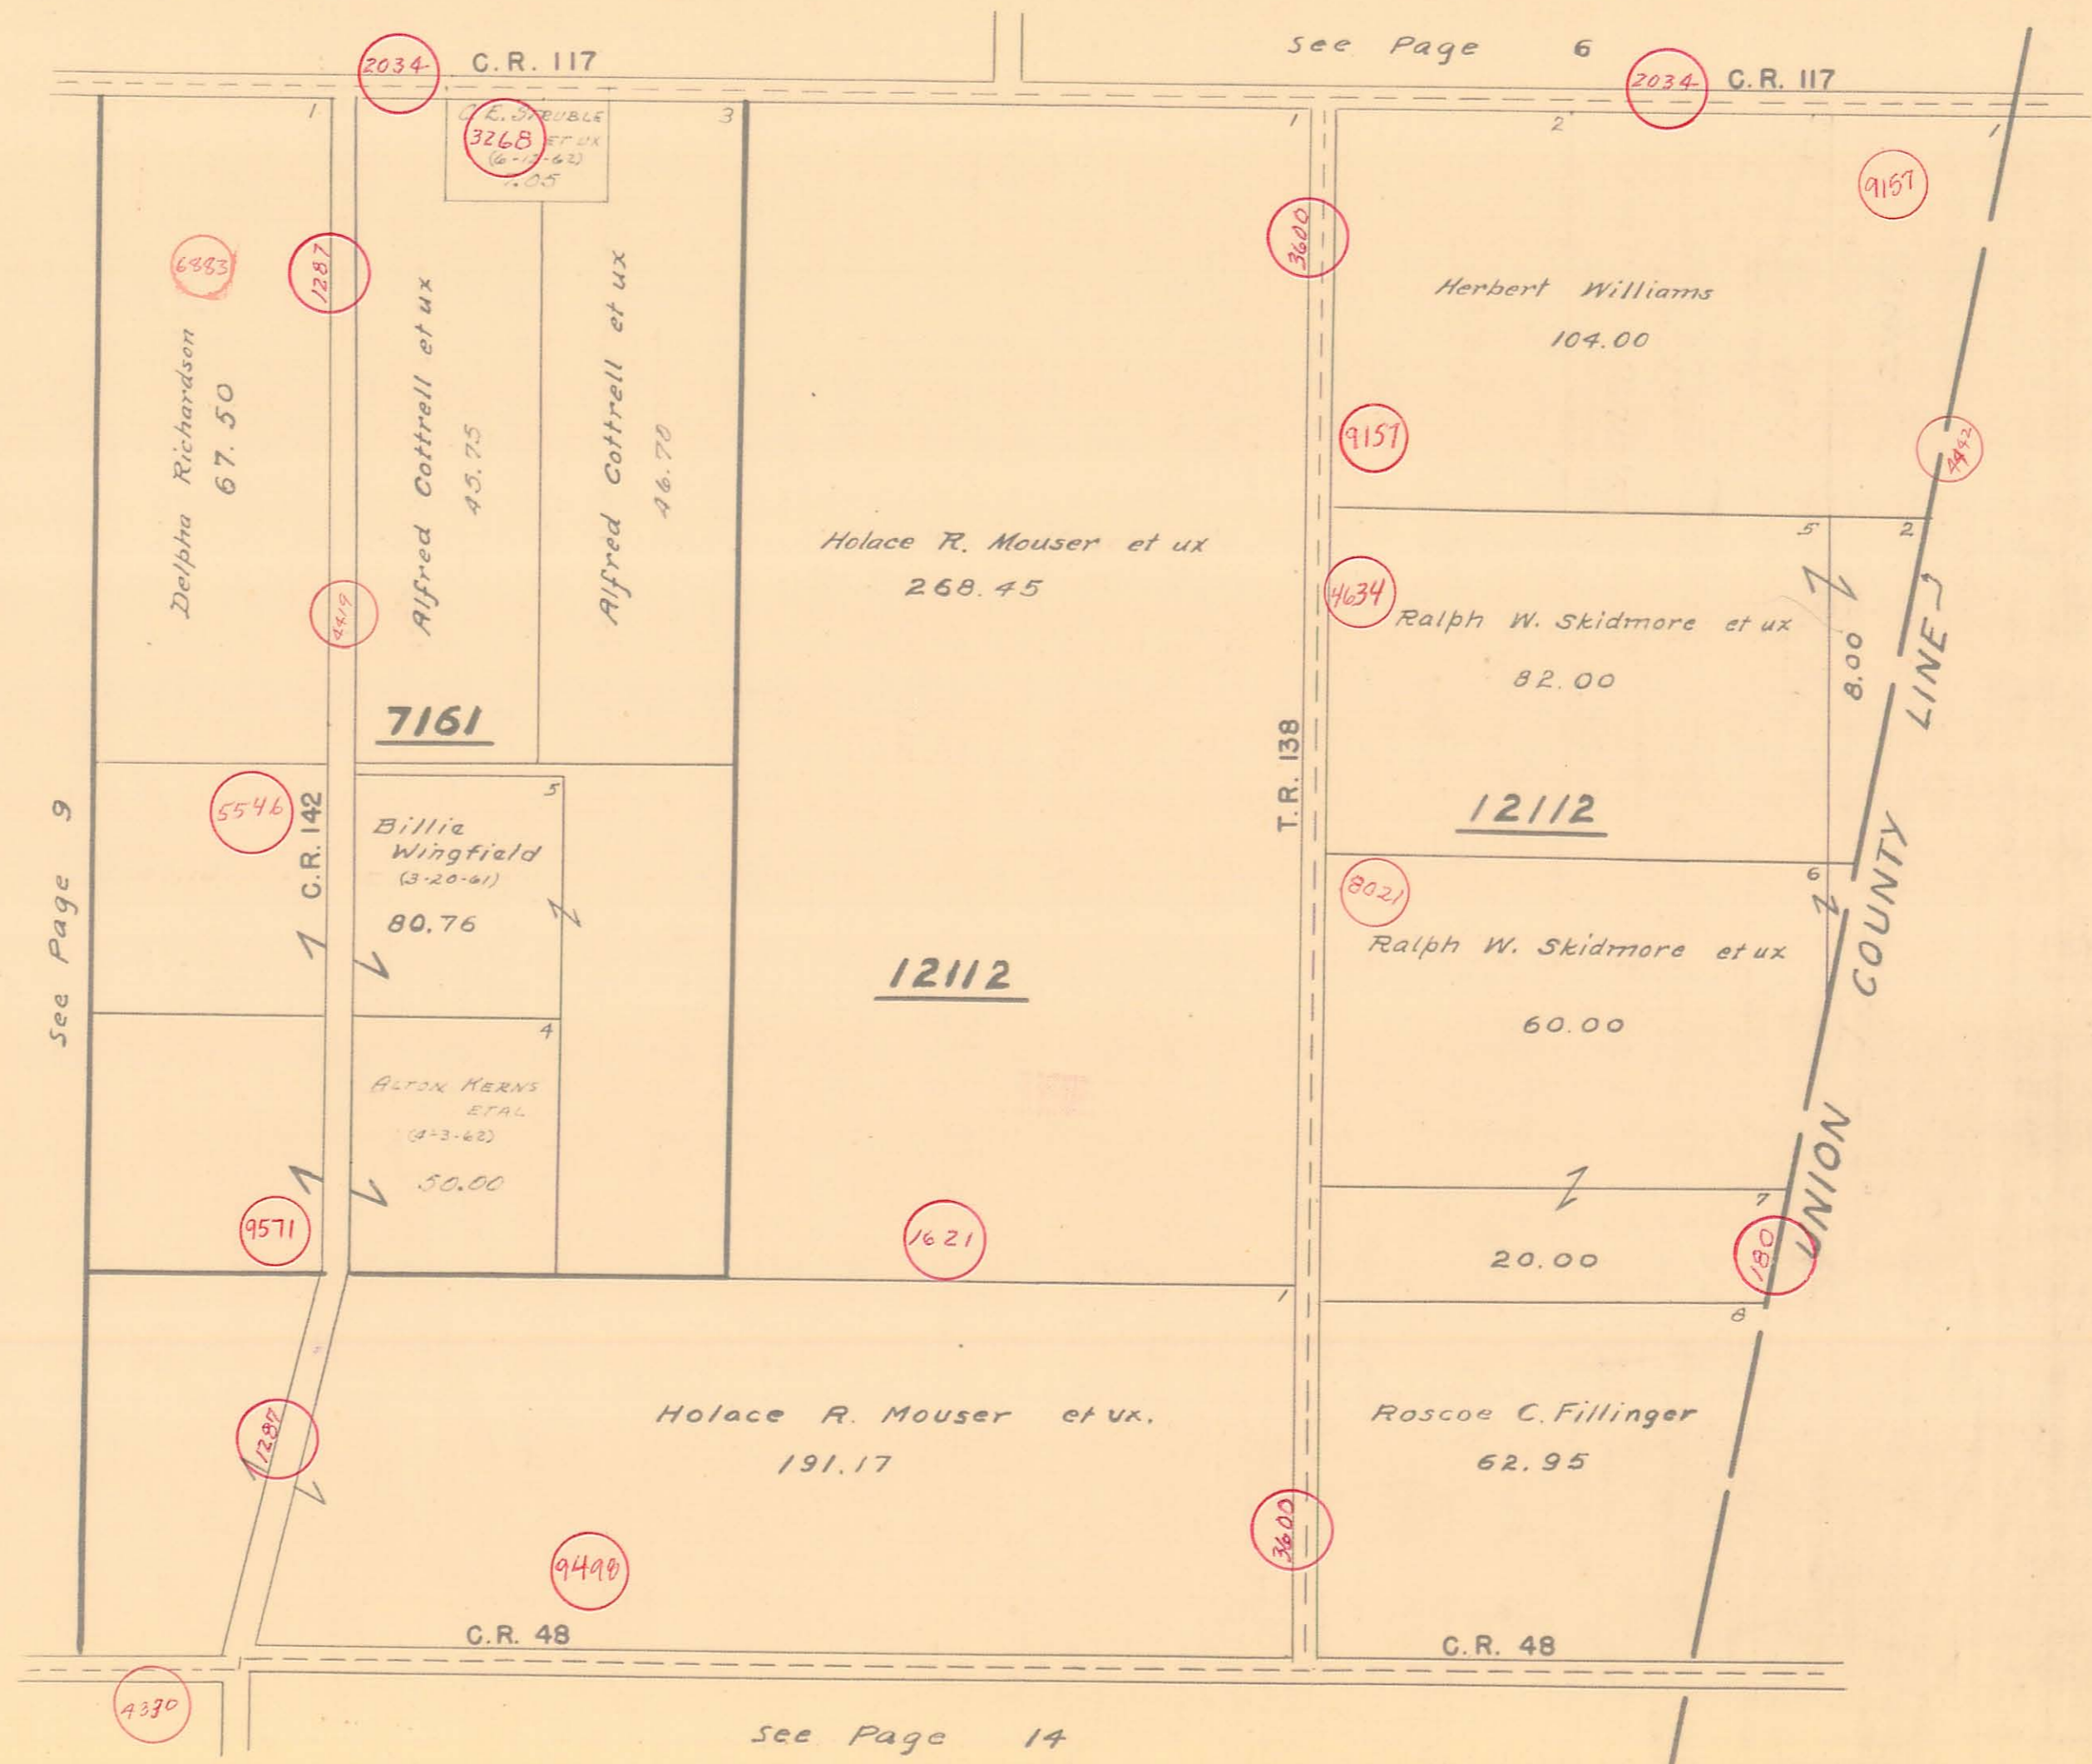

11/43
 D.E.G.
 G.W. Wilgus