


# JEFFERSON TOWNSHIP

VIRGINIA MILITARY SURVEY 4498

SCALE: 1" = 10 CHAINS = 660'

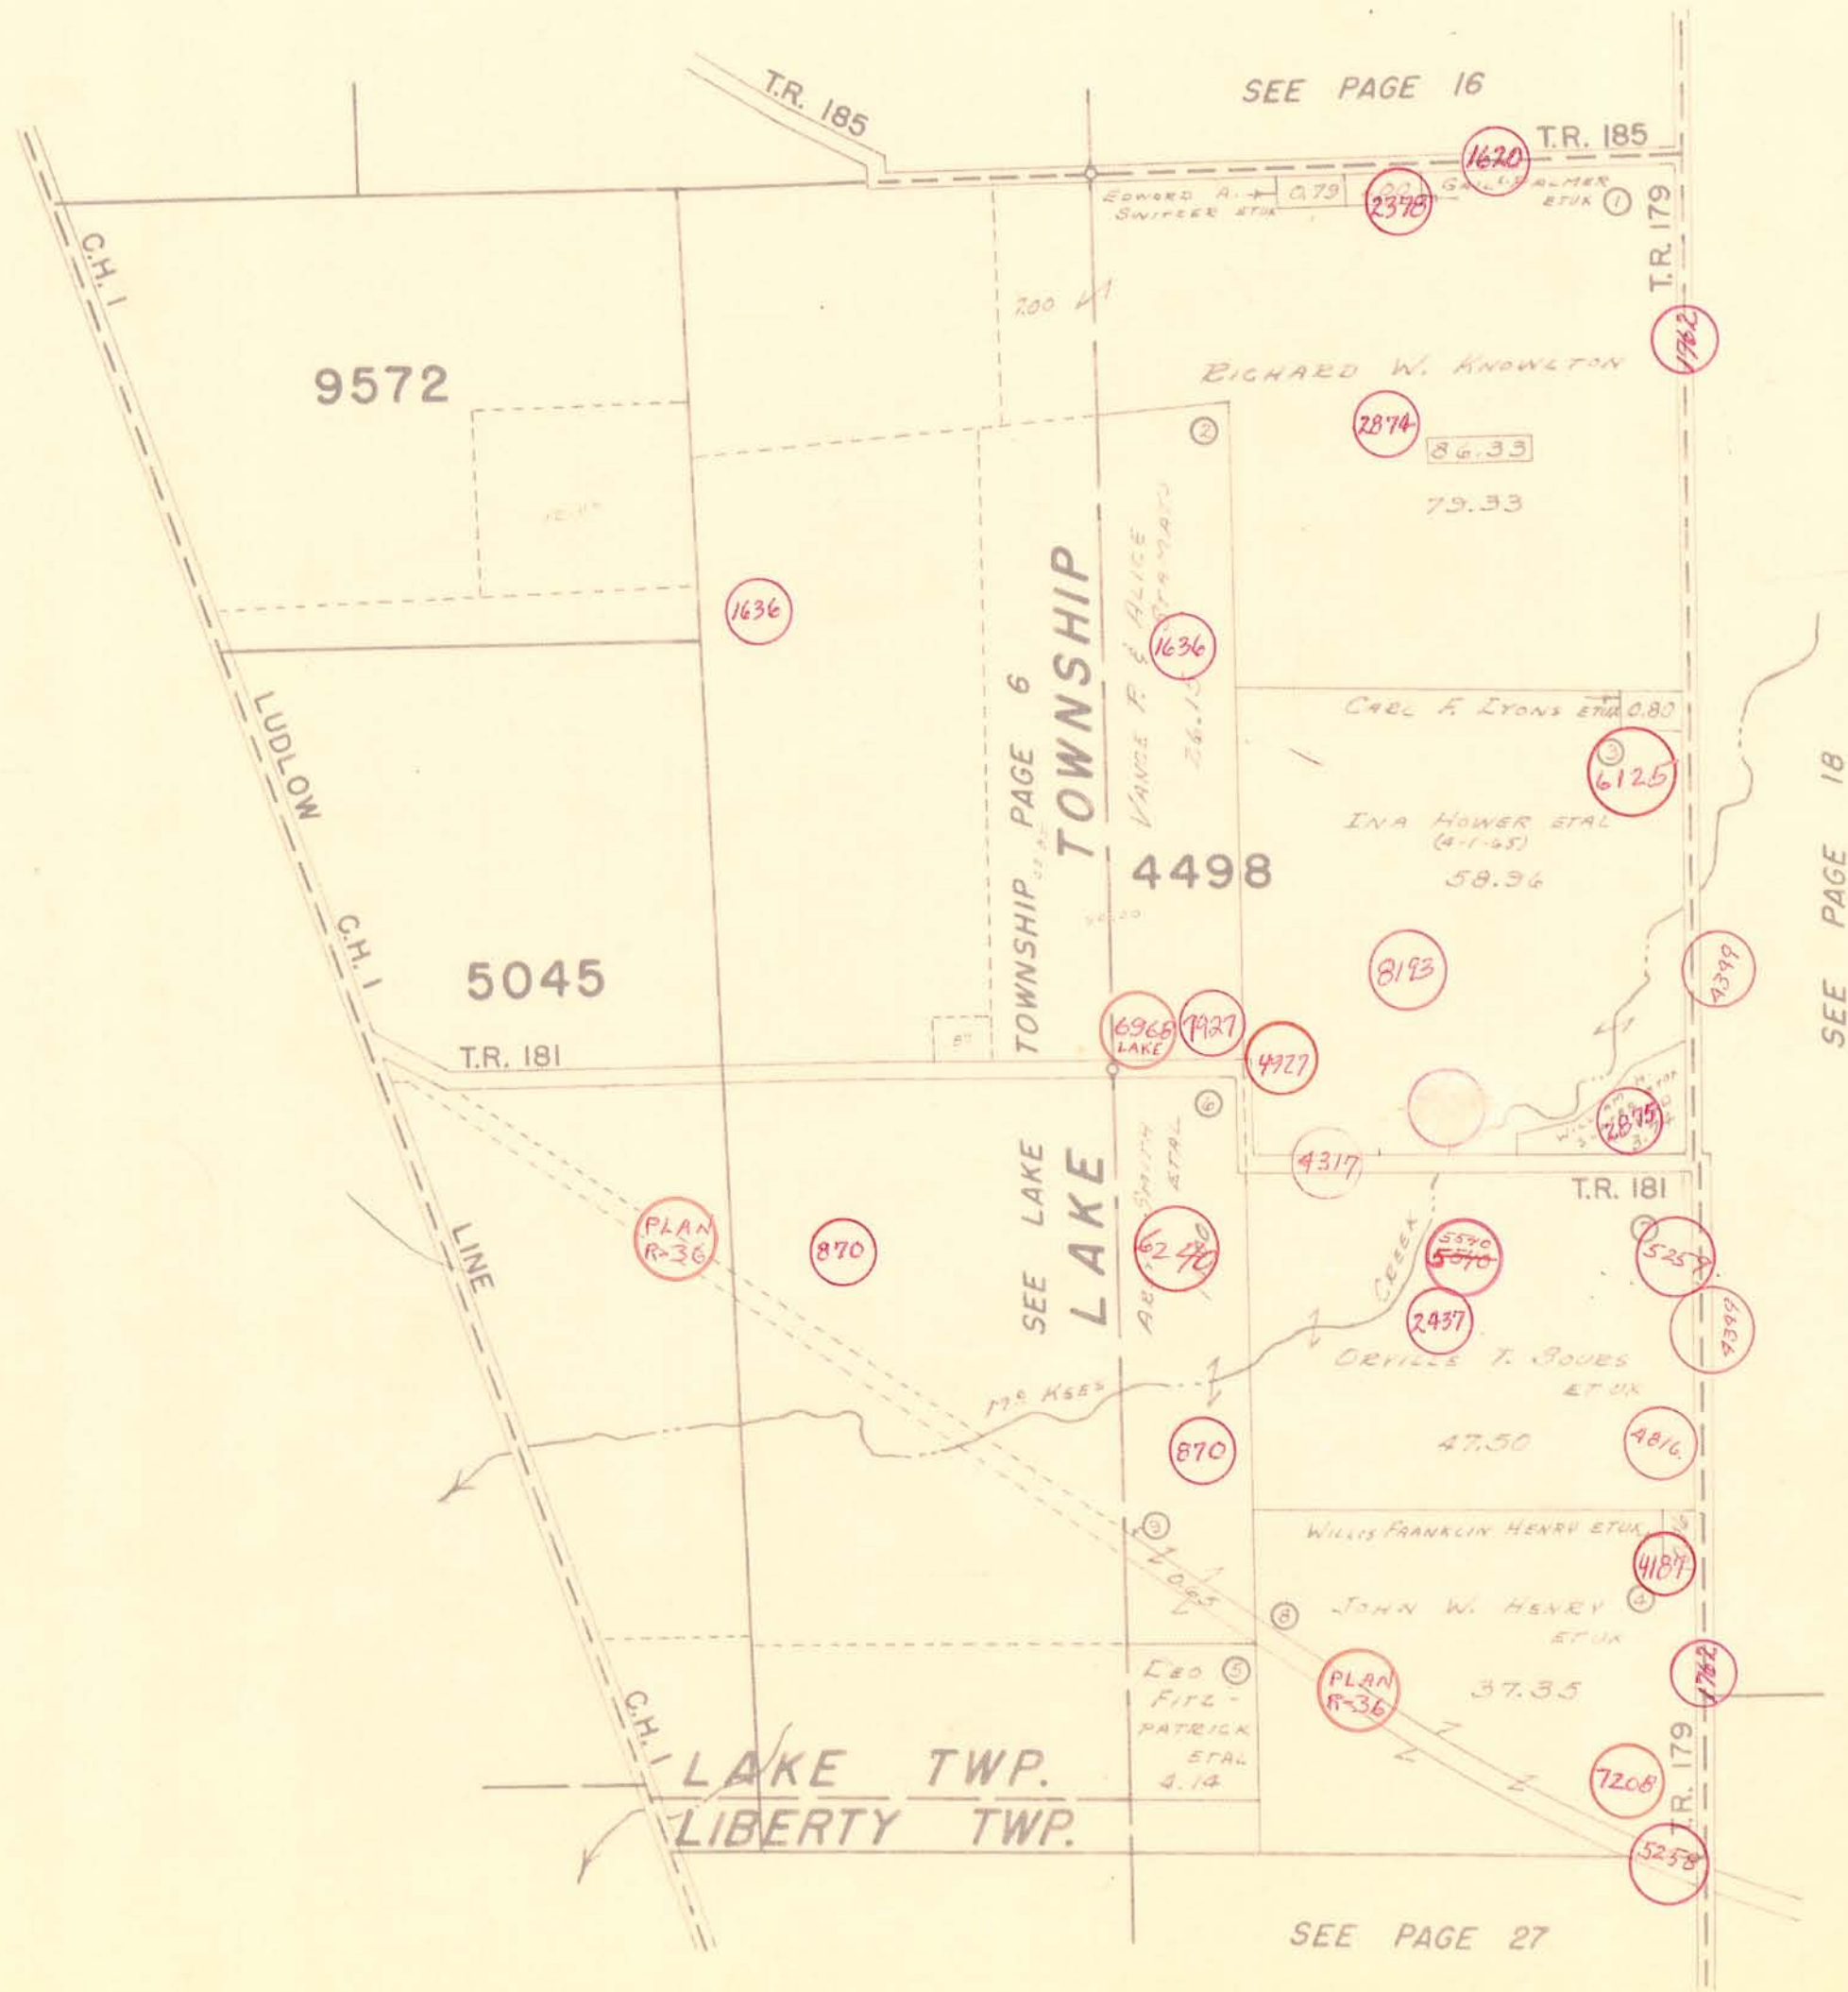

DRAWN FEBRUARY 4, 1968  
BY D.E.G.  
FROM AERIAL PHOTO

SEE PAGE 27