


LAKE TOWNSHIP

SECTION 34 TOWN 4 RANGE 14 (PART)

SCALE : 1 INCH = 200 FEET

See City Plat Book Page 13

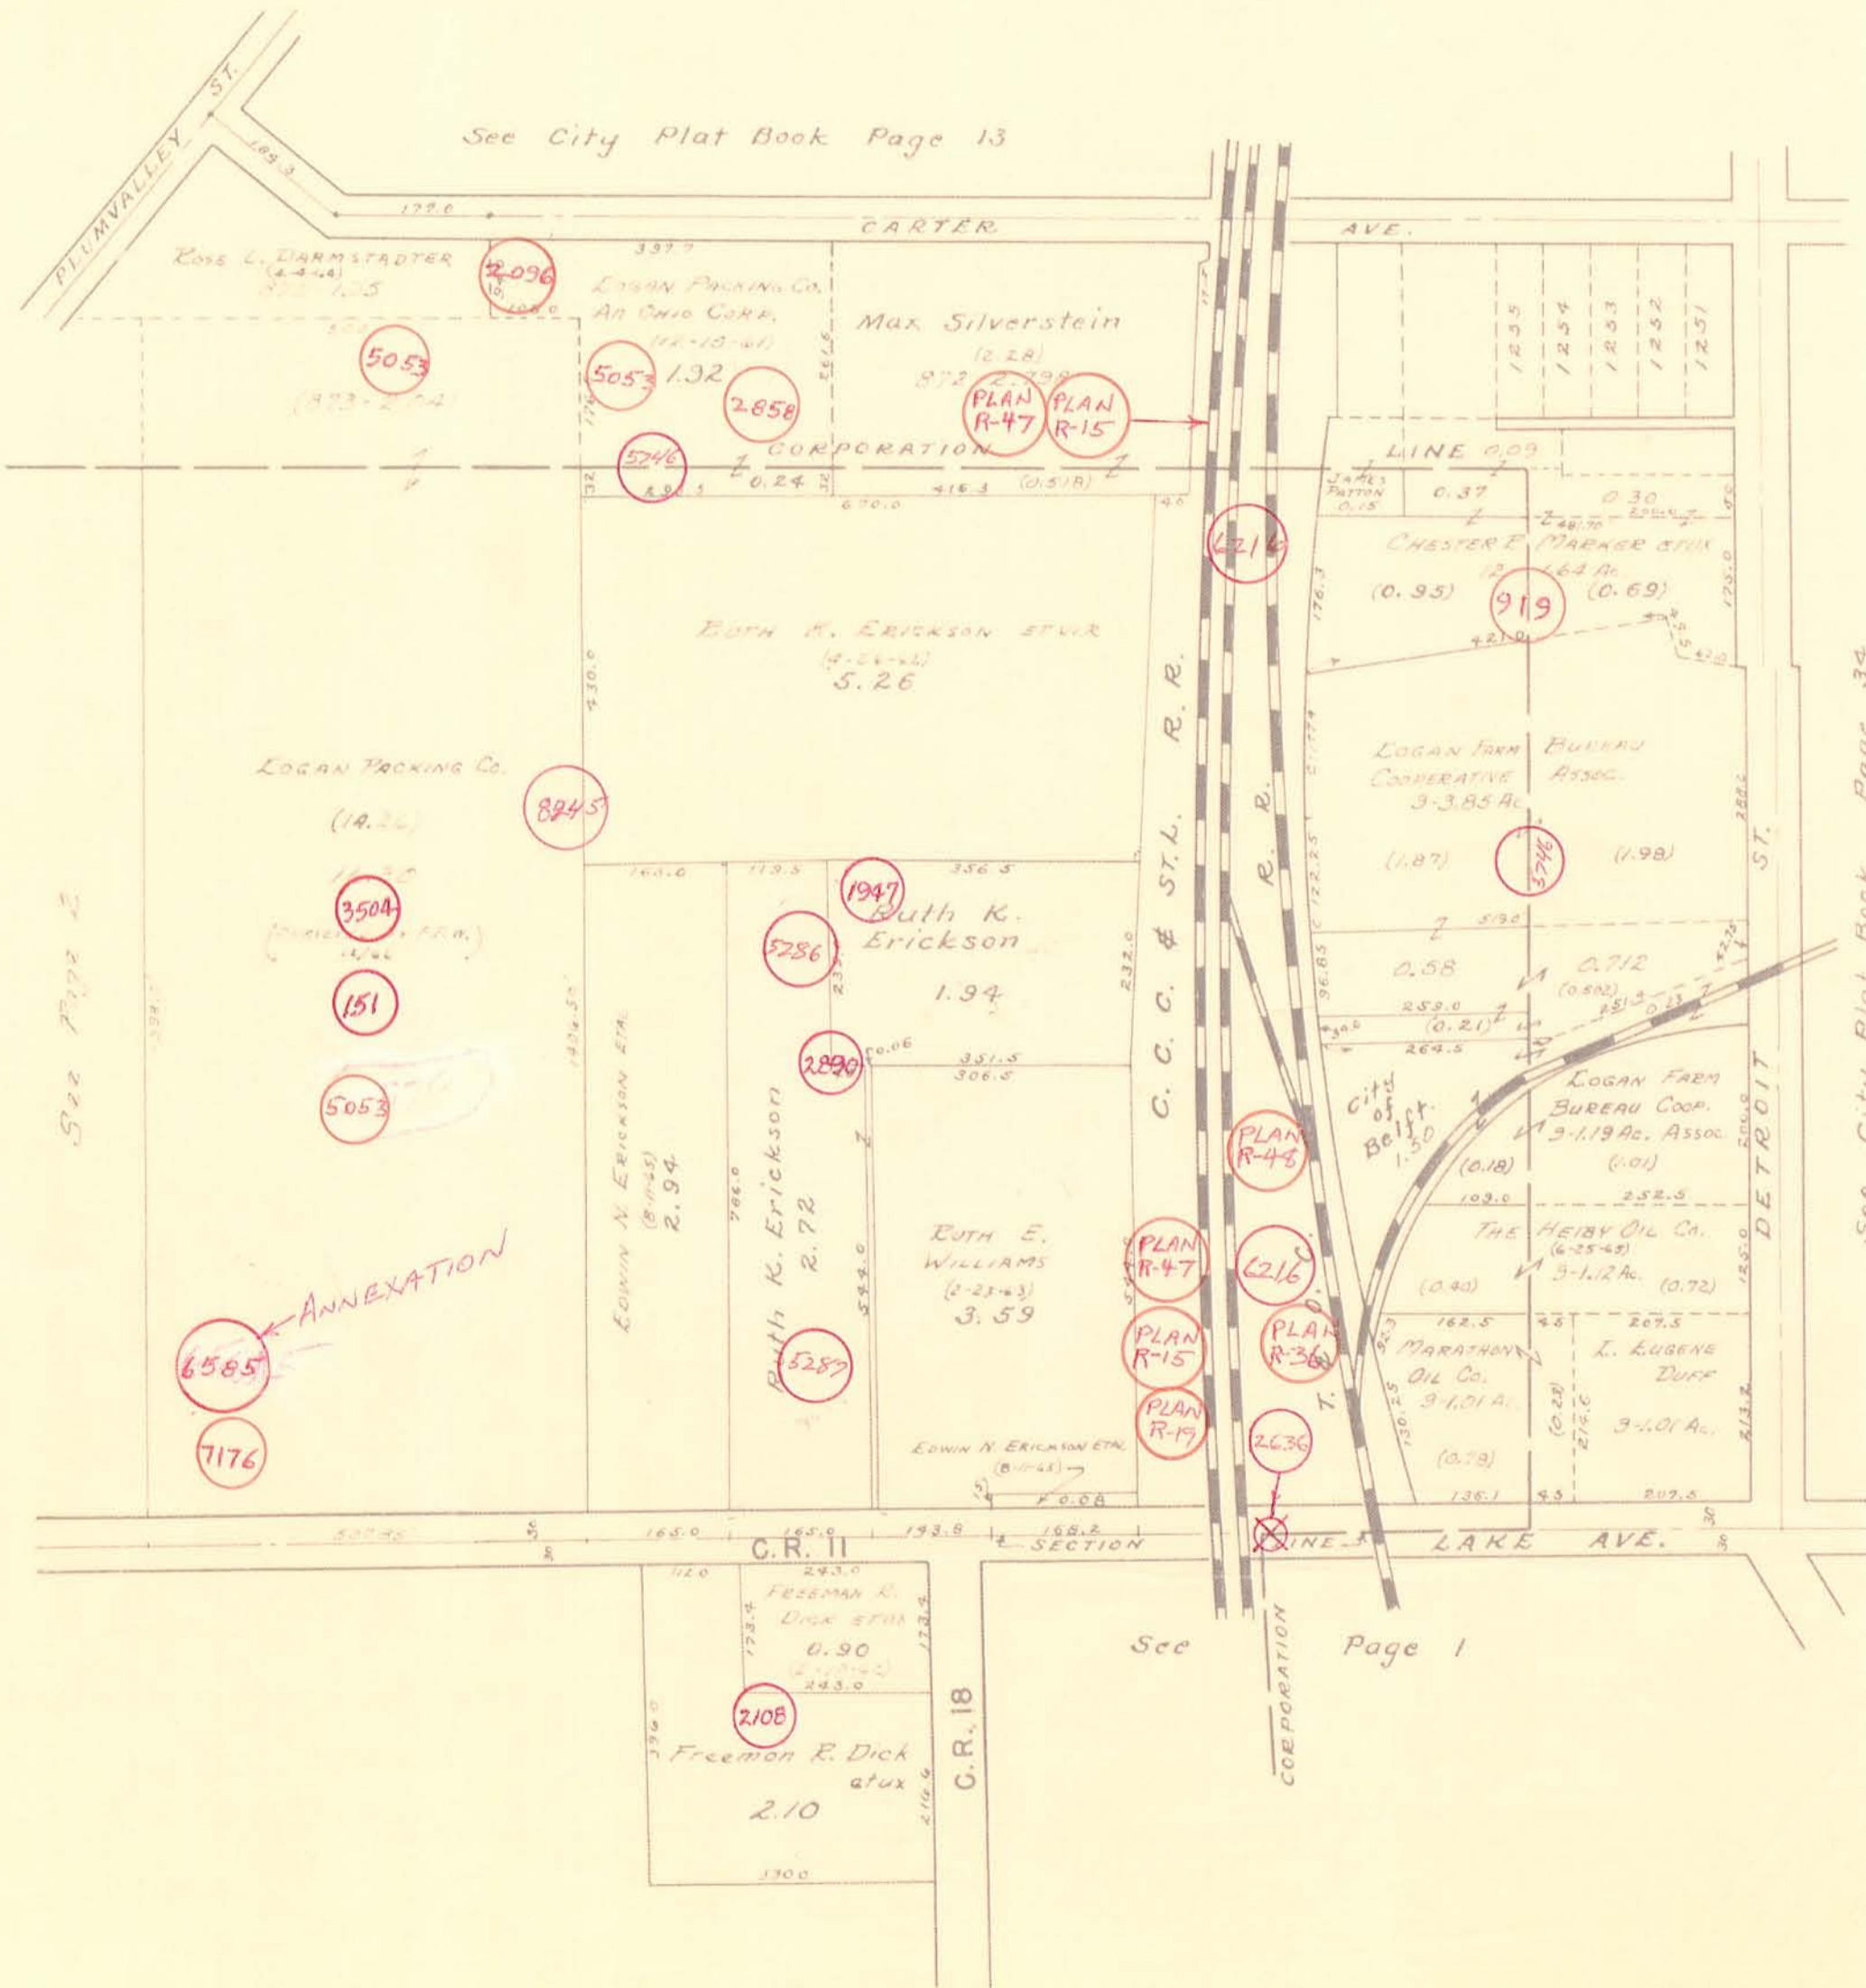

See City Plat Book Page 34

See Page 1