


LAKE TOWNSHIP

HOLLY HILL SUBDIVISION

V.M.S. 2873

SCALE: 1"=100'

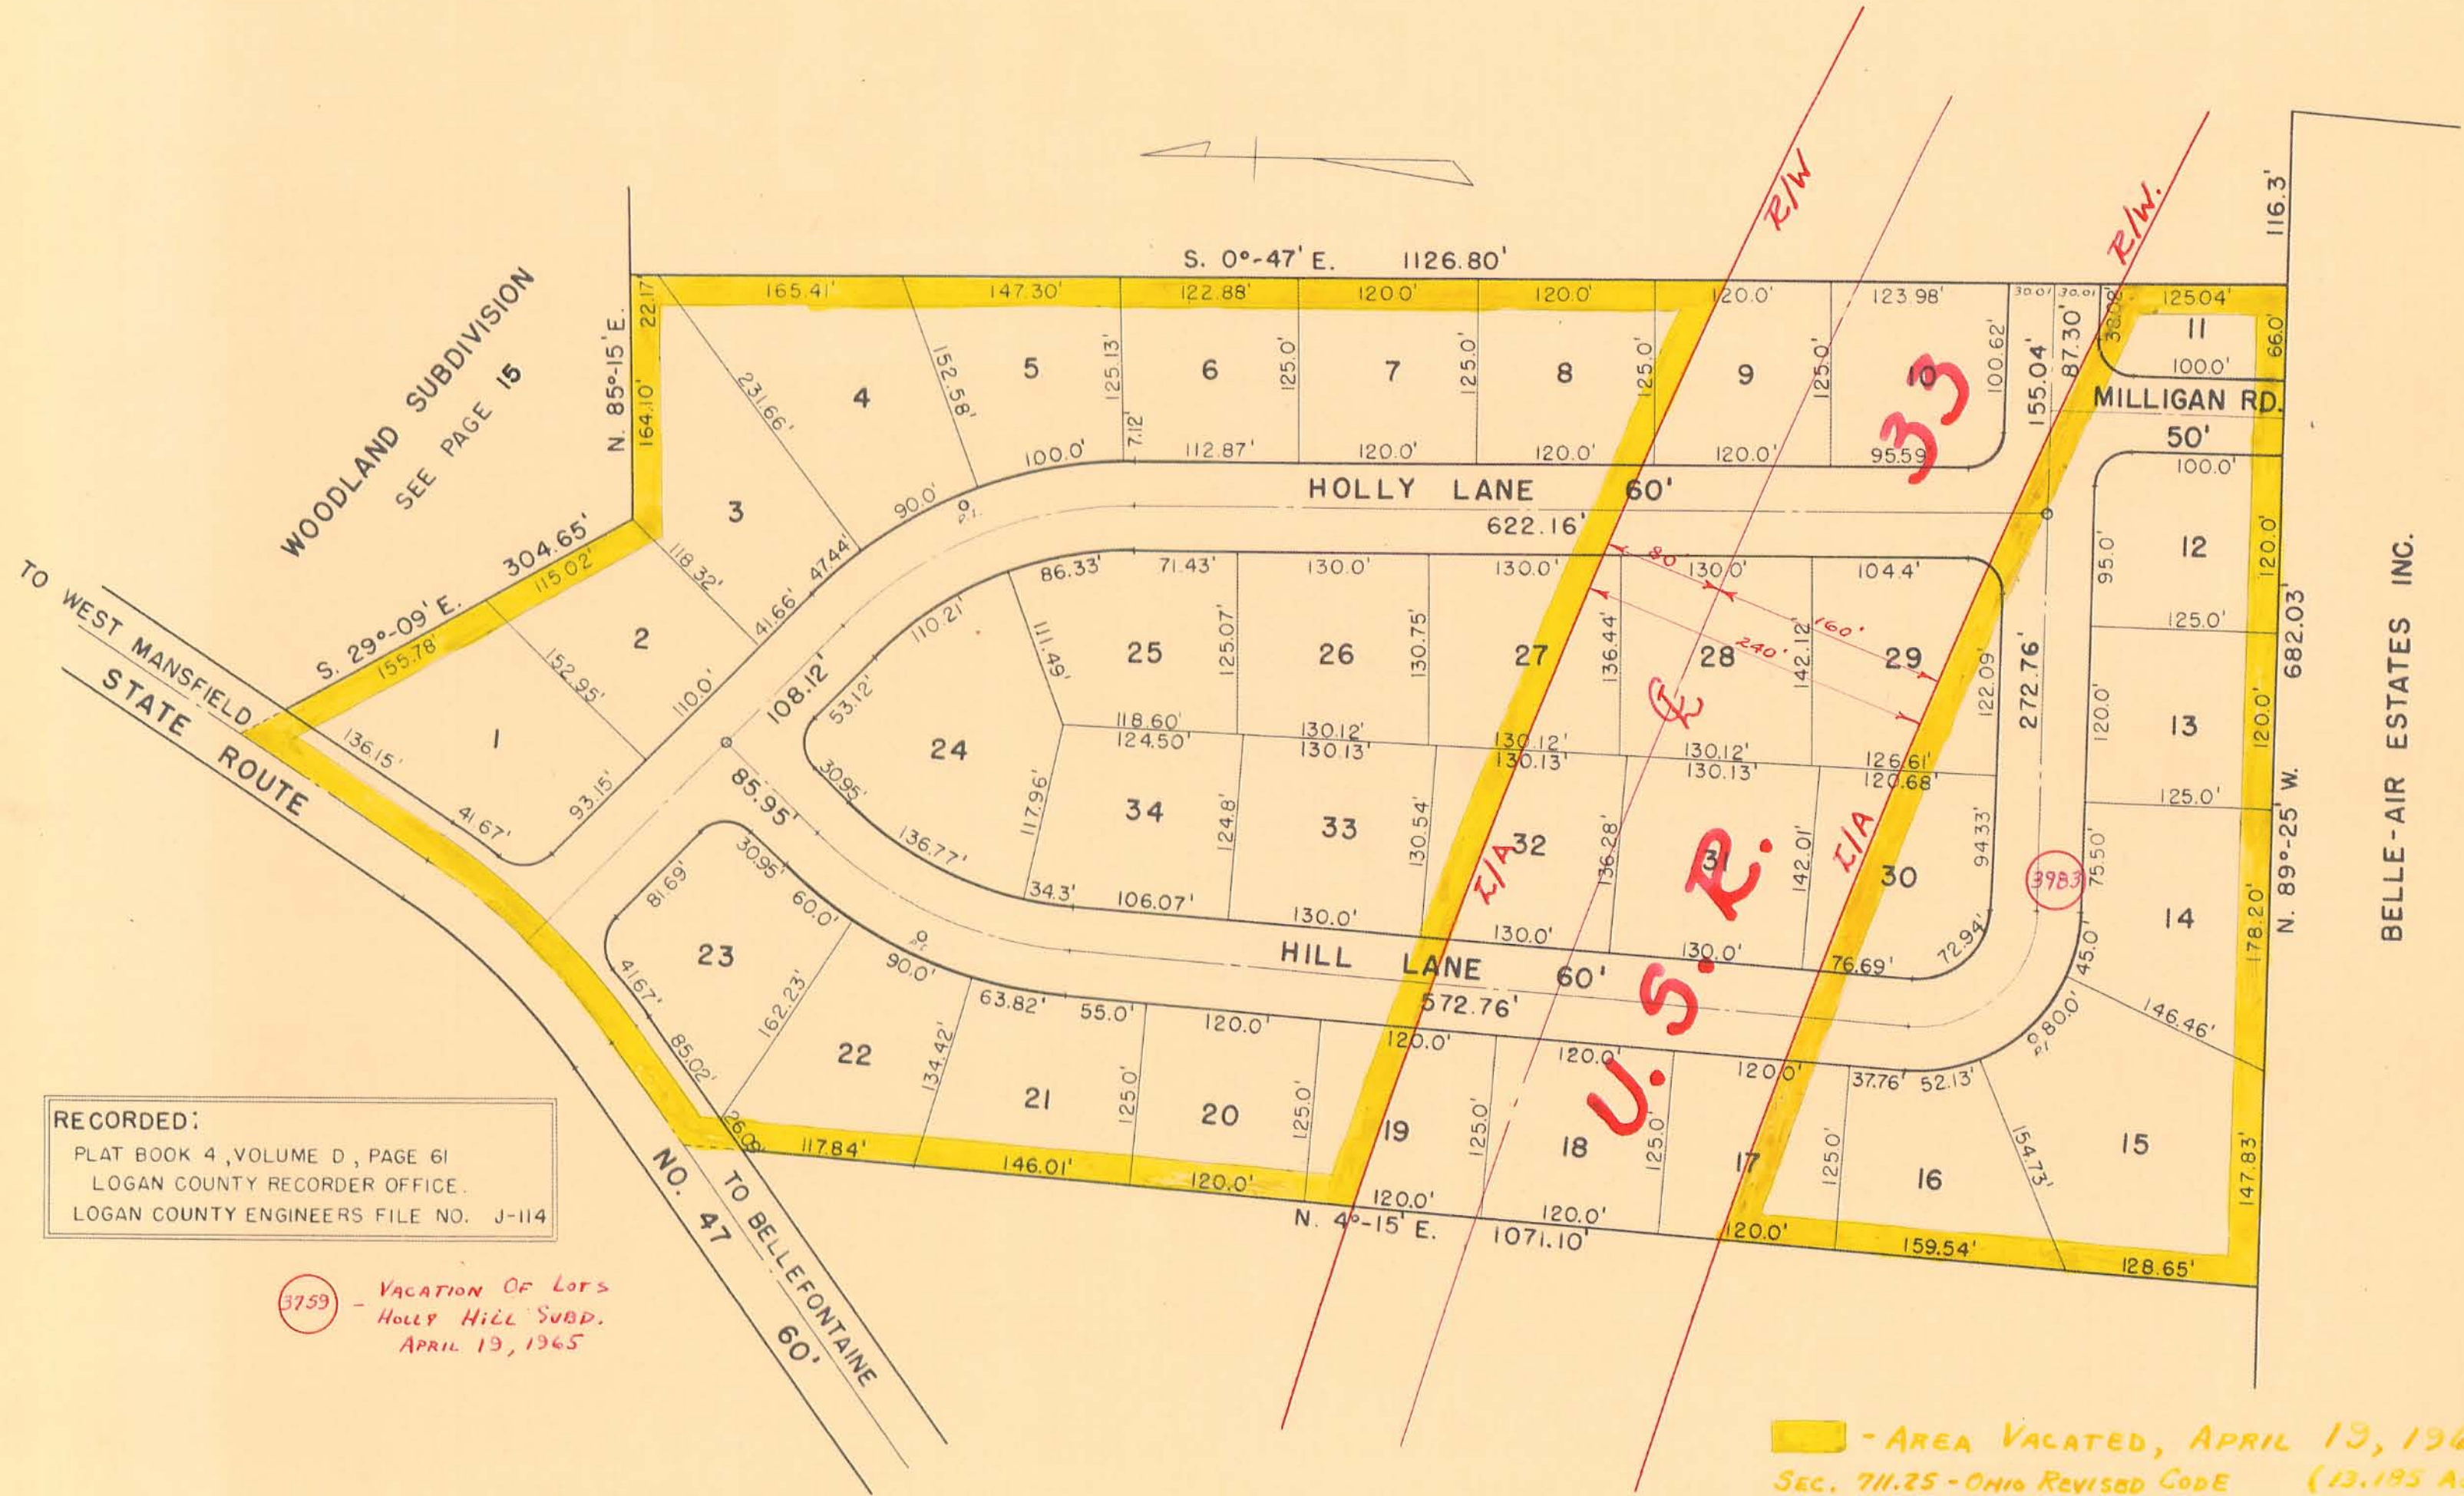

WOODLAND SUBDIVISION
SEE PAGE 15

TO WEST MANSFIELD
STATE ROUTE

RECORDED:
 PLAT BOOK 4, VOLUME D, PAGE 61
 LOGAN COUNTY RECORDER OFFICE.
 LOGAN COUNTY ENGINEERS FILE NO. J-114

3759 - VACATION OF LOTS
 HOLLY HILL SUBD.
 APRIL 19, 1965

NO. 47
 TO BELLEFONTAINE
 60'

■ - AREA VACATED, APRIL 19, 1965
 SEC. 711.25 - OHIO REVISED CODE (13.195 AC.)
 ■ - U.S.R. 33-10.85 (3.805 AC.) - 1965

BELLE-AIR ESTATES INC.