


MCARTHUR TOWNSHIP

V.M.S 10306 & 10307

SCALE: 1" = 10 CHAINS = 660'

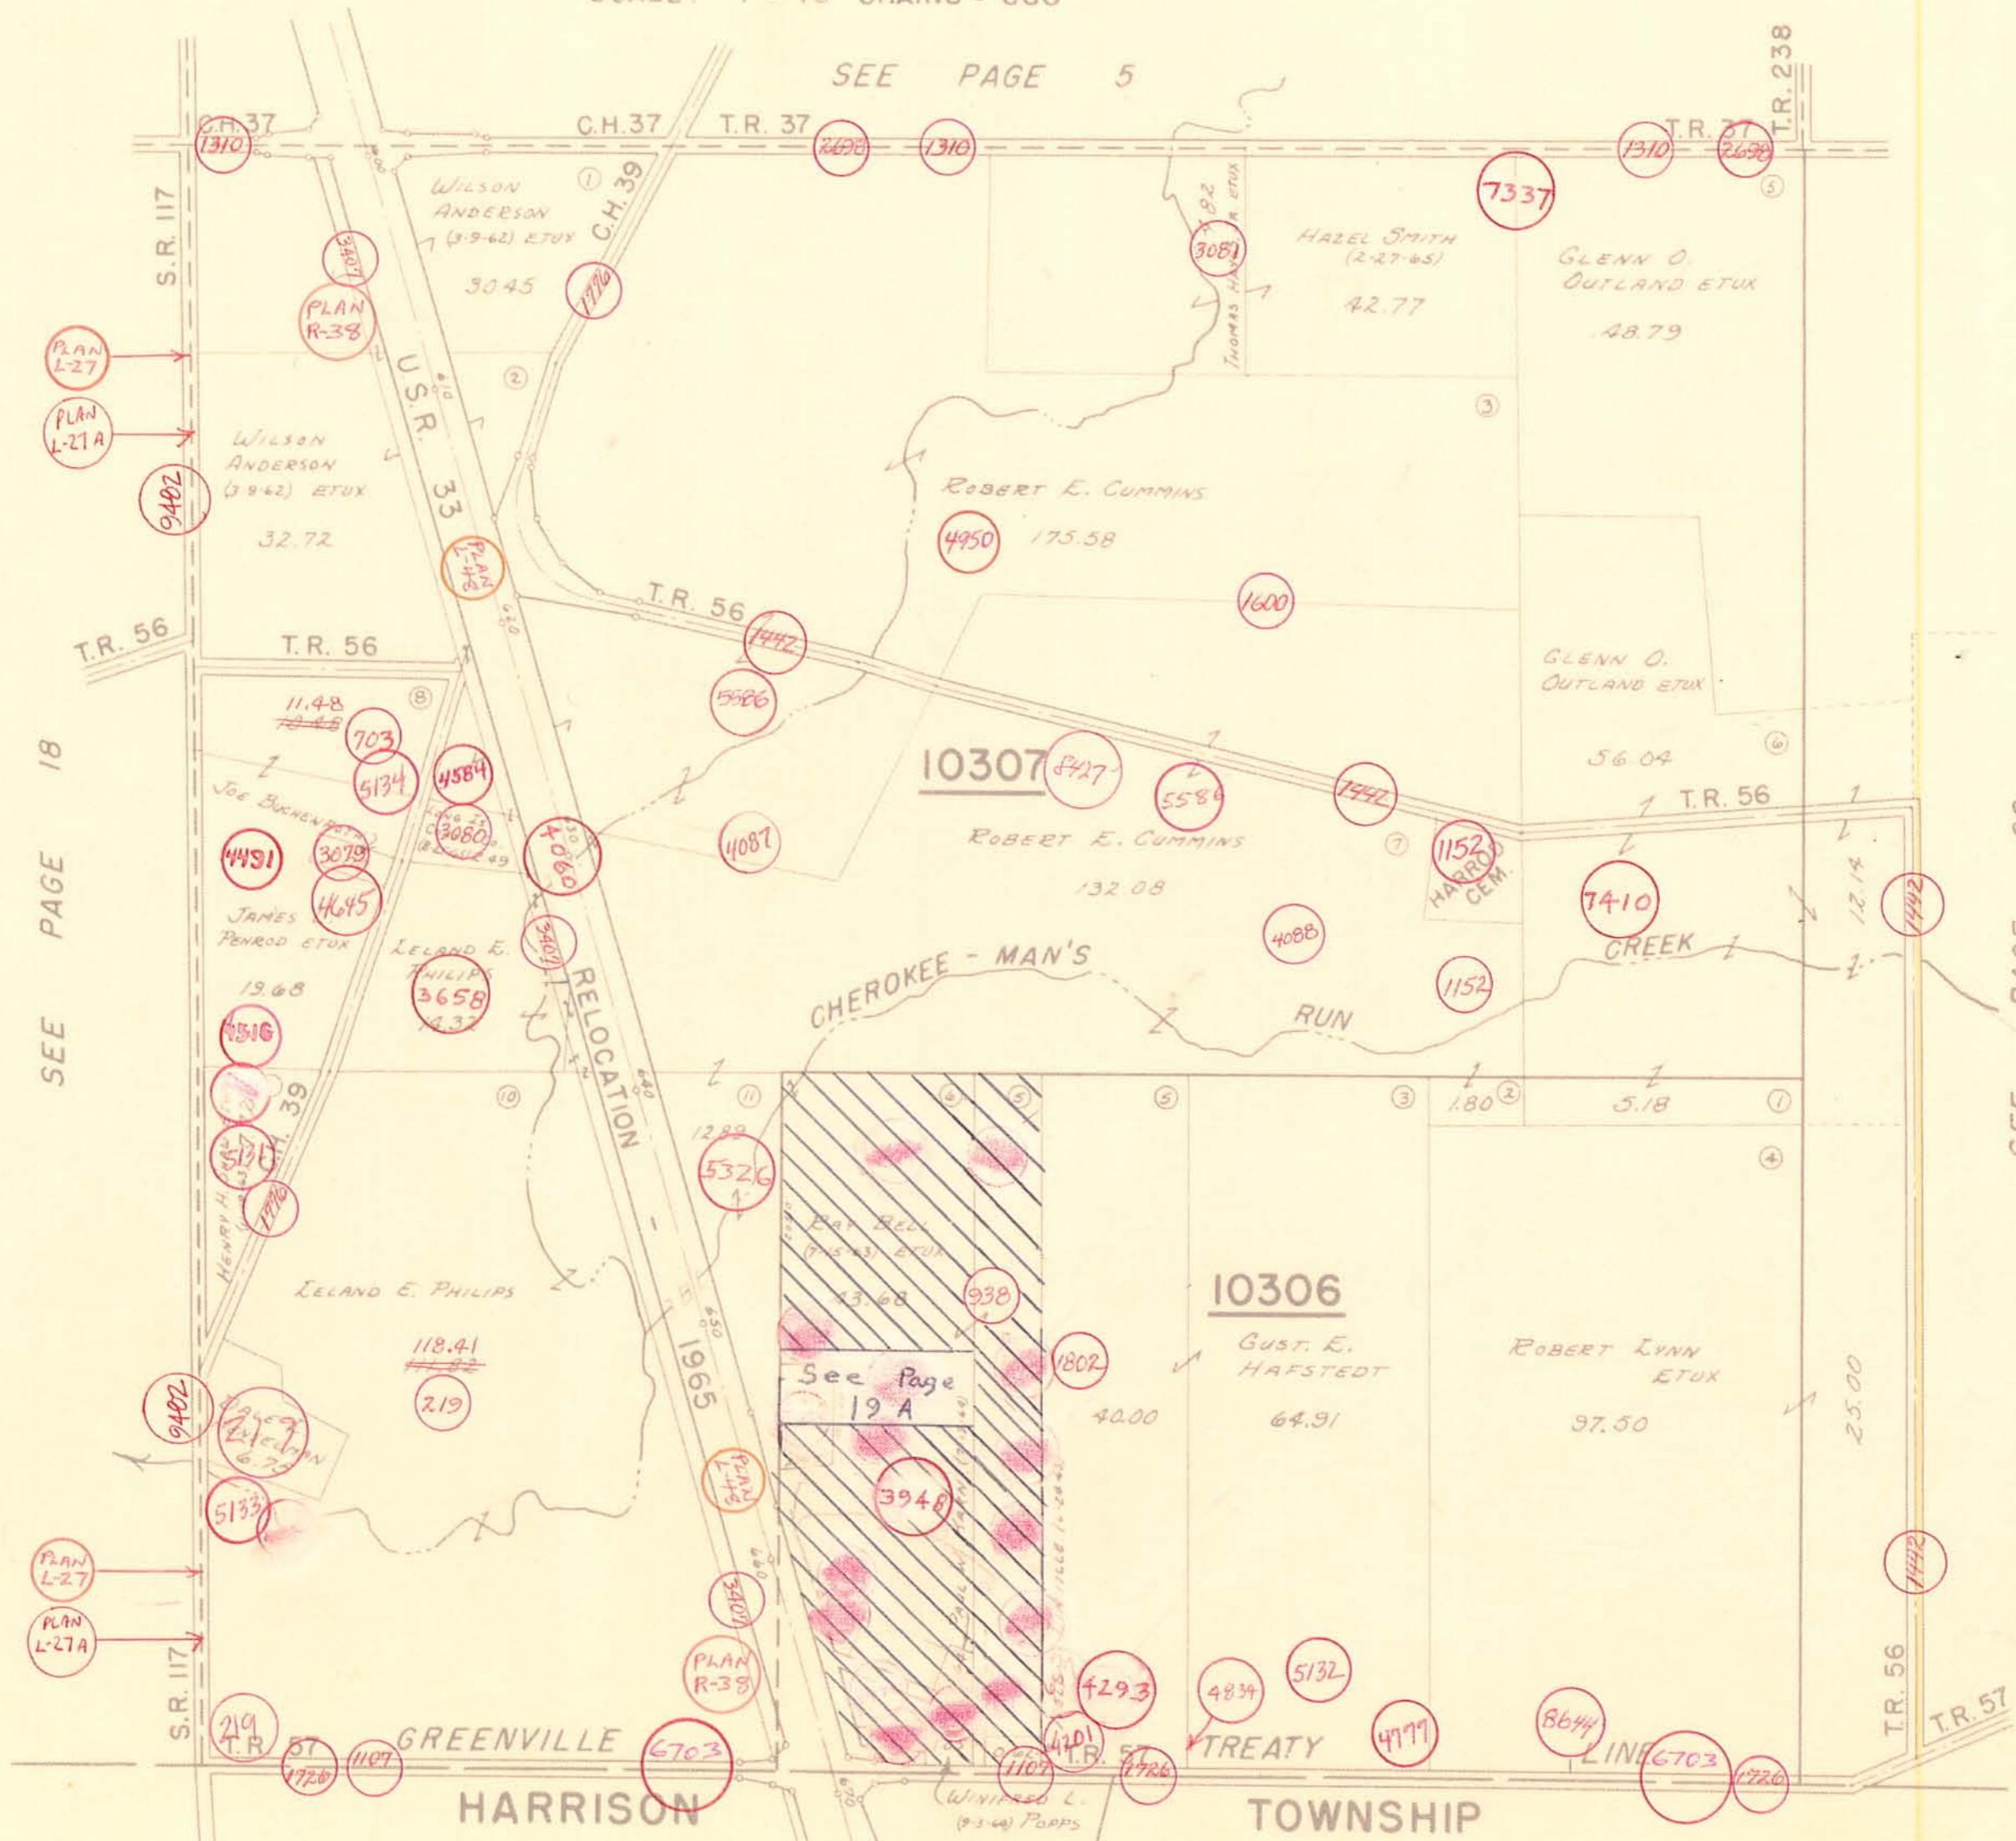

SEE PAGE 5

SEE PAGE 18

SEE PAGE 20

See Page 19 A

Drawn: MARCH 23, 1964
DANIEL E. GILBER

SEE HARRISON TOWNSHIP PAGE 23

SEE HARRISON TOWNSHIP PAGE 22