


SECTION 20 TOWN 1 RANGE 8

SECTION 21 TOWN 1 RANGE 8

SCALE 10 CHAINS TO THE INCH

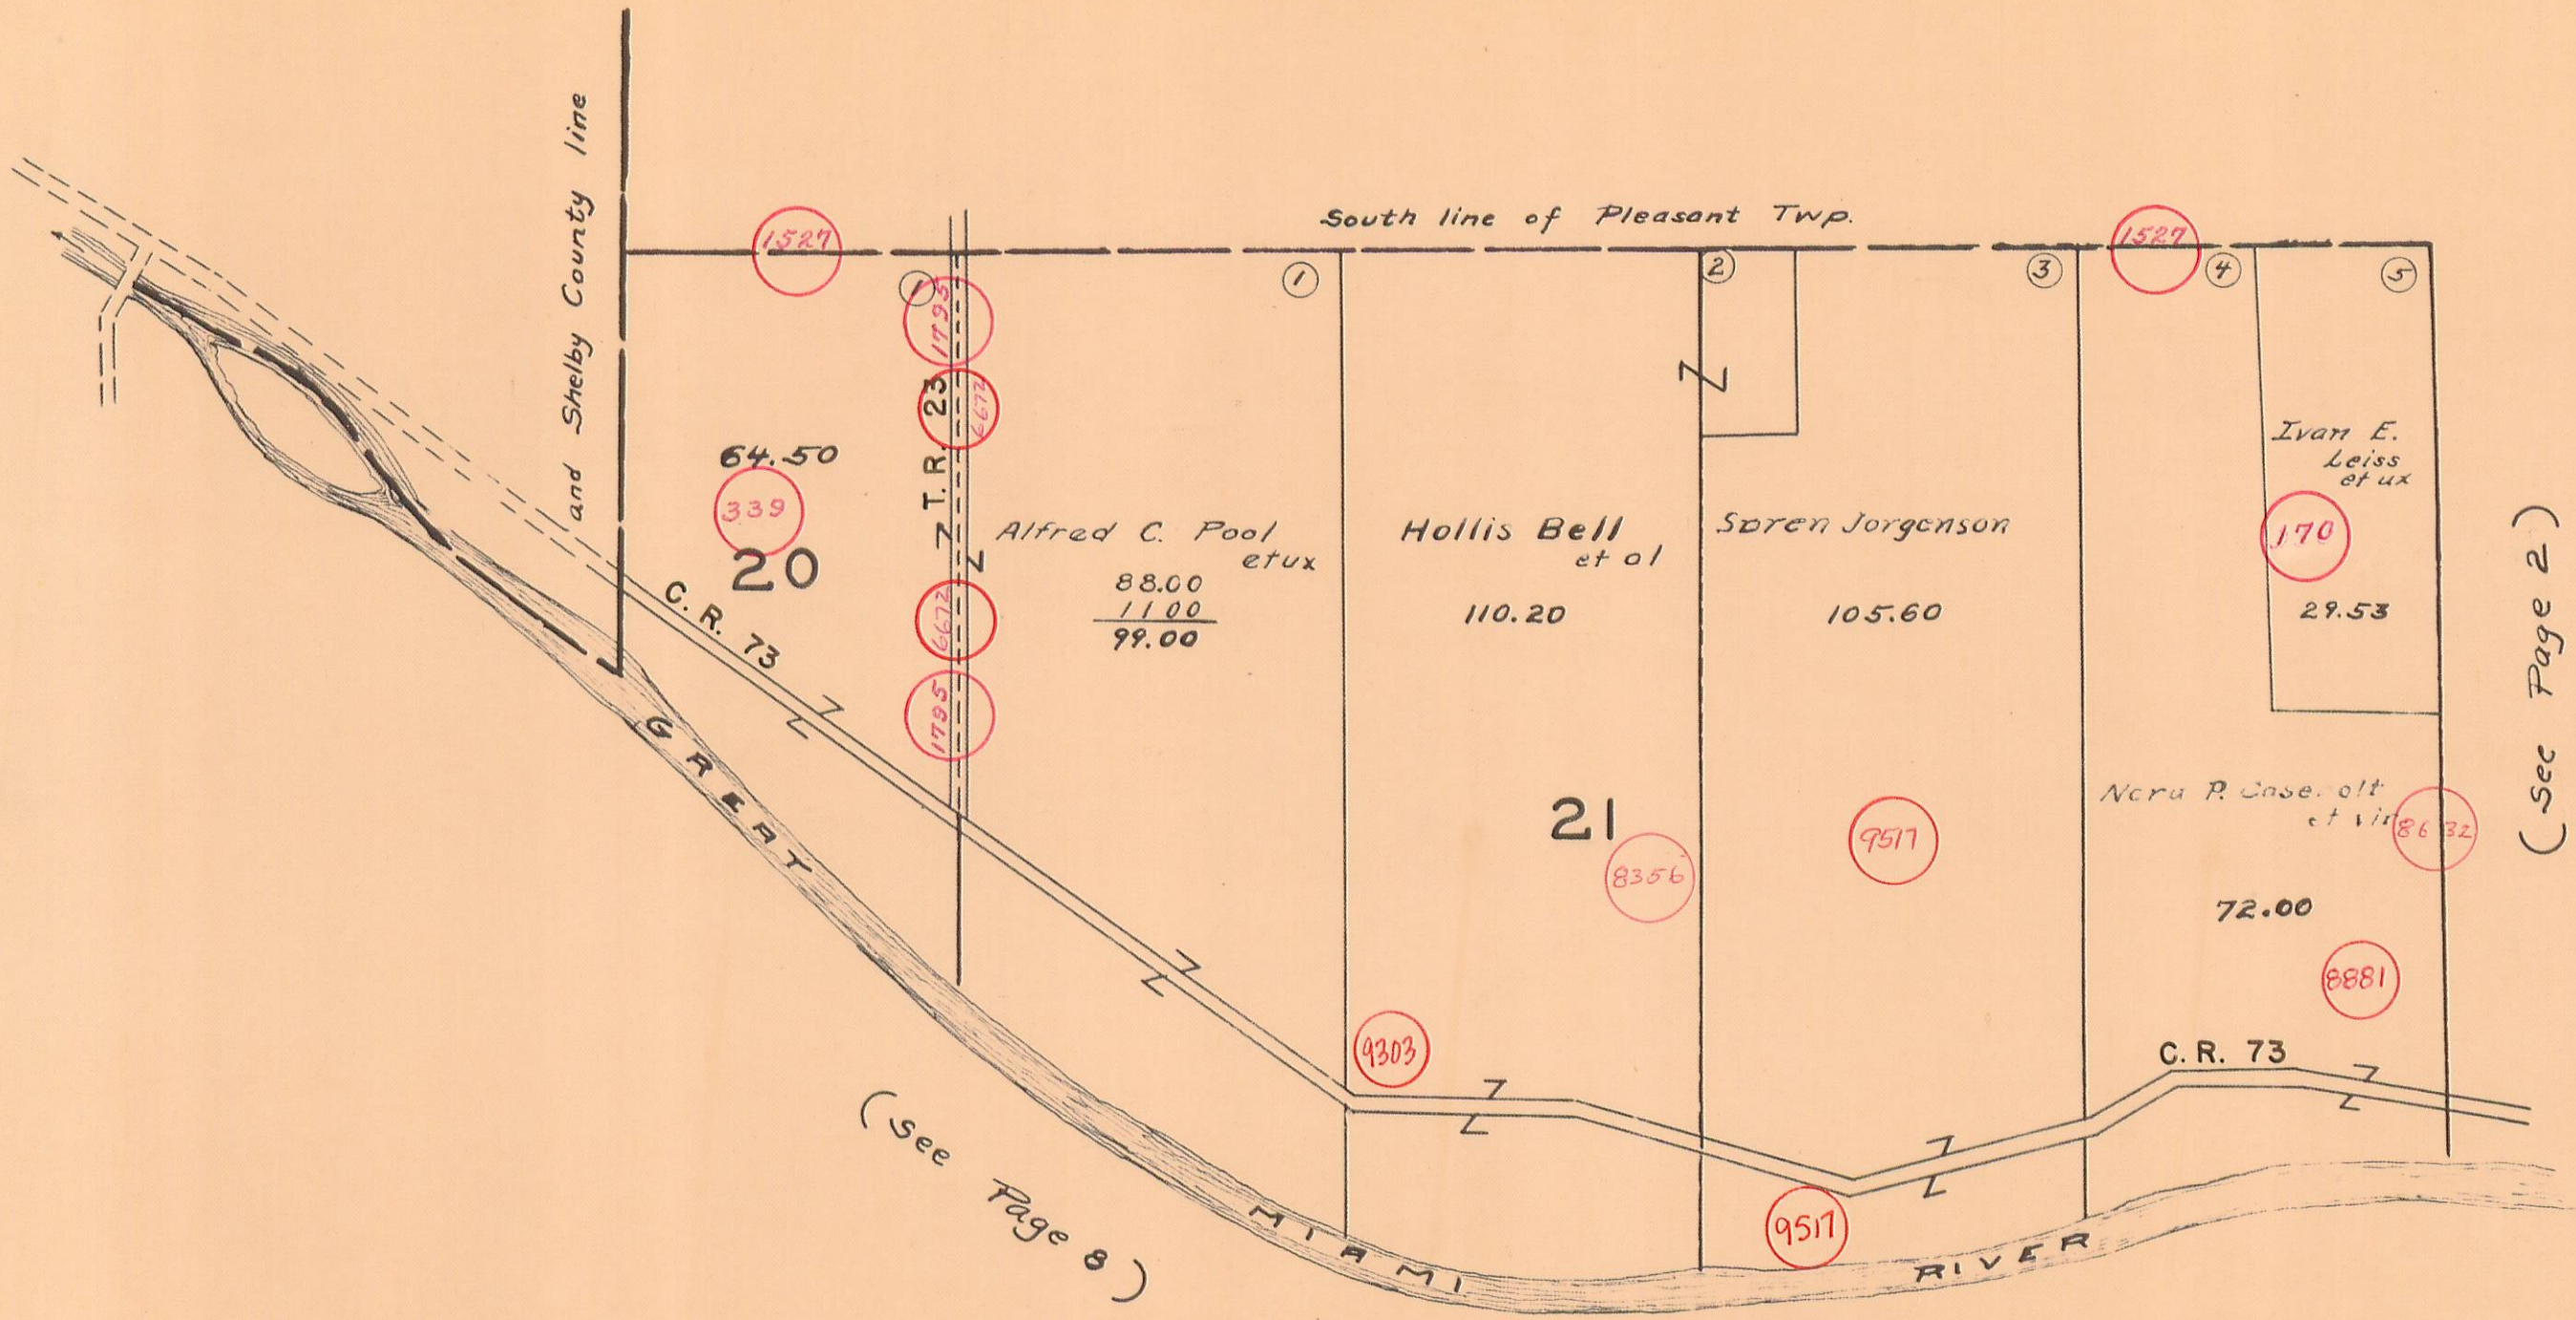

(See Page 8)

(See Page 9)

(See Page 2)