


MIAMI TOWNSHIP
SECTION 35 TOWN 3 RANGE 13

SCALE 10 CHAINS TO THE INCH

(See Page 8)

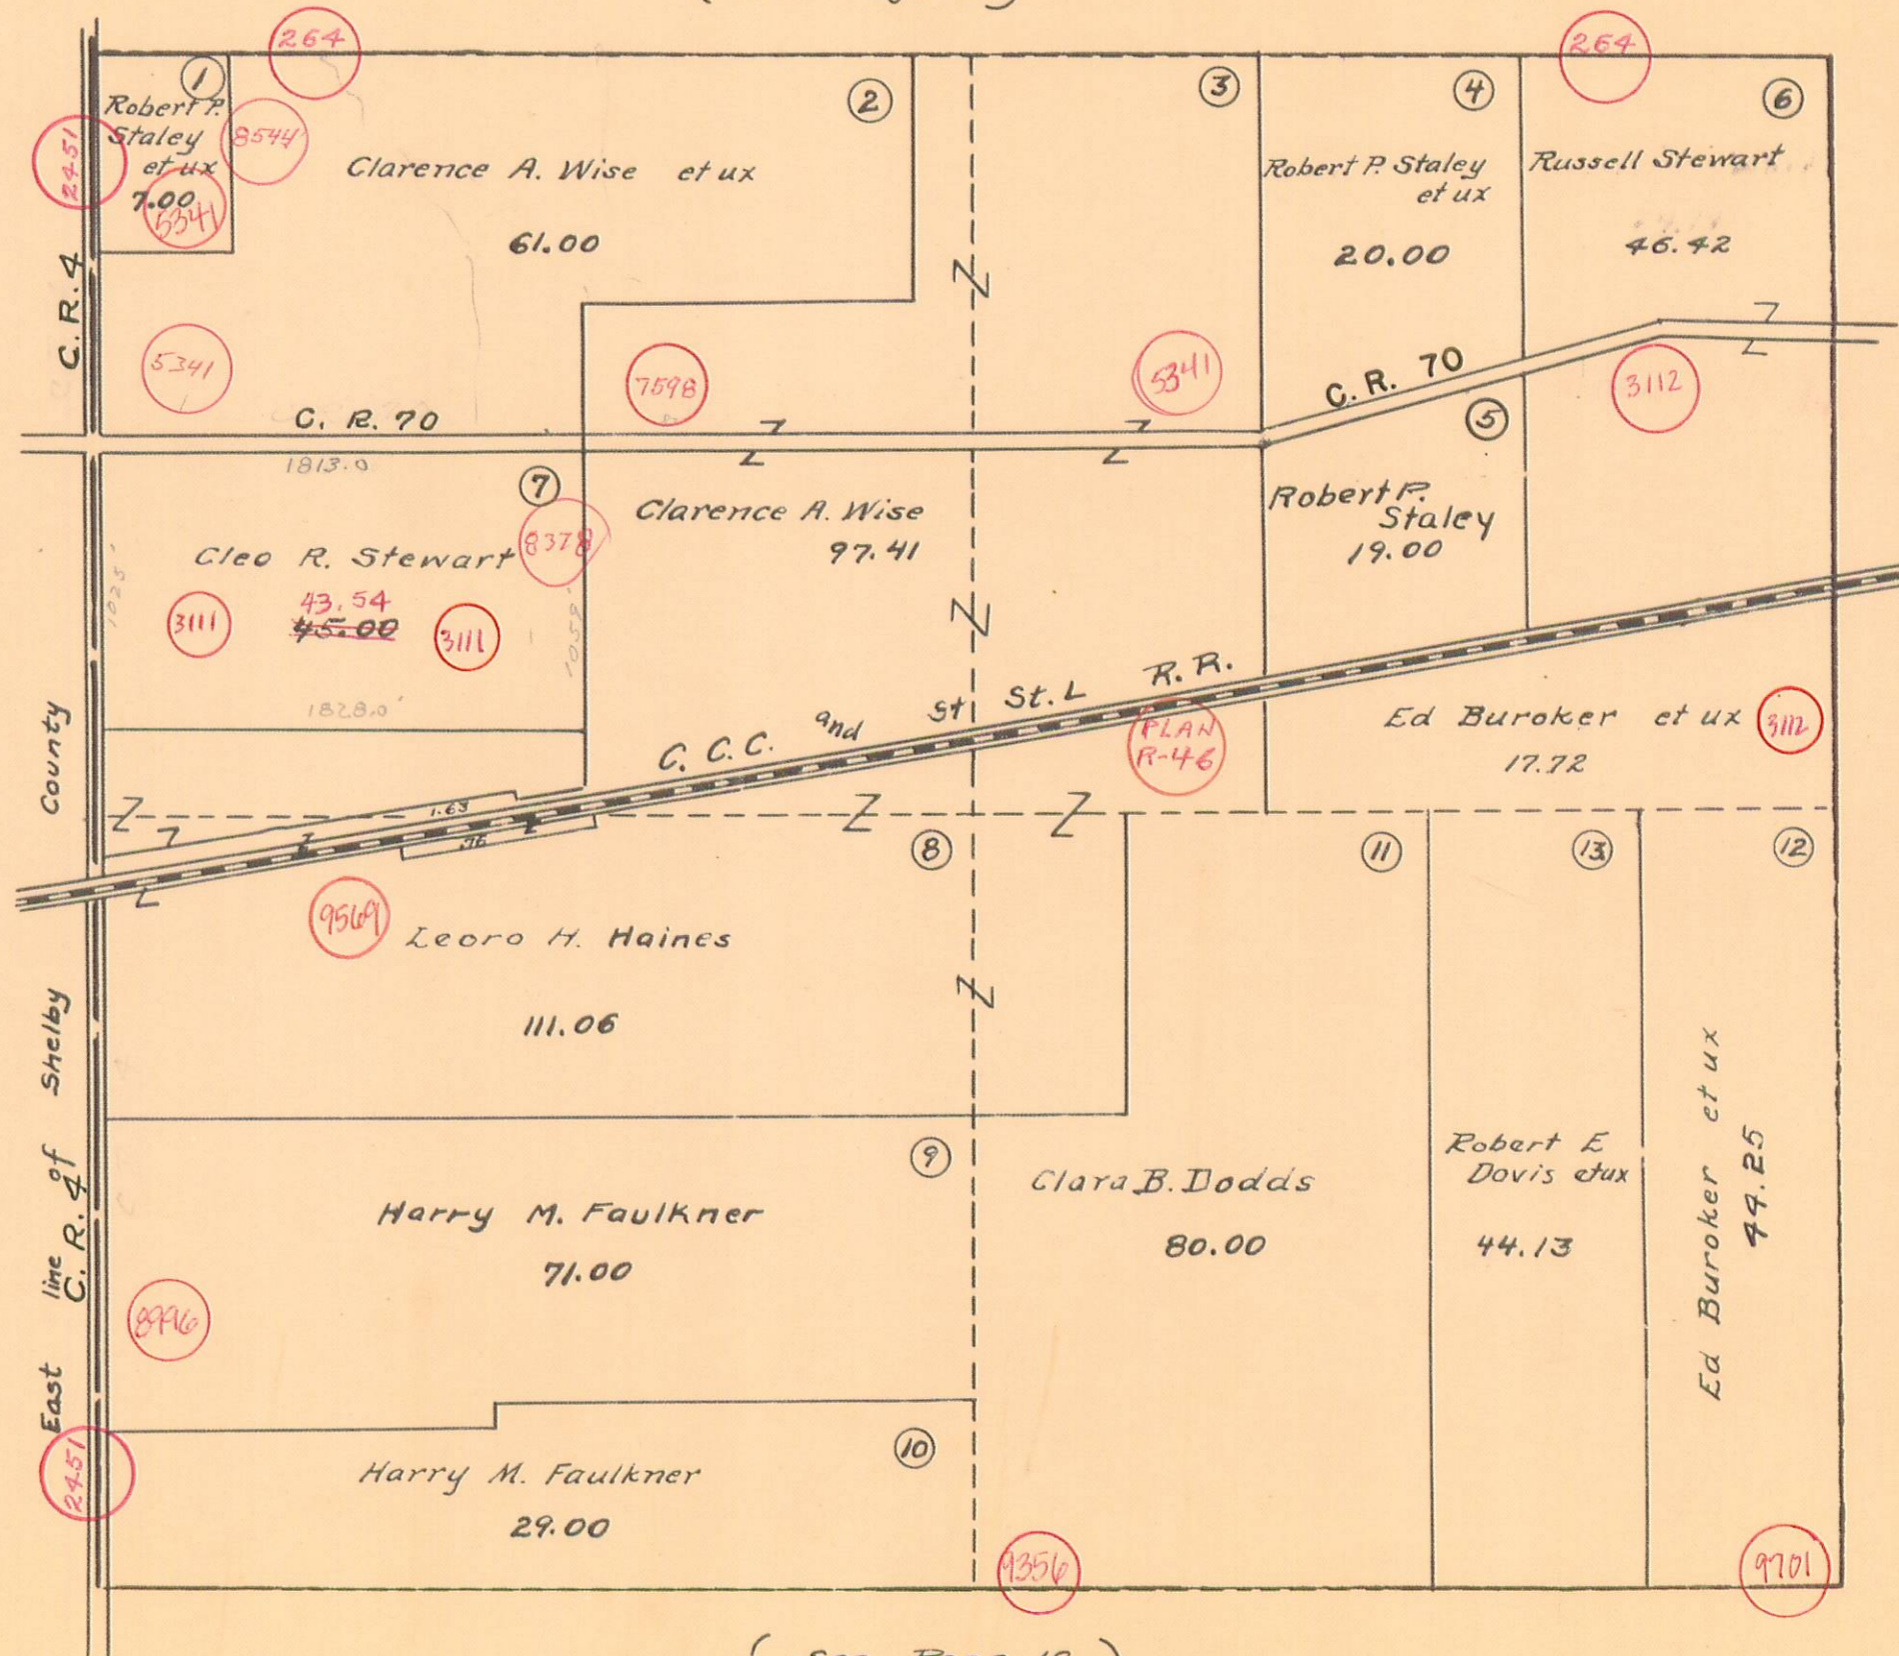

(See Page 11)

(See Page 18)