


MIAMI TOWNSHIP
SECTION 10 TOWN 3 RANGE 13

SCALE 10 CHAINS TO THE INCH

(See Page 15)

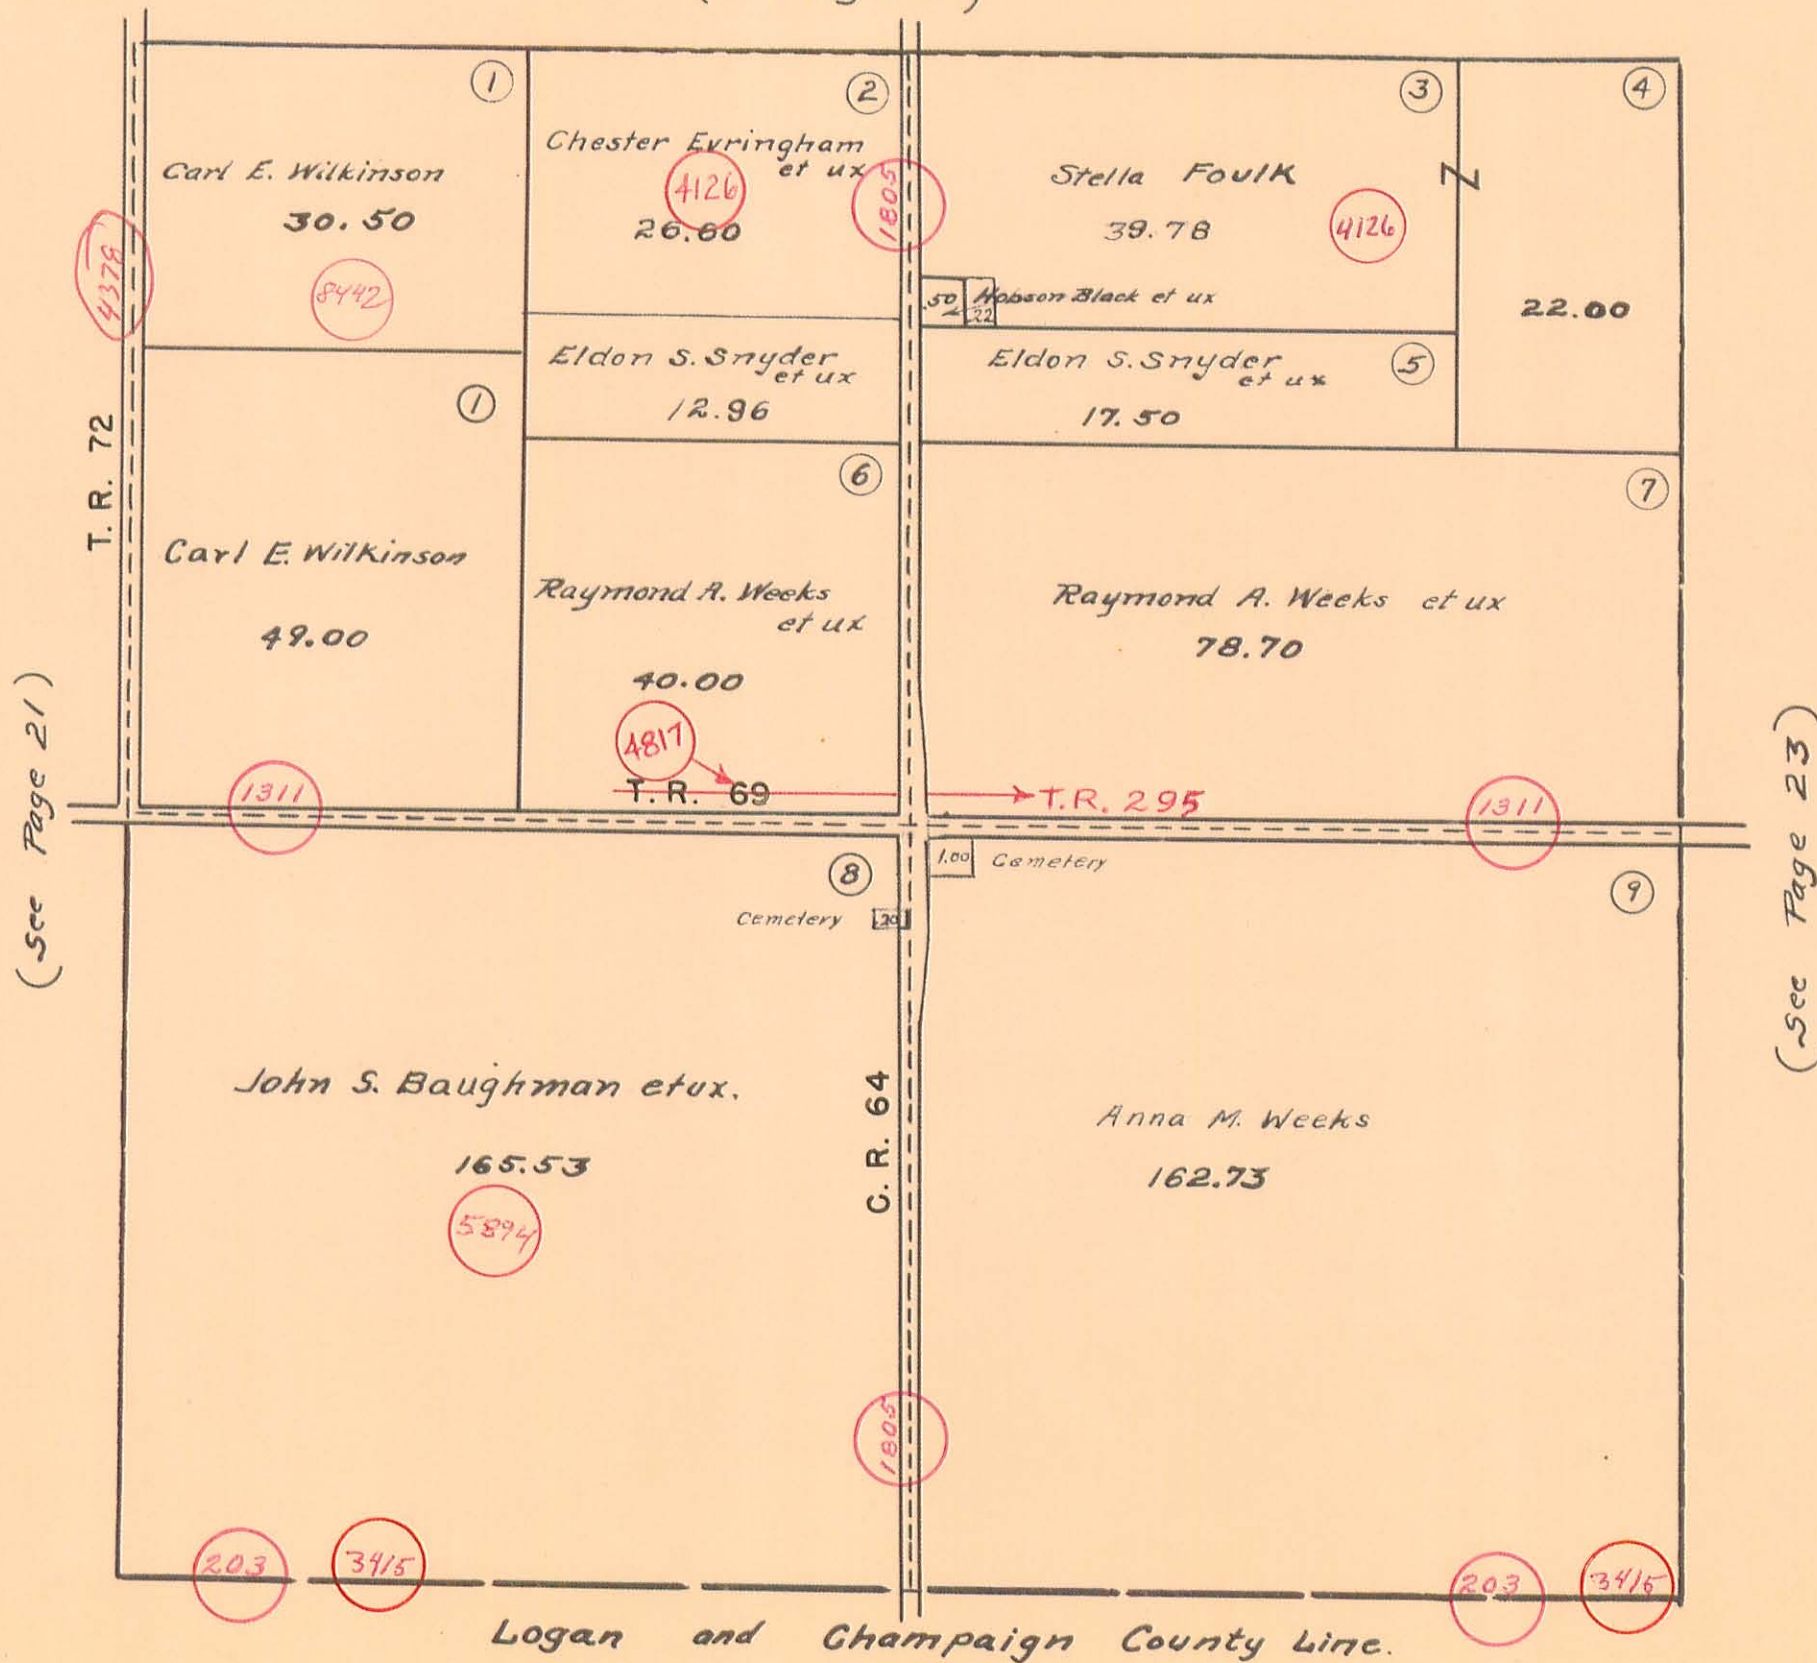

55 W.
1932
G. W. W.
1942