


RICHLAND TOWNSHIP
VIRGINIA MILITARY SURVEY 9950
SCALE 10 CHAINS TO THE INCH

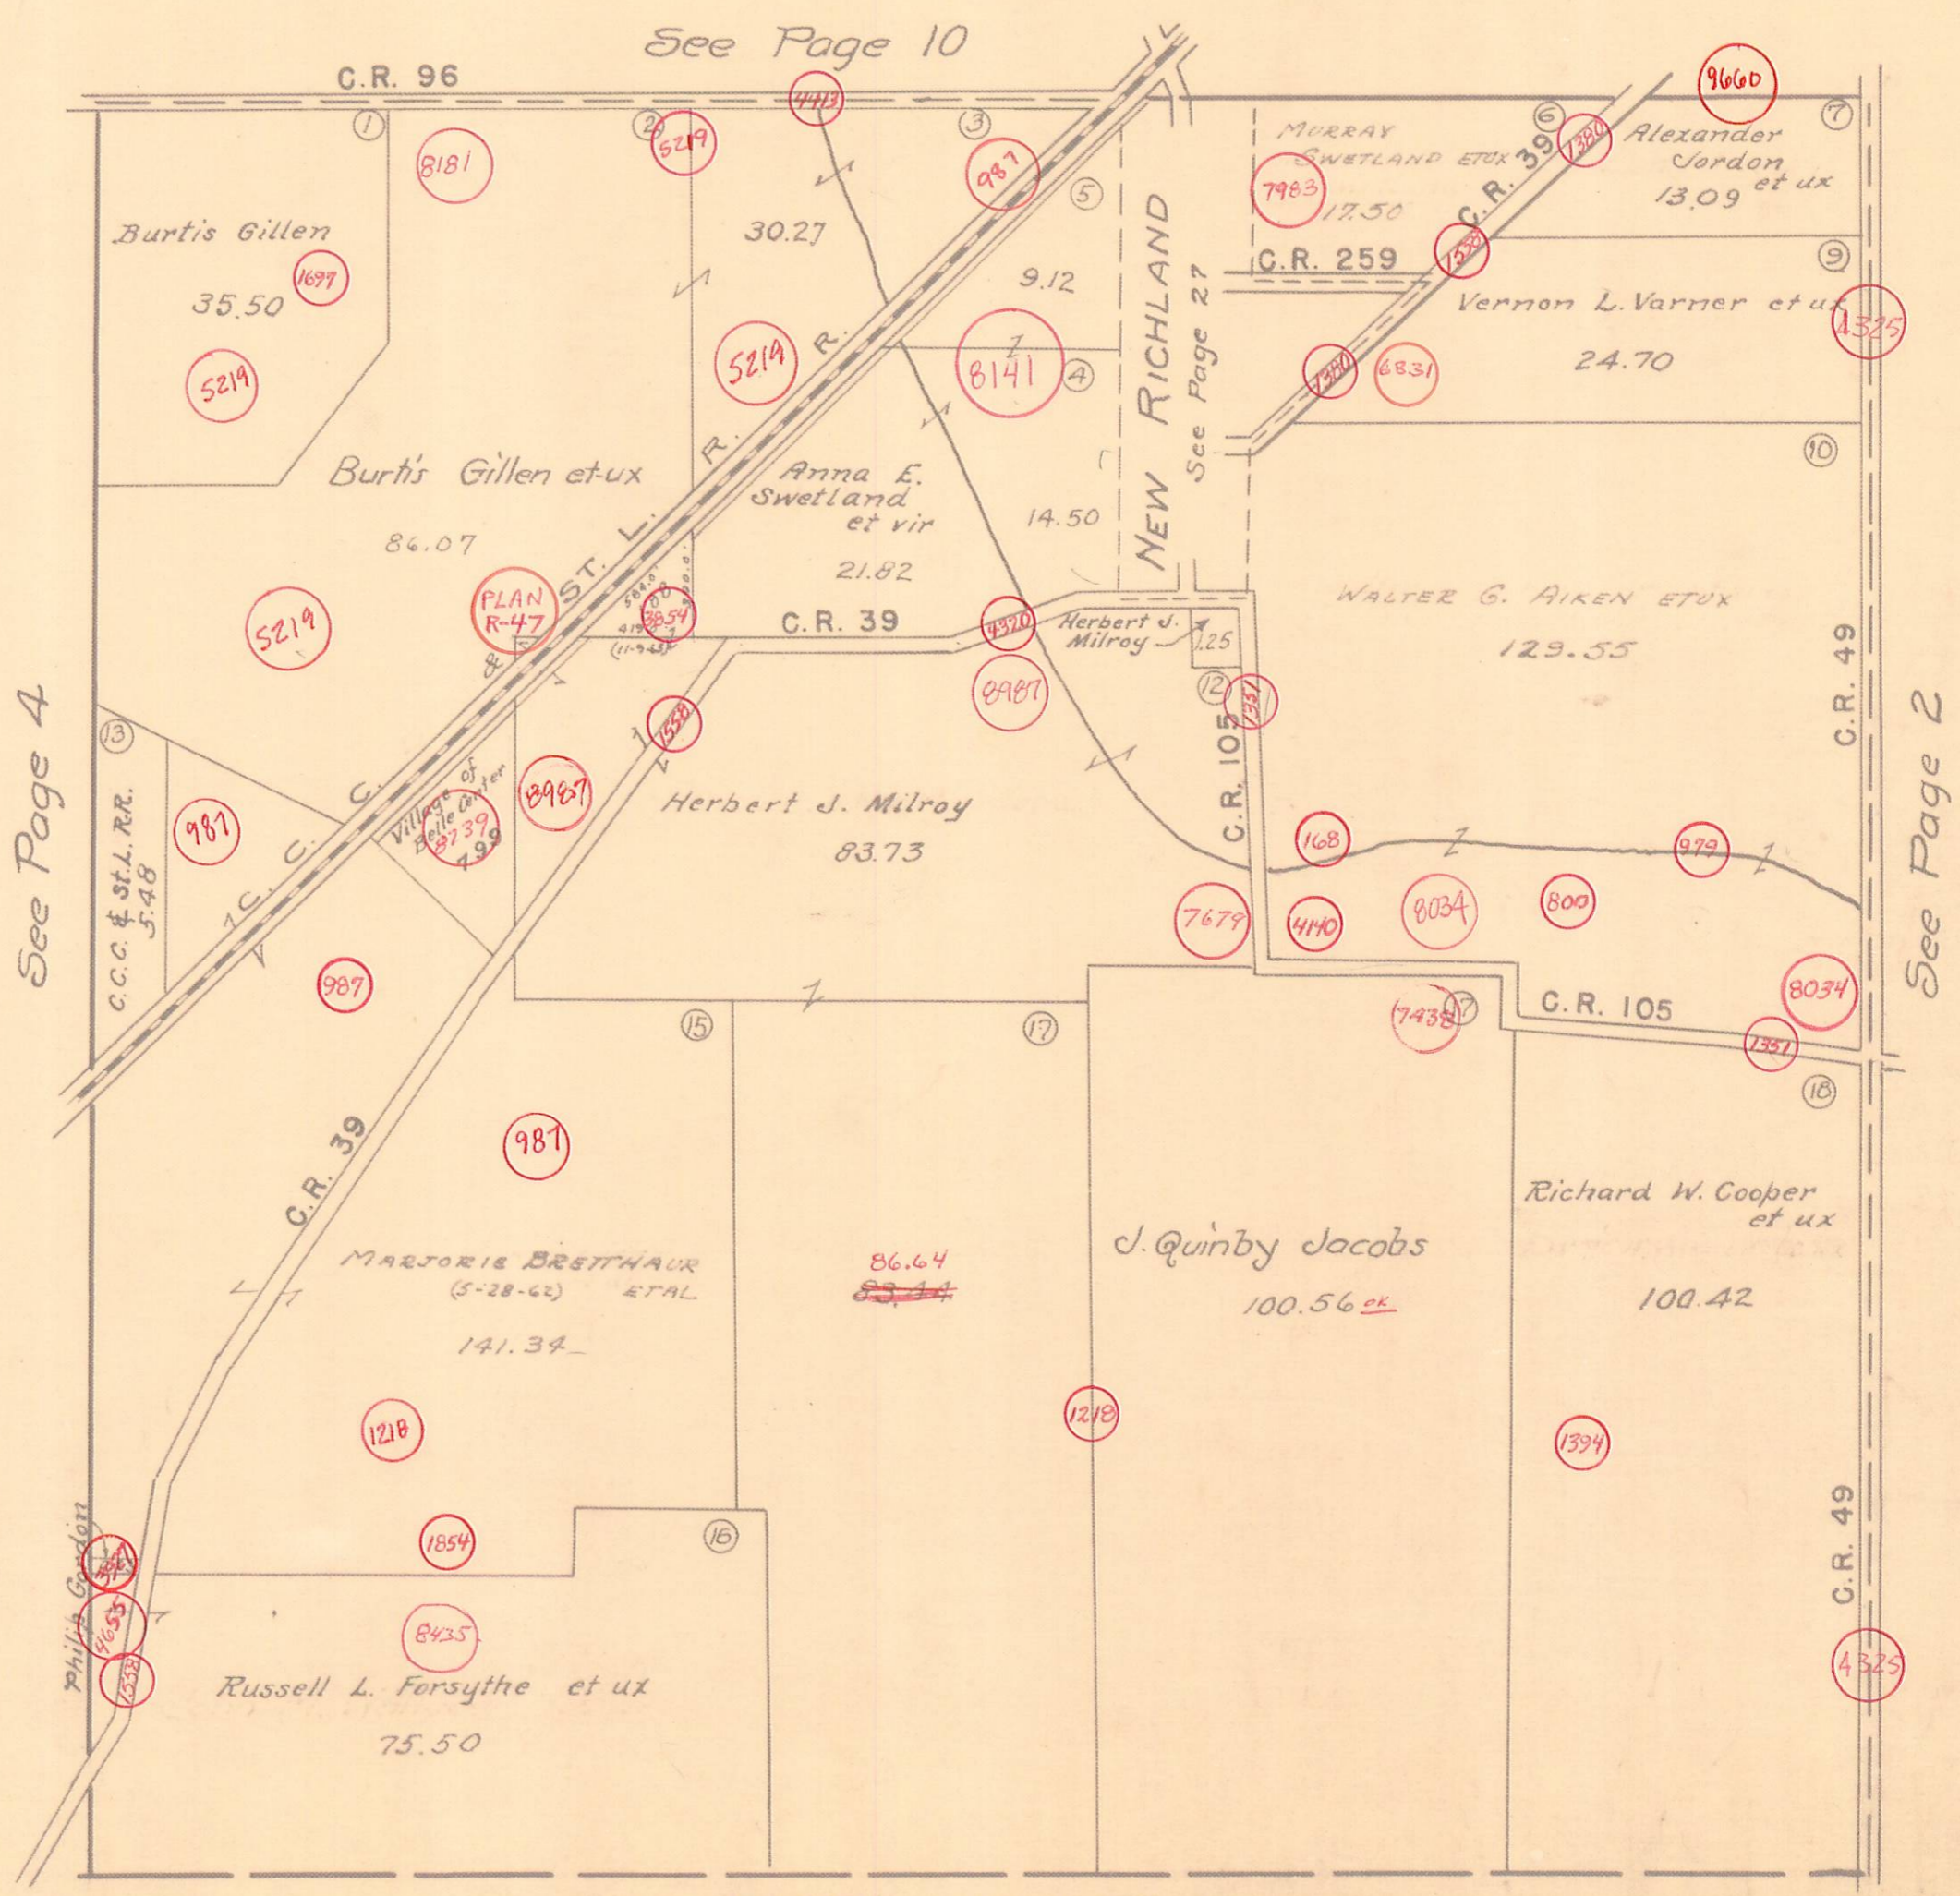

McARTHUR TOWNSHIP

H.S.D.