


RUSHCREEK TOWNSHIP  
 VIRGINIA MILITARY SURVEY 9976

SCALE 10 CHAINS TO THE INCH

(See Page 3)

(See Page 5)

(See Page 7)

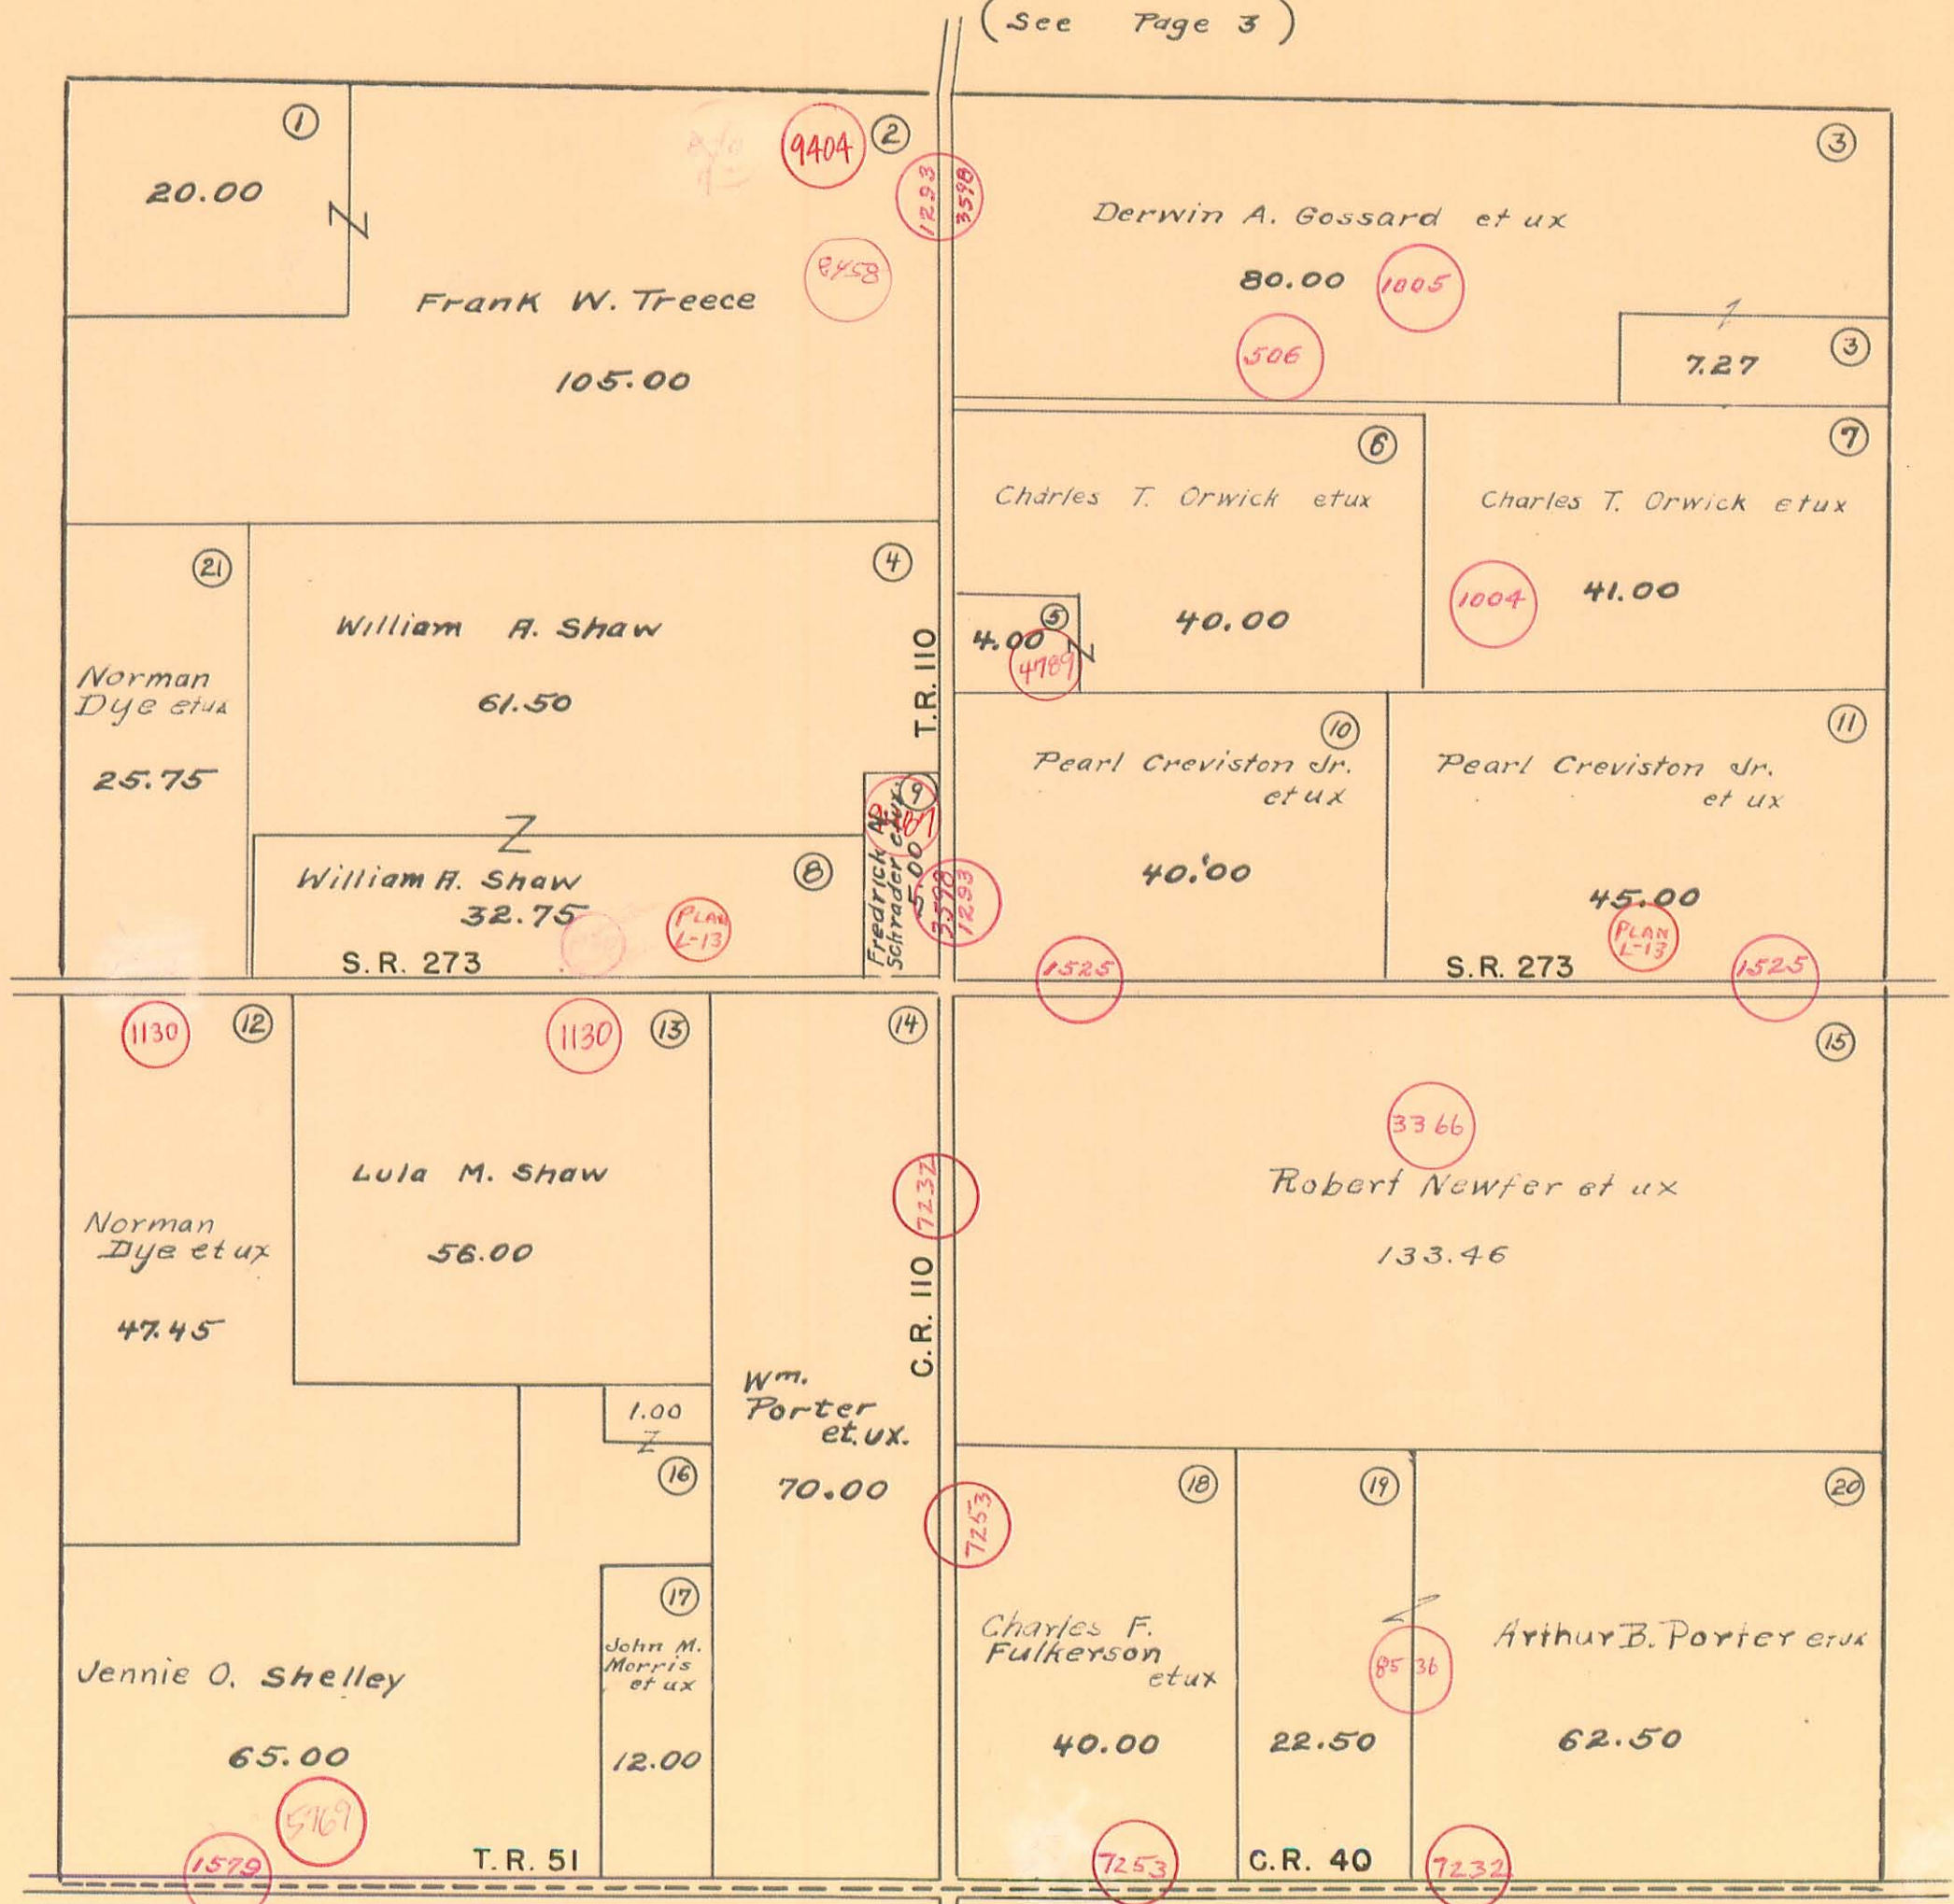

(See Page 11)