


RUSHCREEK TOWNSHIP
VIRGINIA MILITARY SURVEY 9954

SCALE 10 CHAINS TO THE INCH

(See Page 5)

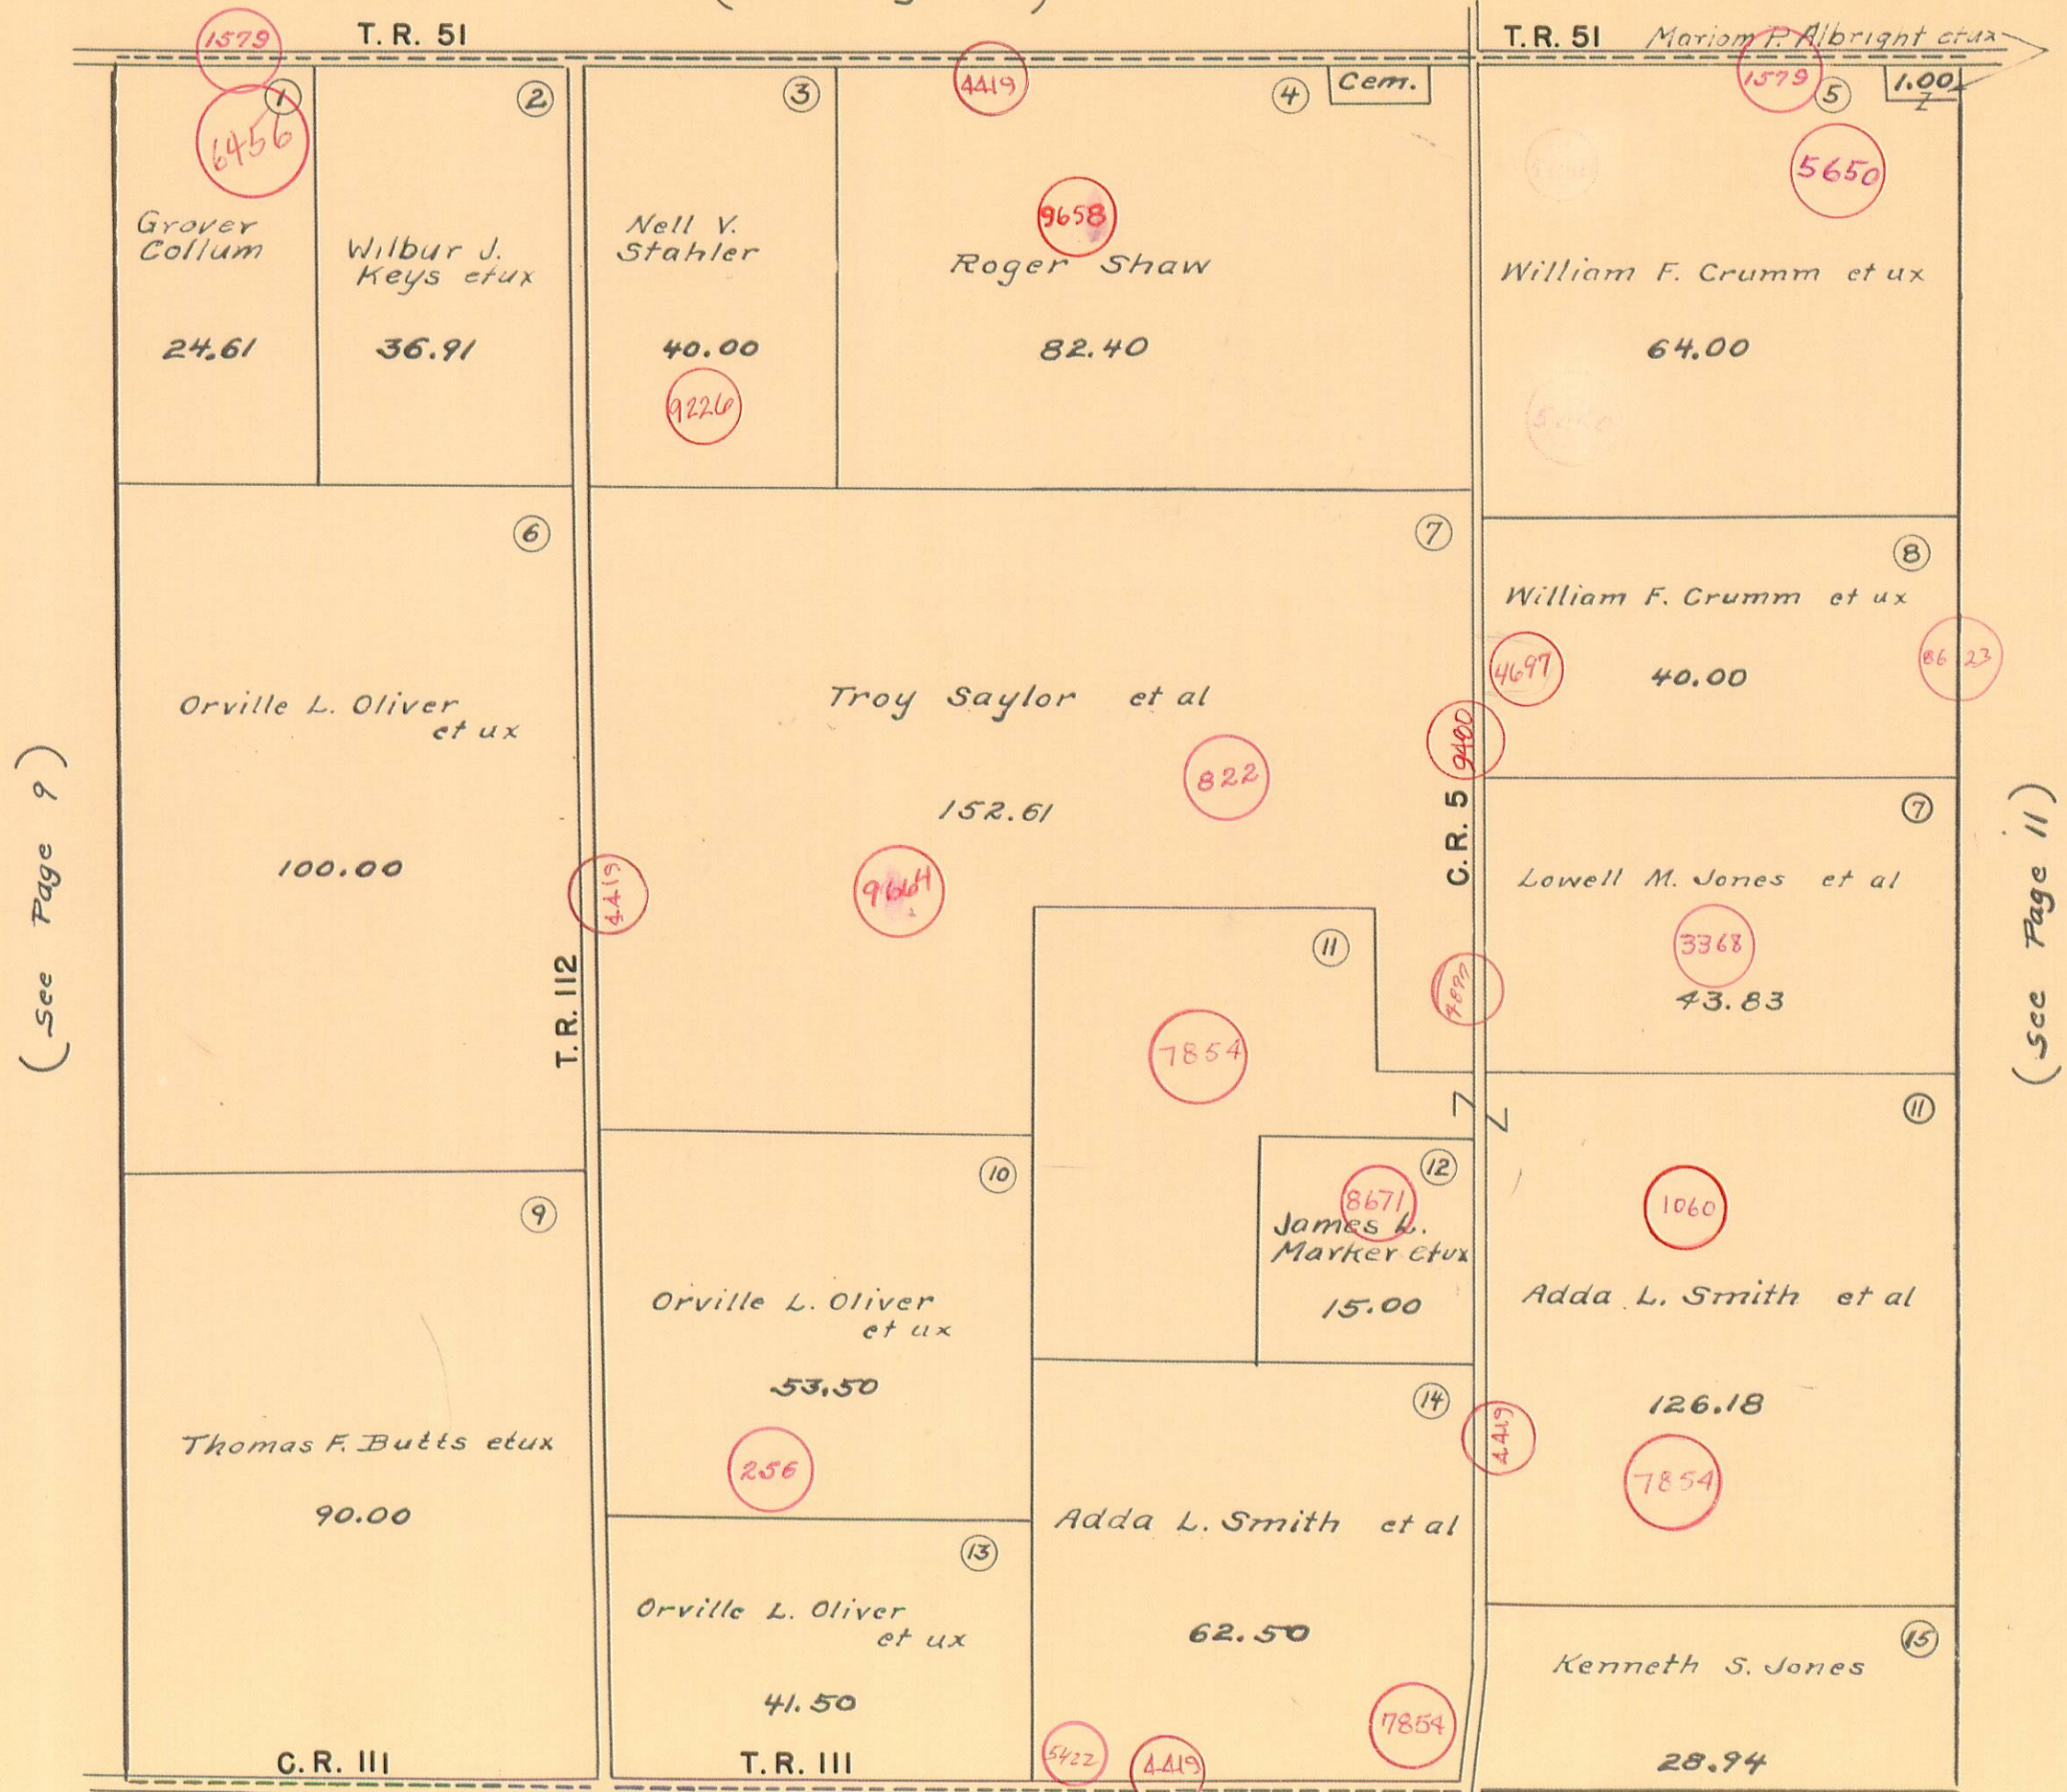

(See Page 9)

(See Page 11)

(See Page 16)