


STOKES TOWNSHIP
SECTION 18 TOWN 6 S. RANGE 8 E.

SCALE 10 CHAINS TO THE INCH

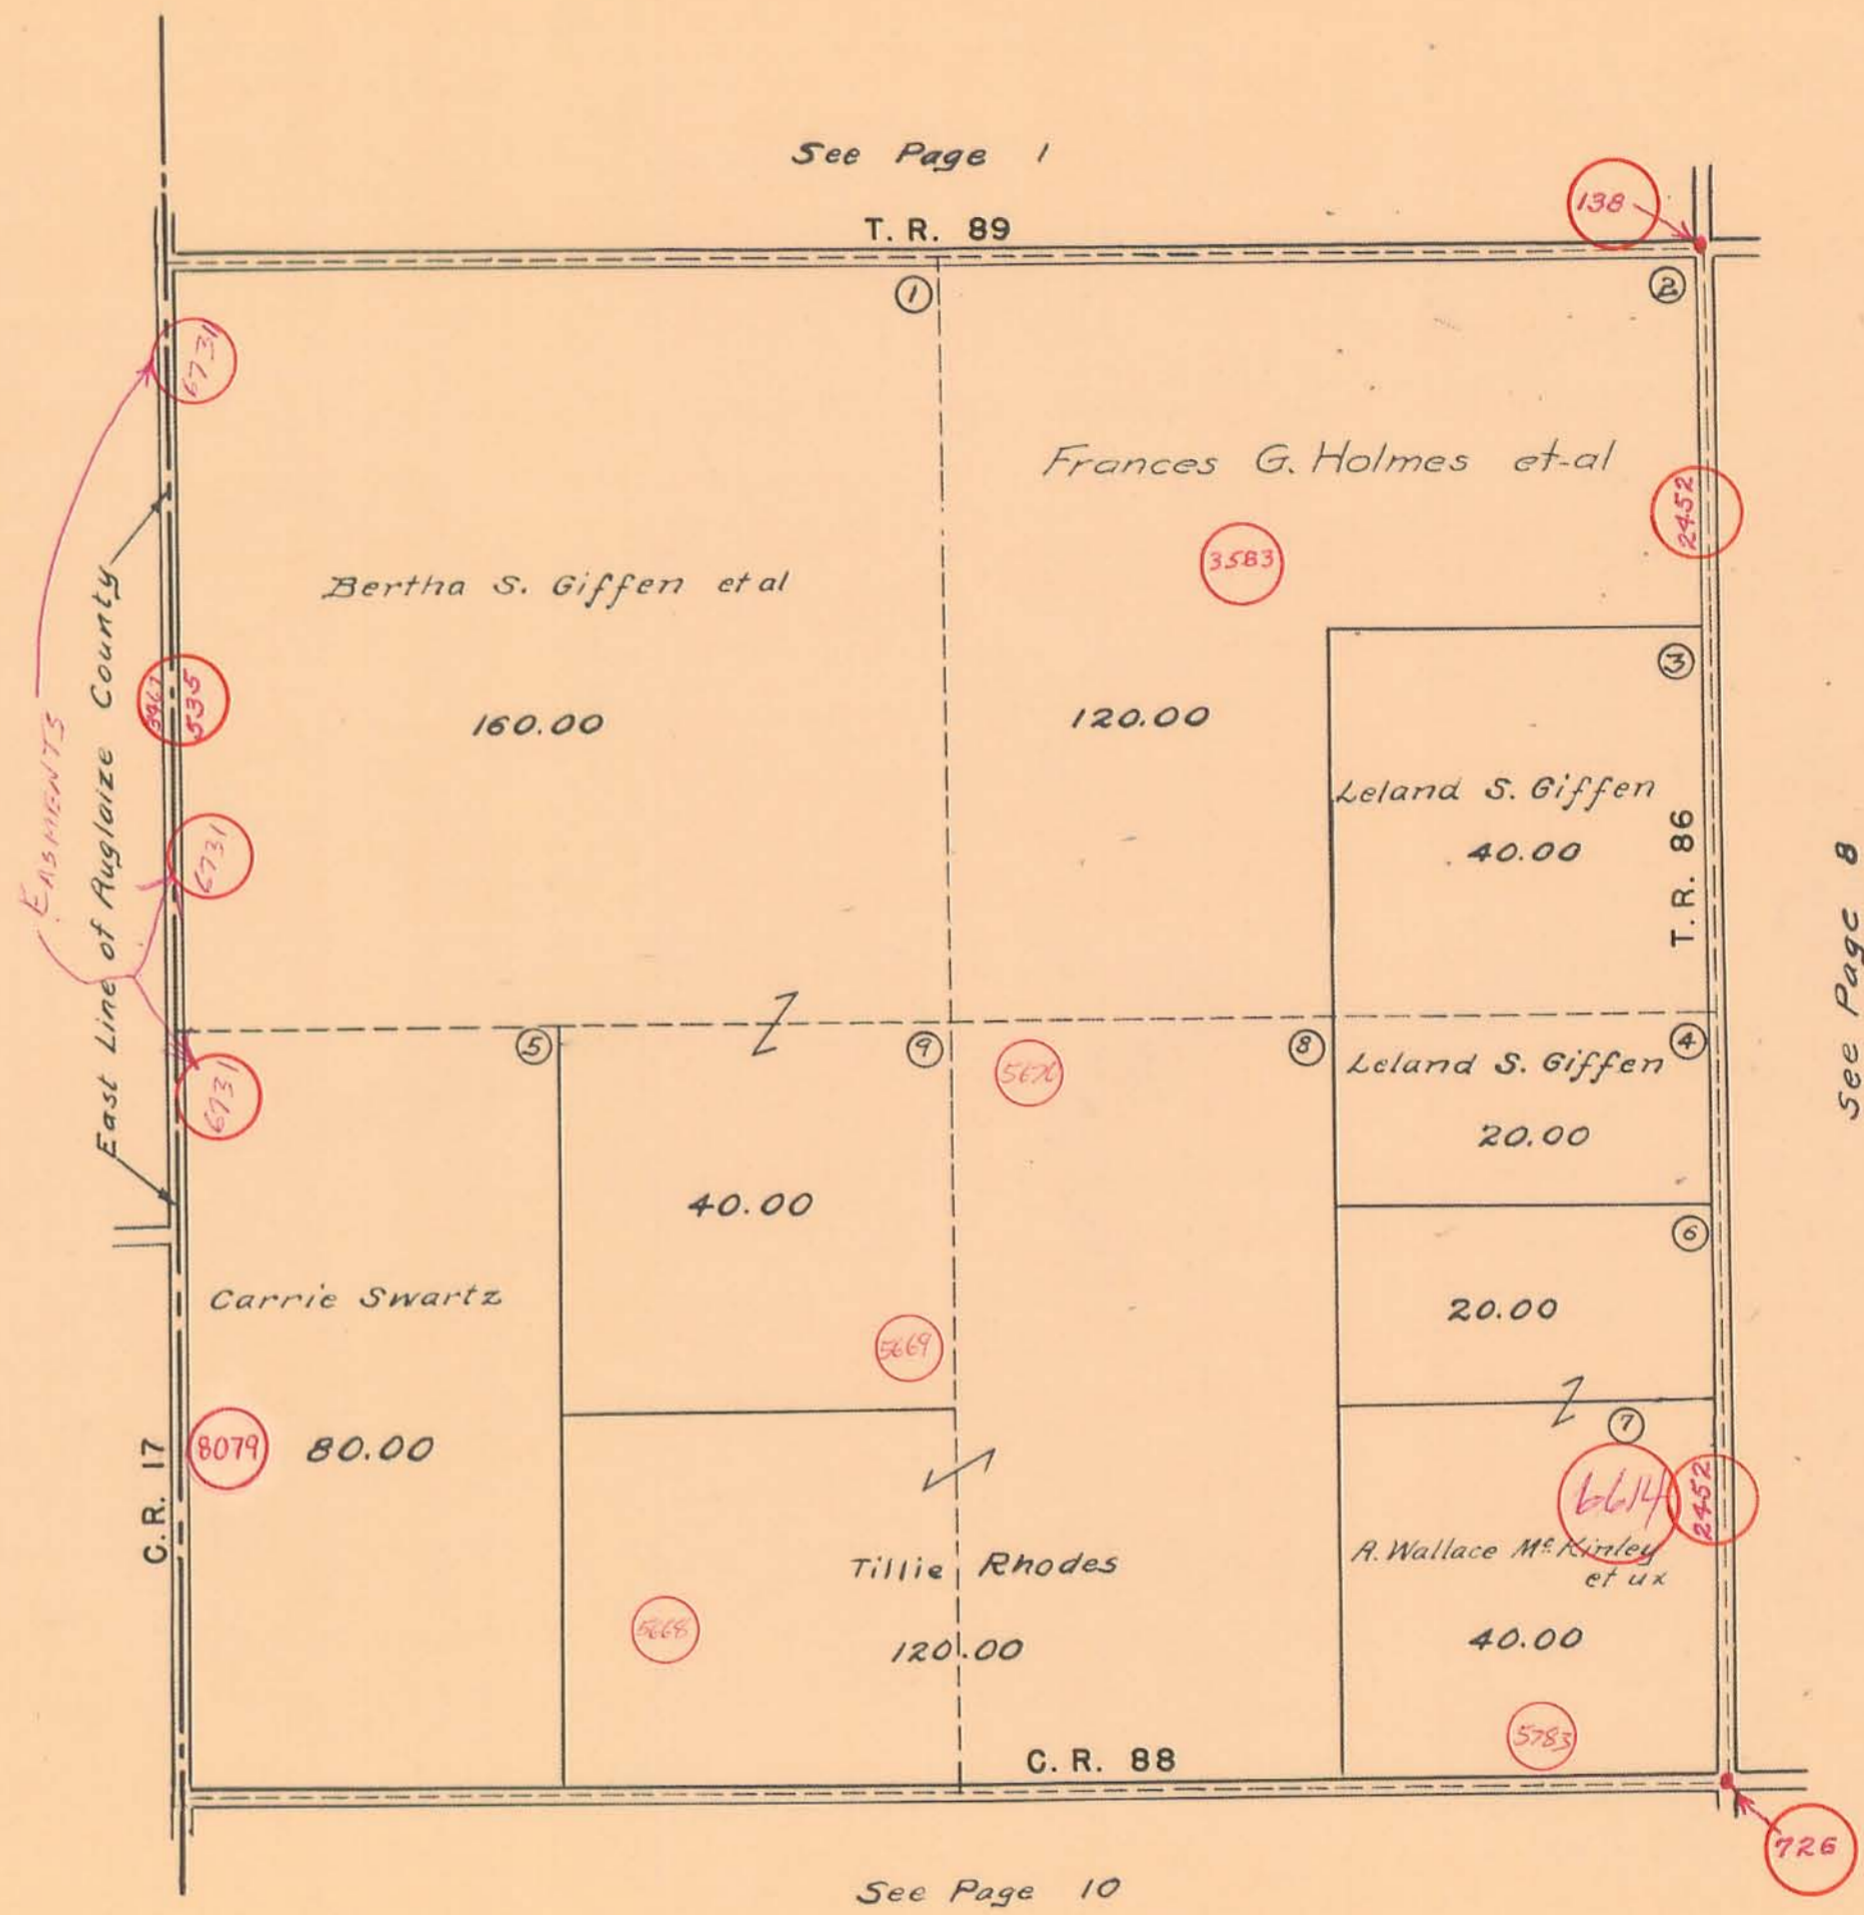

Revised 1-21-38
W. R. Wright

E. K. Core