


STOKES TOWNSHIP

SEC. 23 - T.6 S. - R.8 E. PART

HOLIDAY SHORES ALLOTMENT NO. 3

SCALE: 1" = 100'

SEE PAGE 104

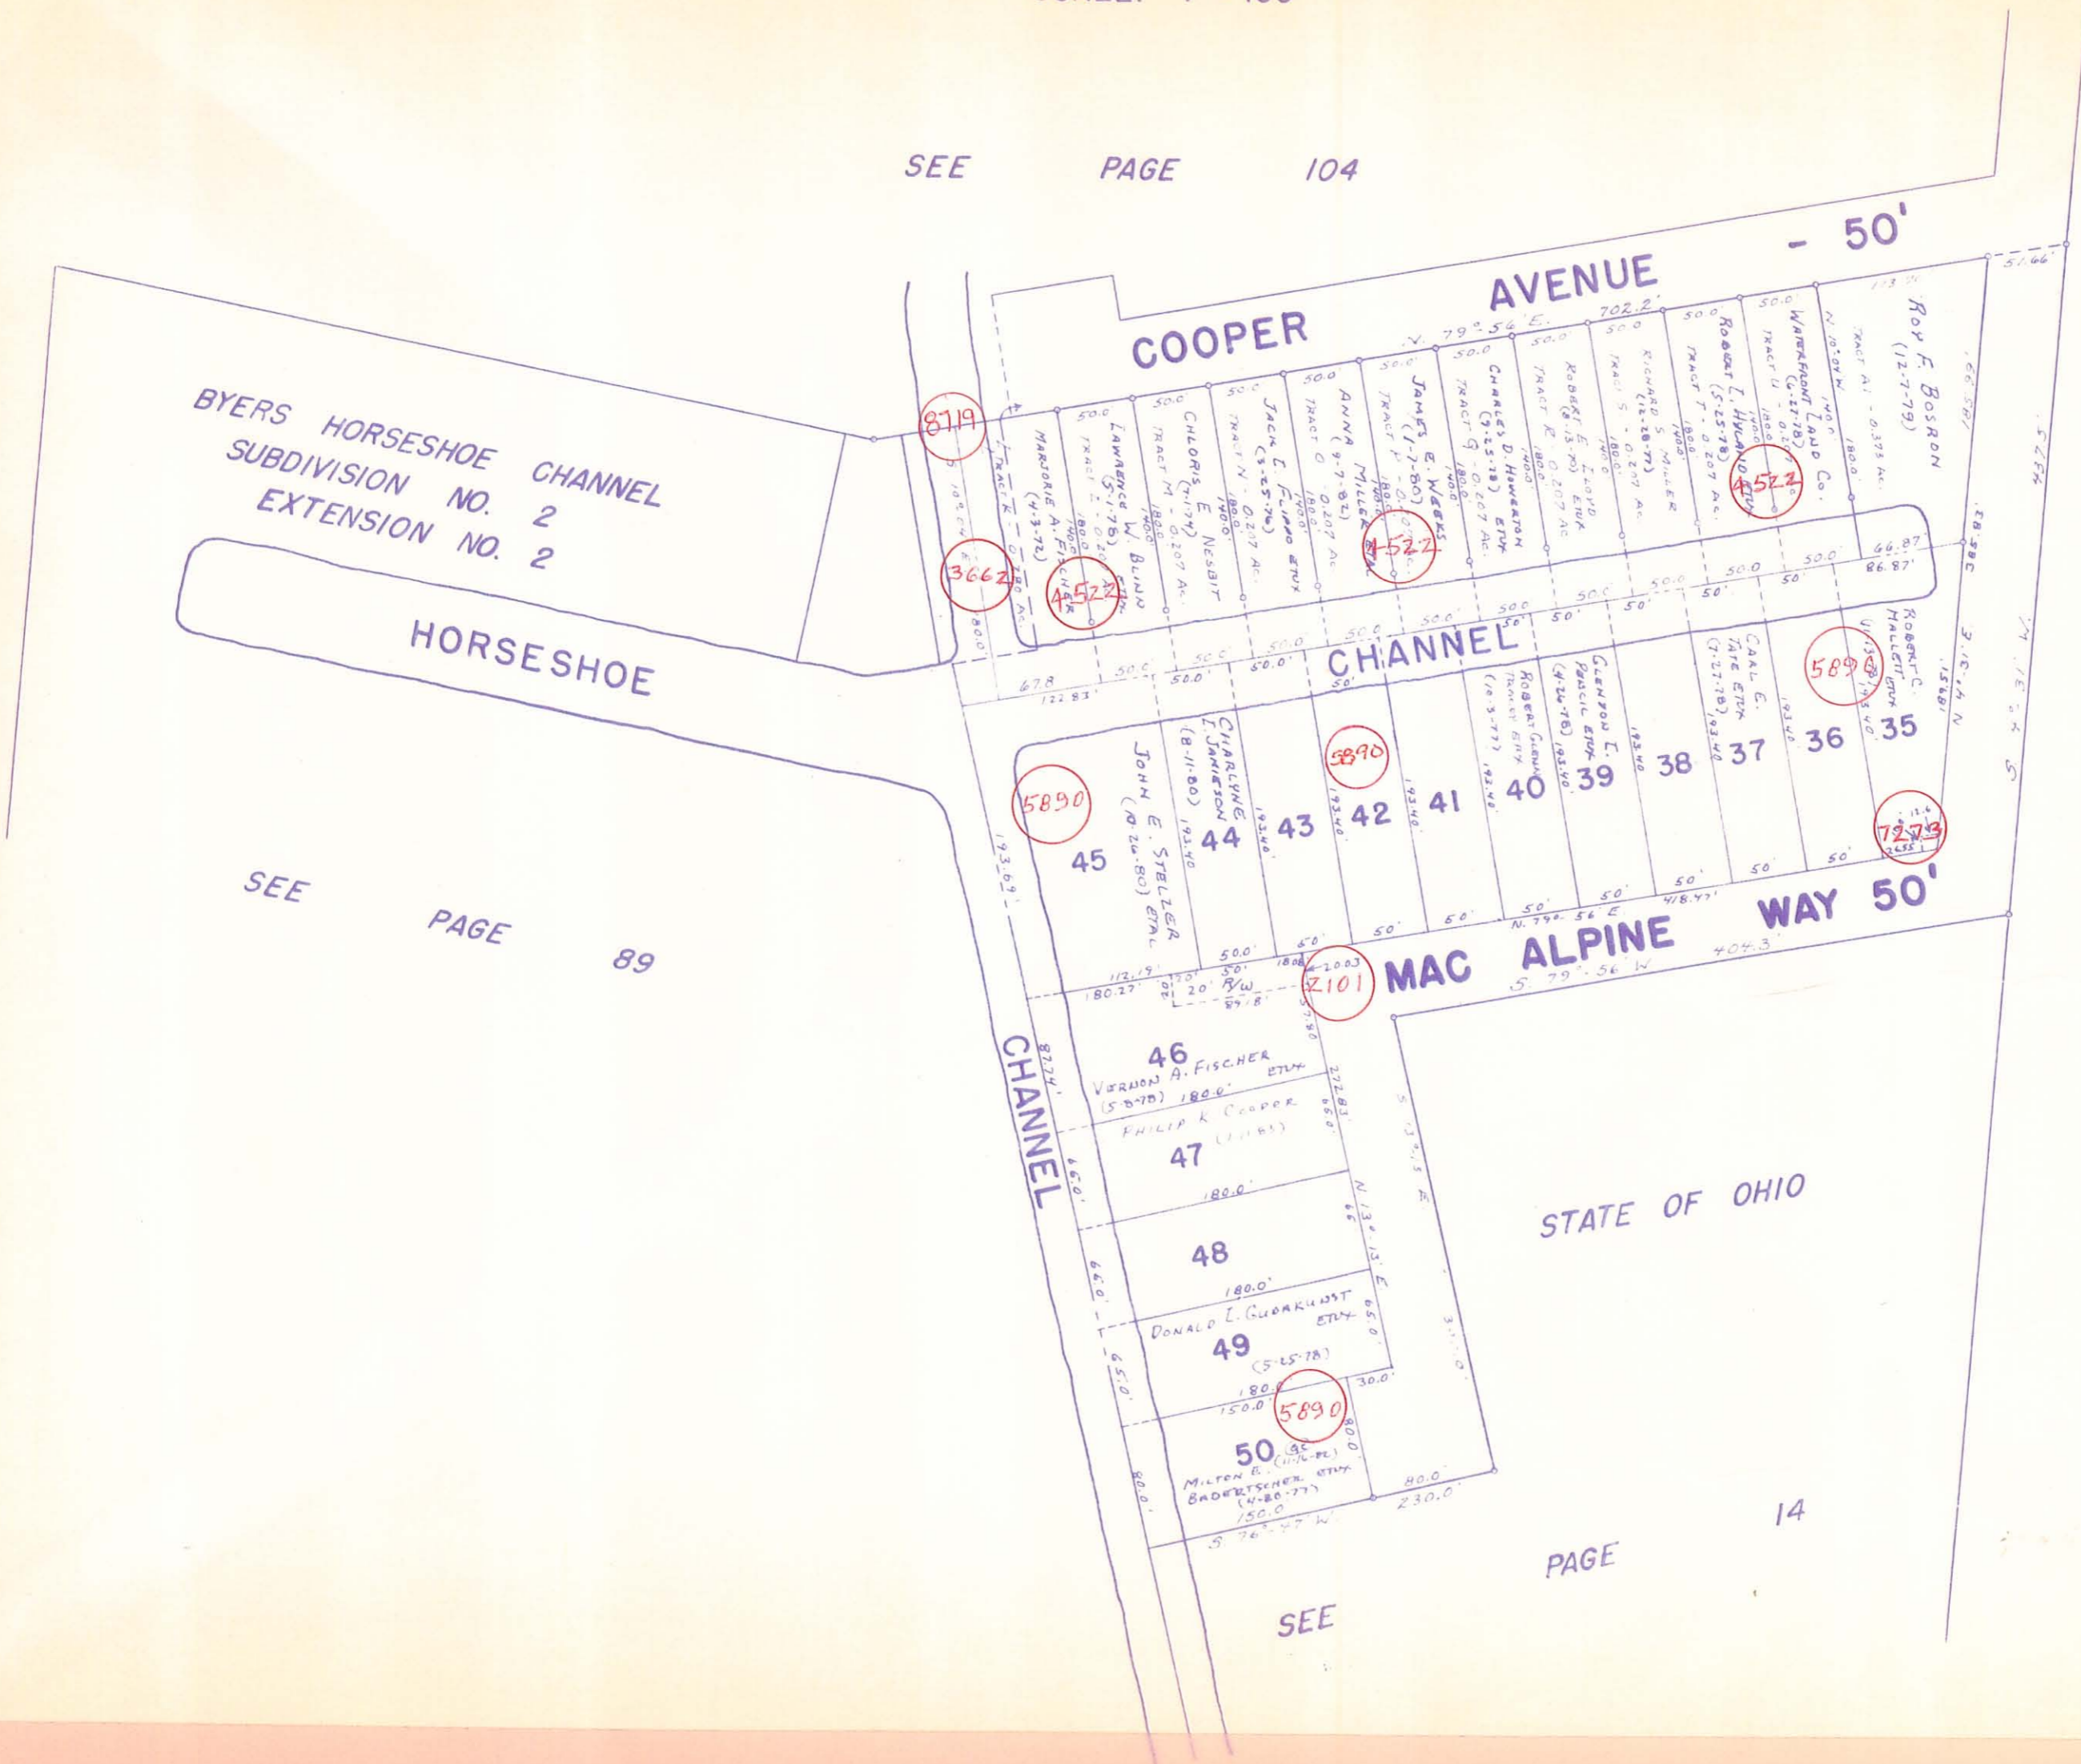

BYERS HORSESHOE CHANNEL
SUBDIVISION NO. 2
EXTENSION NO. 2

HORSESHOE CHANNEL

COOPER AVENUE

CHANNEL

MAC ALPINE WAY 50'

STATE OF OHIO

SEE PAGE 89

SEE PAGE 14

SEE

PAGE

14