


STOKES TOWNSHIP
VIRGINIA MILITARY SURVEY 13393

SCALE 10 CHAINS TO THE INCH

See Page 36

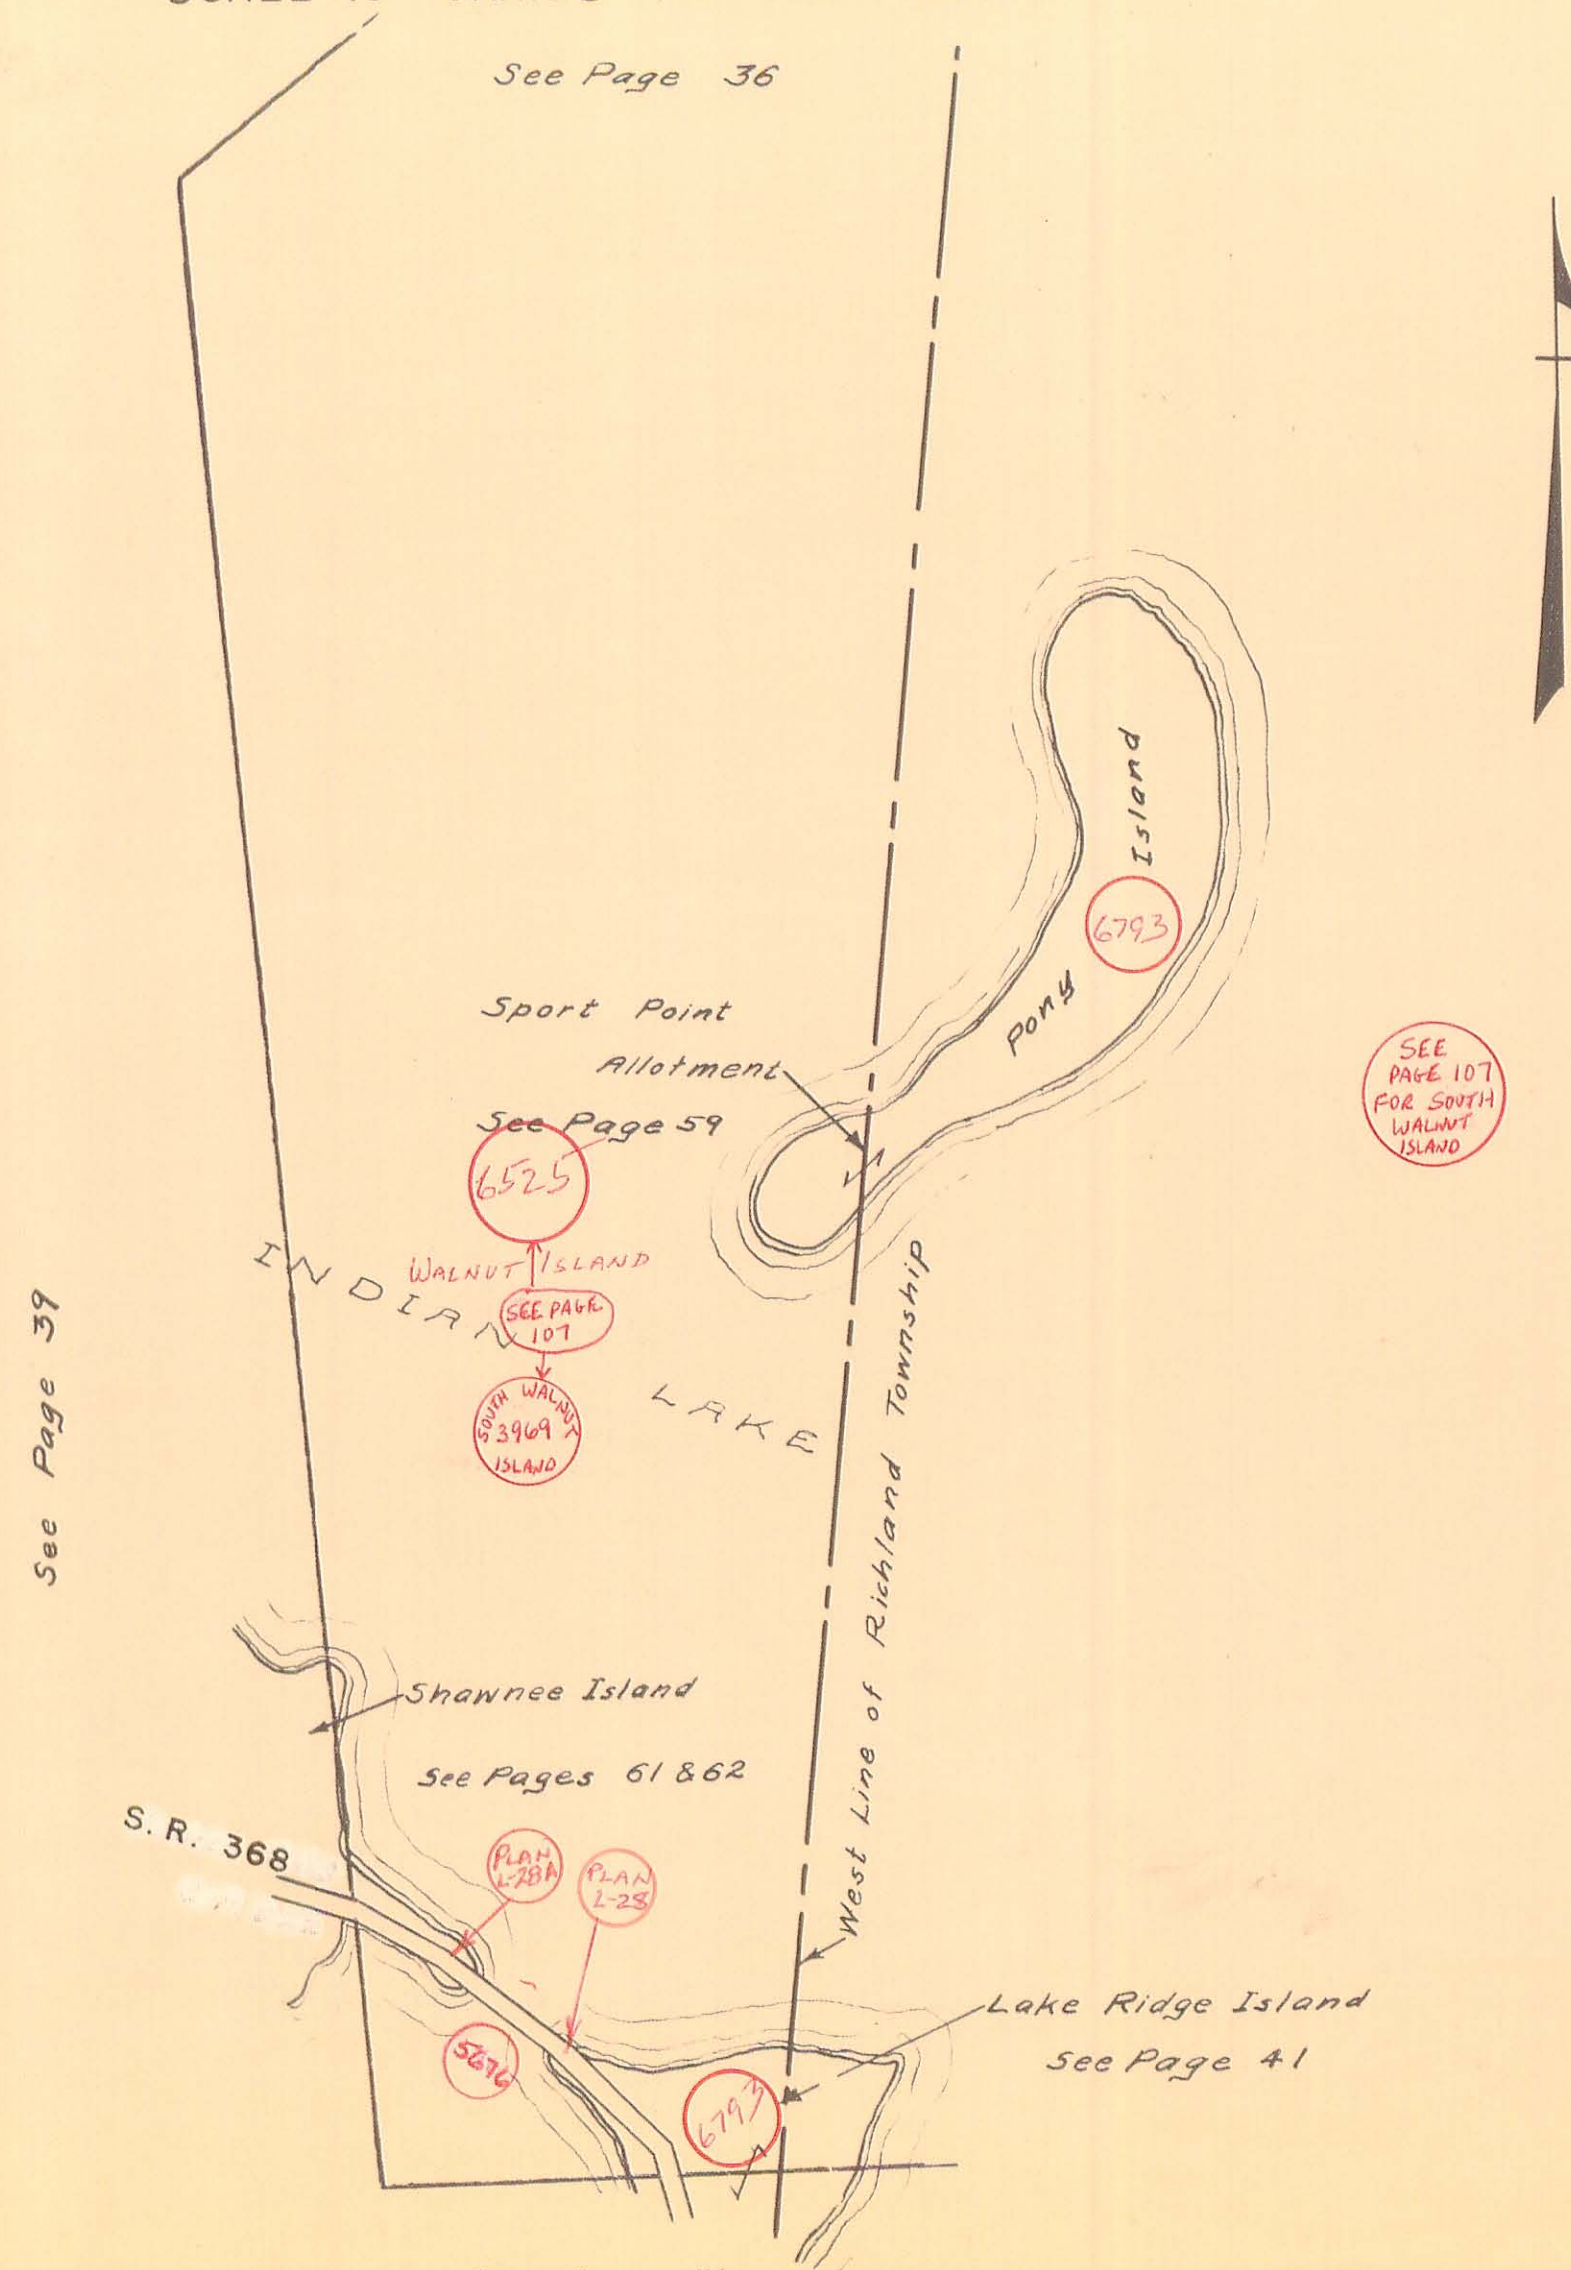

SEE PAGE 107 FOR SOUTH WALNUT ISLAND

See Page 39

See Pages 61 & 62

Lake Ridge Island
See Page 41

See Page 41