


WASHINGTON TOWNSHIP  
SECTION 24 TOWN 7 S. RANGE 8 E.

LEWISTOWN

SCALE 200 FEET TO THE INCH

- NOTE "A" Alley Vacated 8-24-88  
Res. 432-88 (R-7826)
- NOTE "B" ALLEY VACATED (ORDINANCE NO. 332-91)  
(7-25-91)
- NOTE "C" ALLEY VACATED (RESOLUTION 236-05 (S-19-2005)  
SEE R-4537
- NOTE "D" ALLEY VACATED (RESOLUTION 315-10)  
(11-2-2010) SEE R-6356
- NOTE "E" ALLEY VACATION (RESOLUTION NO. 360-10)  
(12-2-2010) SEE R-5708

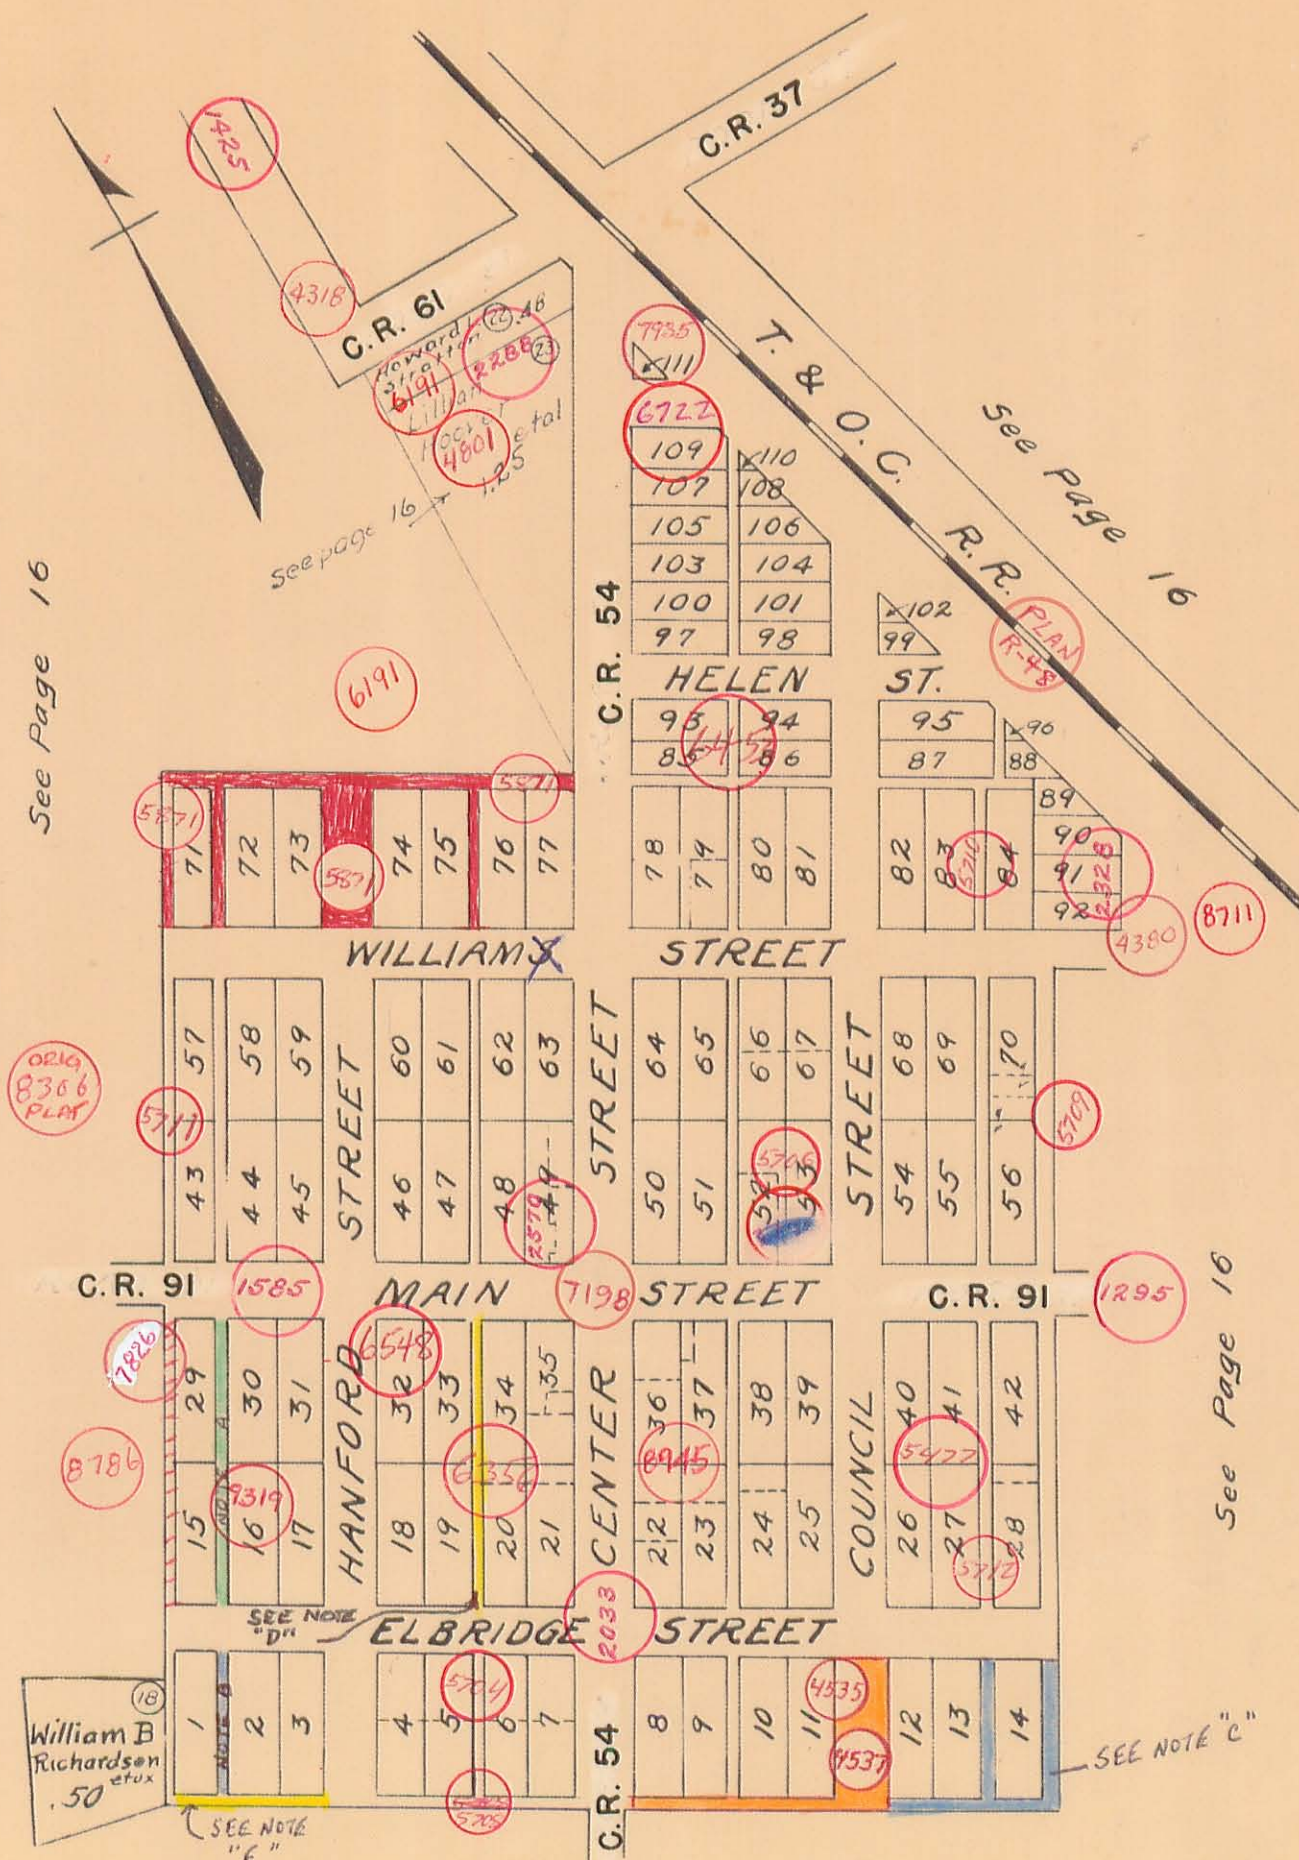

See Page 16