


ZANE TOWNSHIP
 VIRGINIA MILITARY SURVEY 4933

SCALE 10 CHAINS TO THE INCH

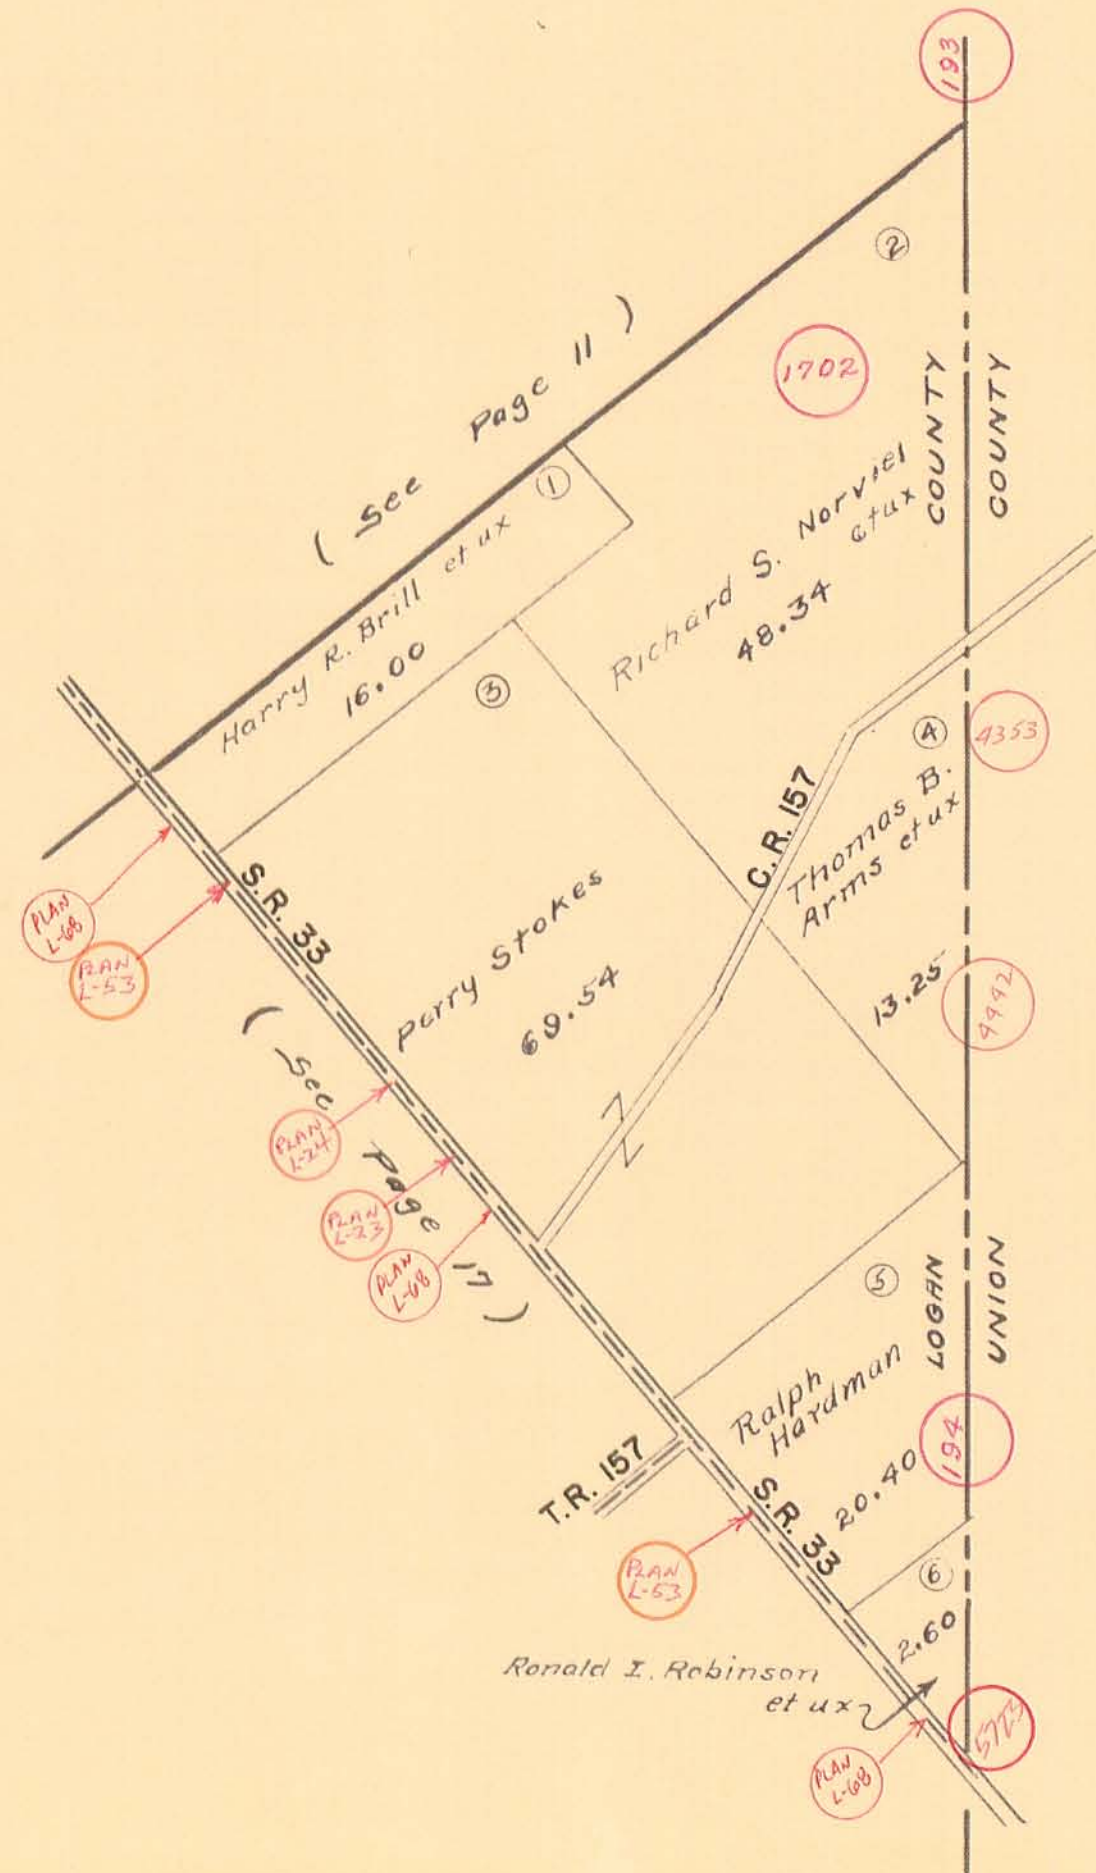

7727 PERRY TWP Honda of America
 8106 PERRY TWP Easements over Honda of America land for Union Rural Electric Company