


40' Road. See Map Road Record No. 2 Page 530
Field Notes Logan County Surveyors Field Book 559 Page 64

Length 5338 Feet
Length 1.011 Miles

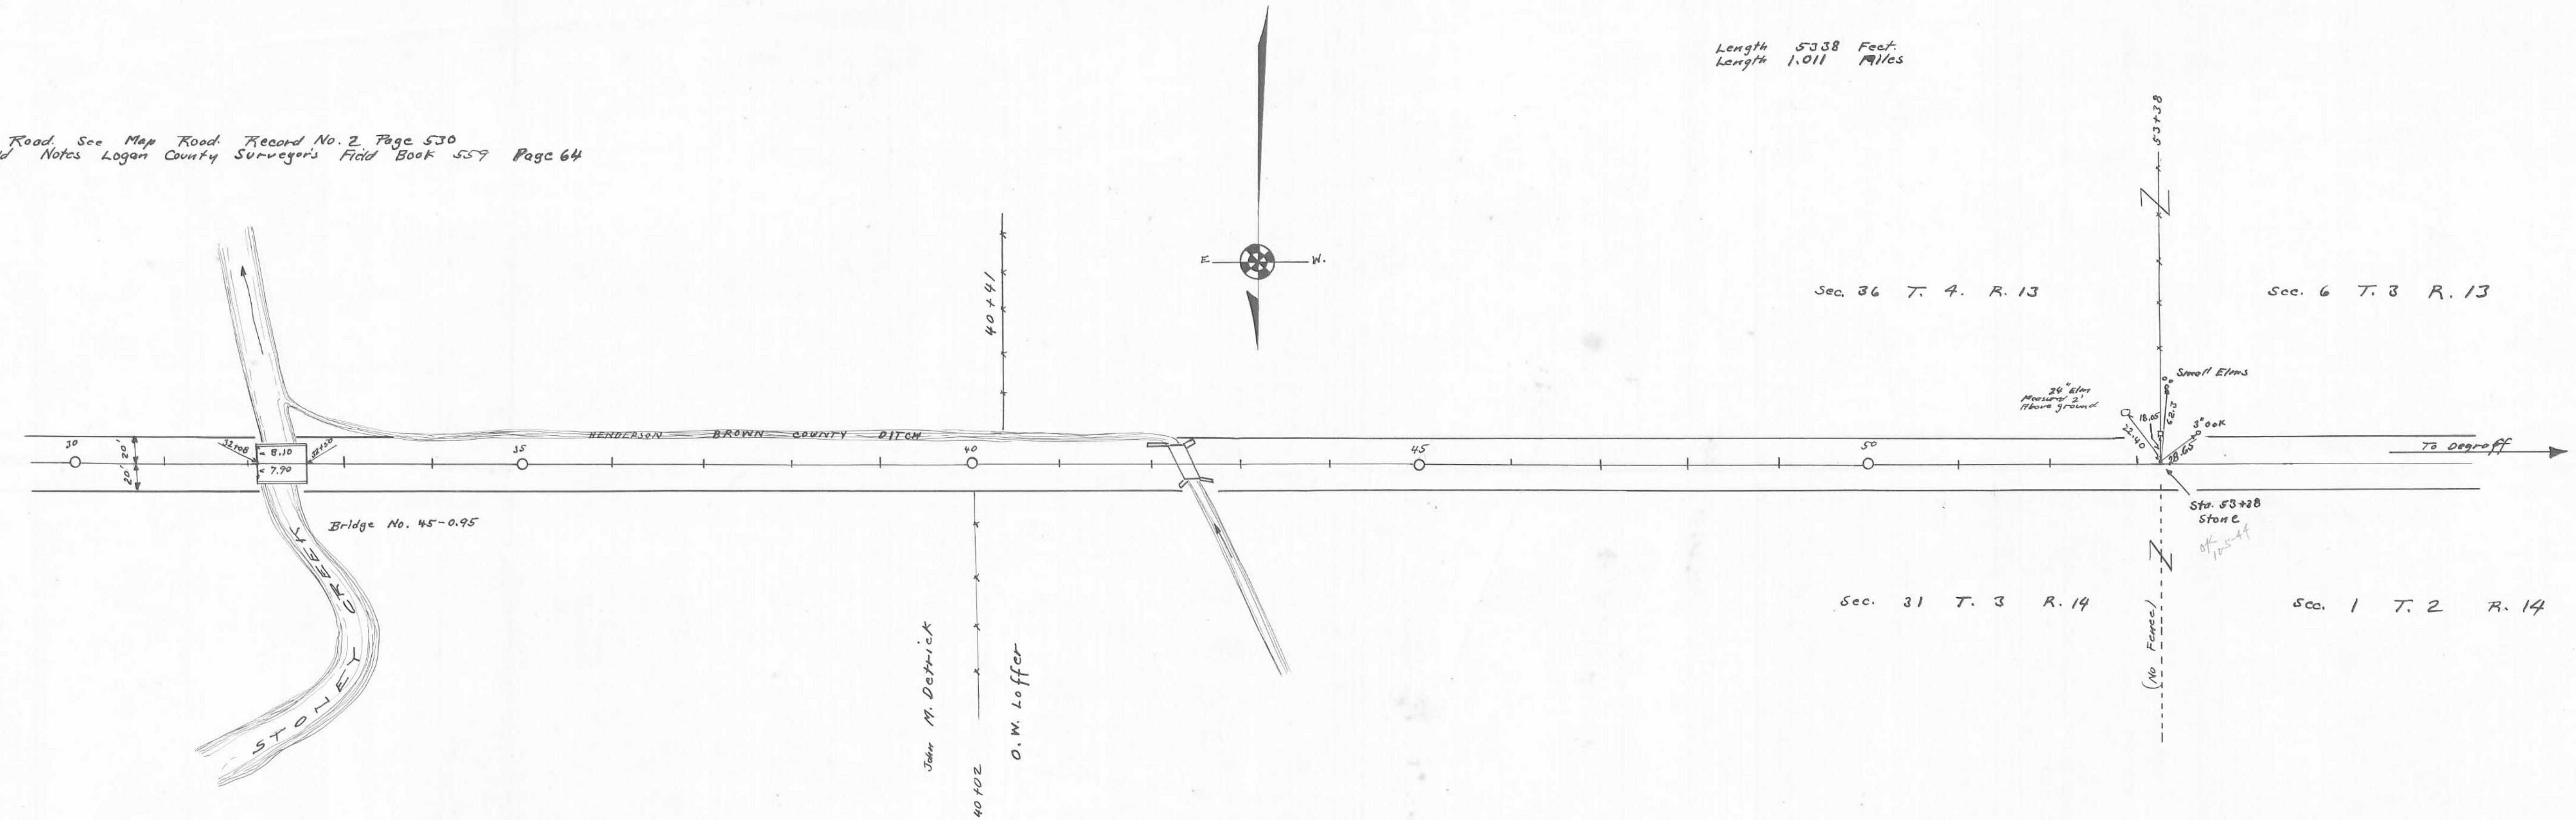

R. B. G. 1932

X-45 A