
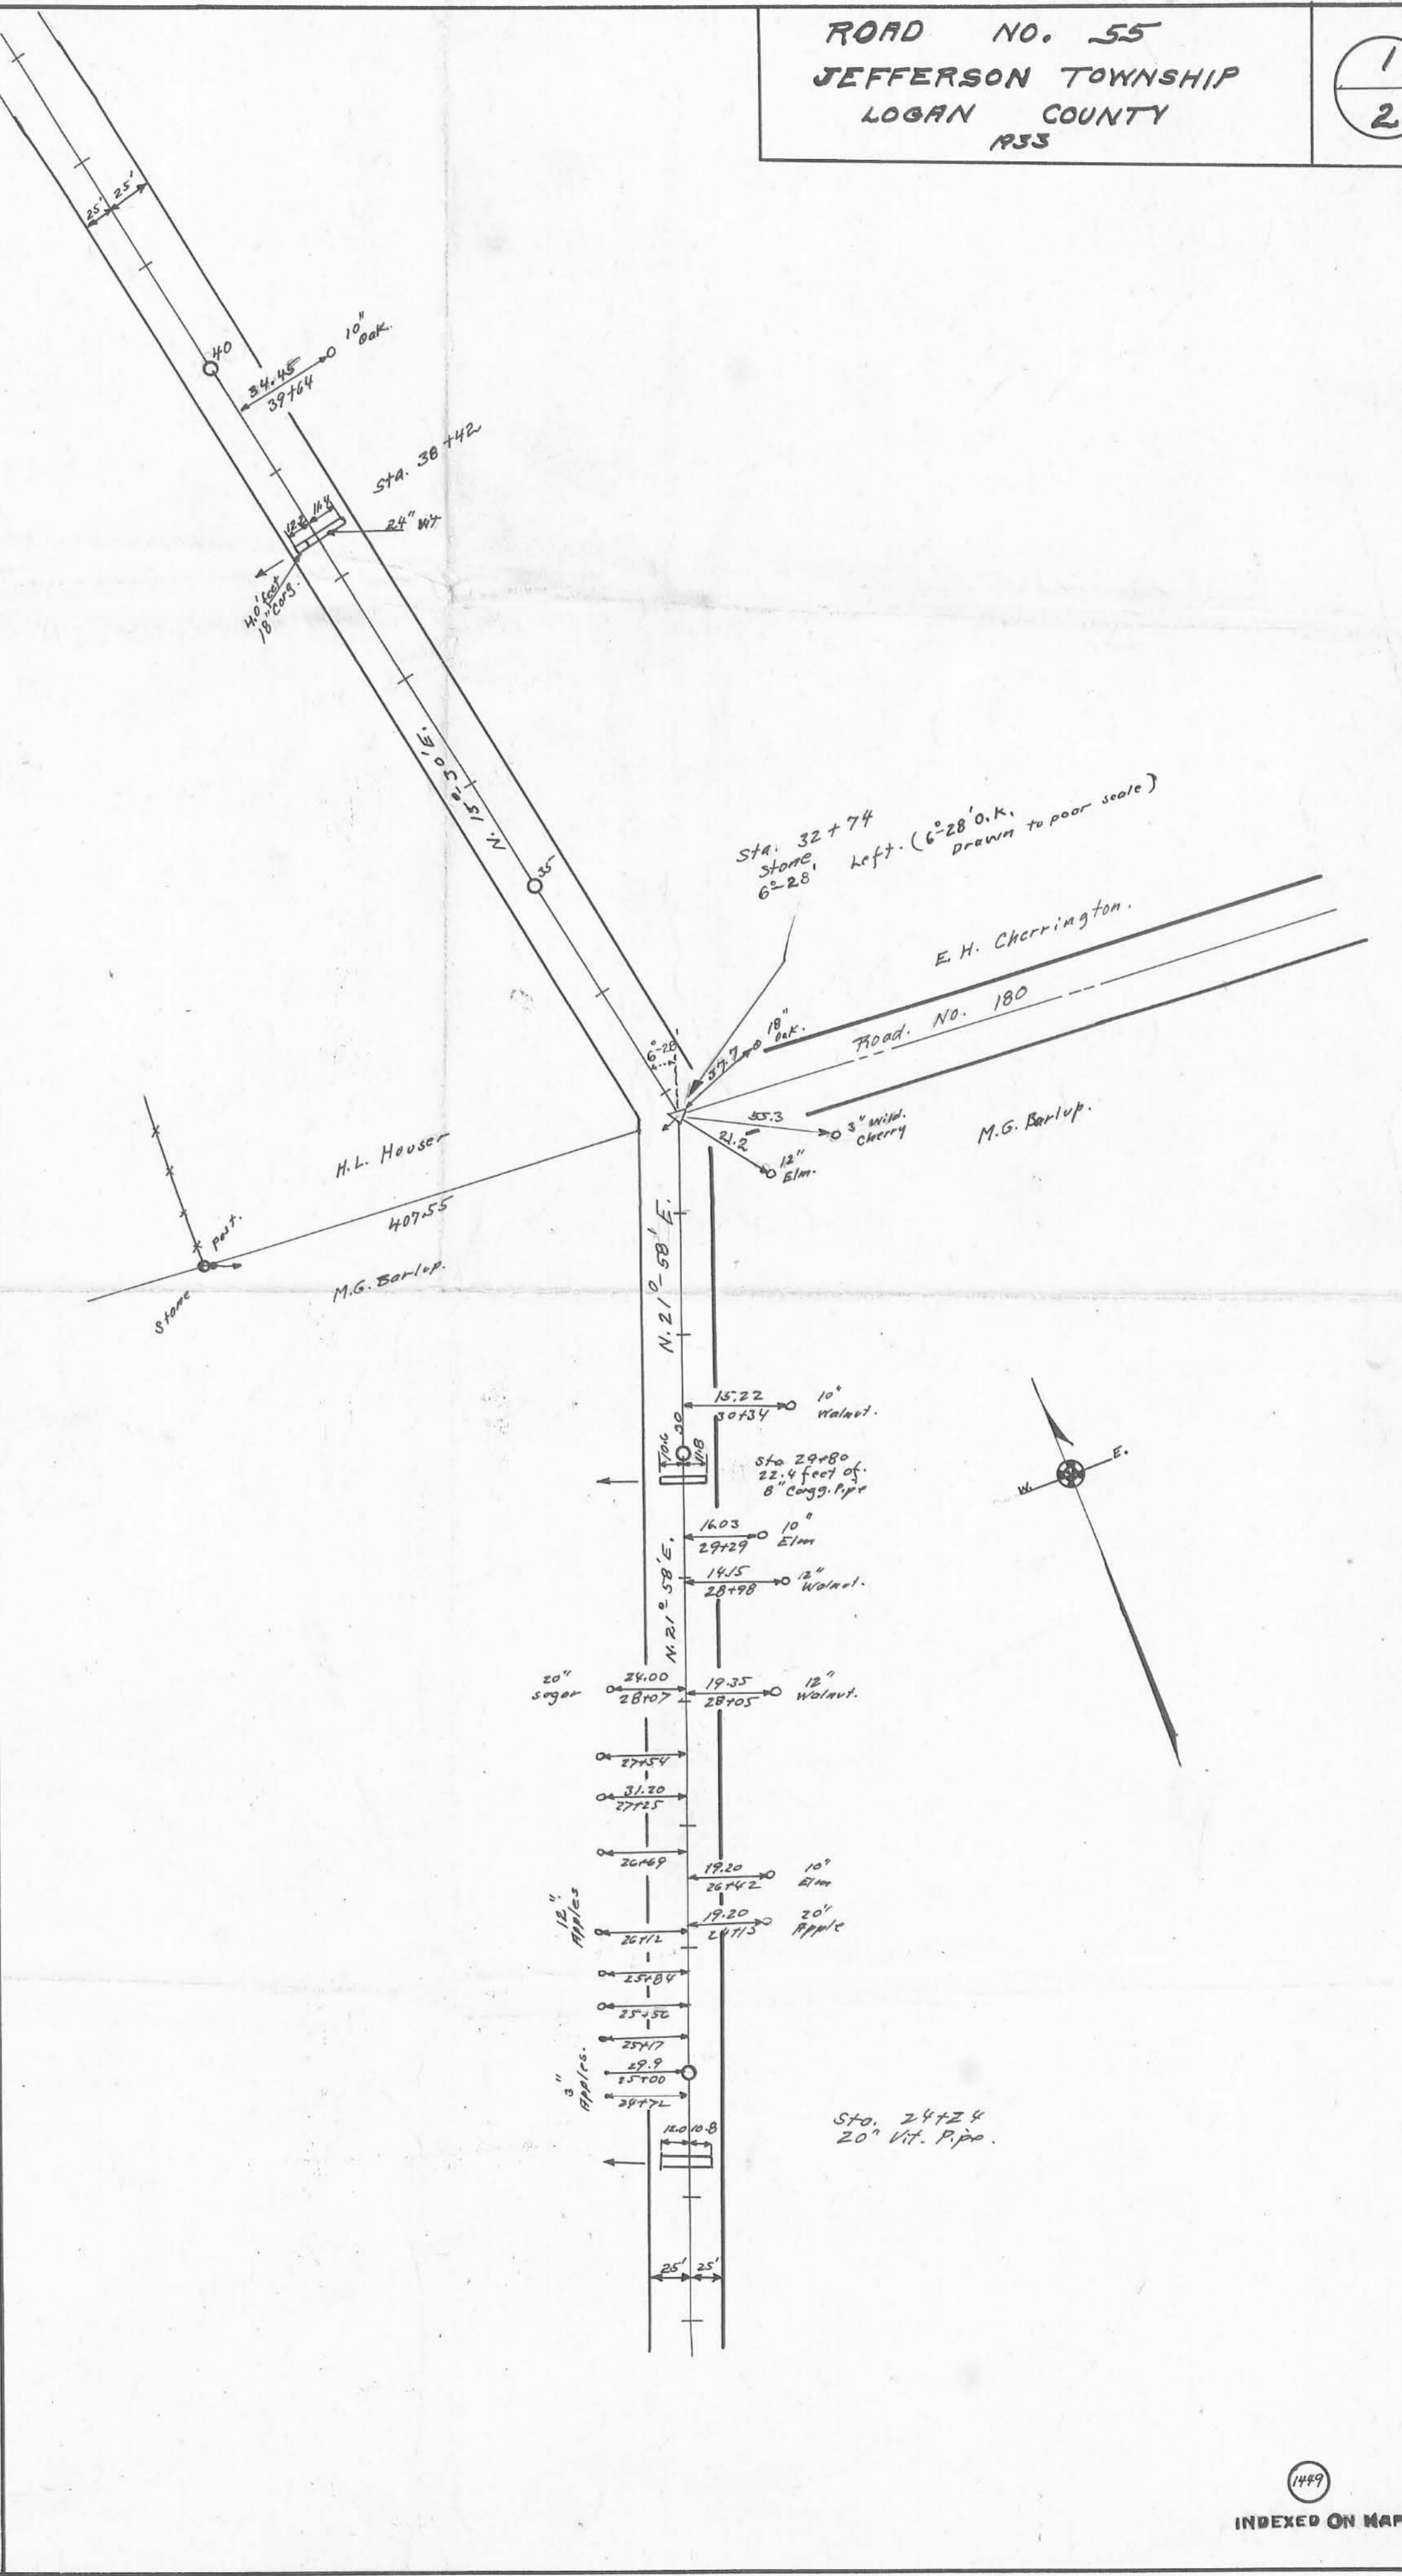


ROAD 55

Field Notes in Logan County Surveyor's Book No. 513 Pages 61 to 71 60' Road, Road record 4 Page 186 Date 1935 Stakes placed for a 50' road. (No reduction made in width from original 60'. Only using 50' at this time.)

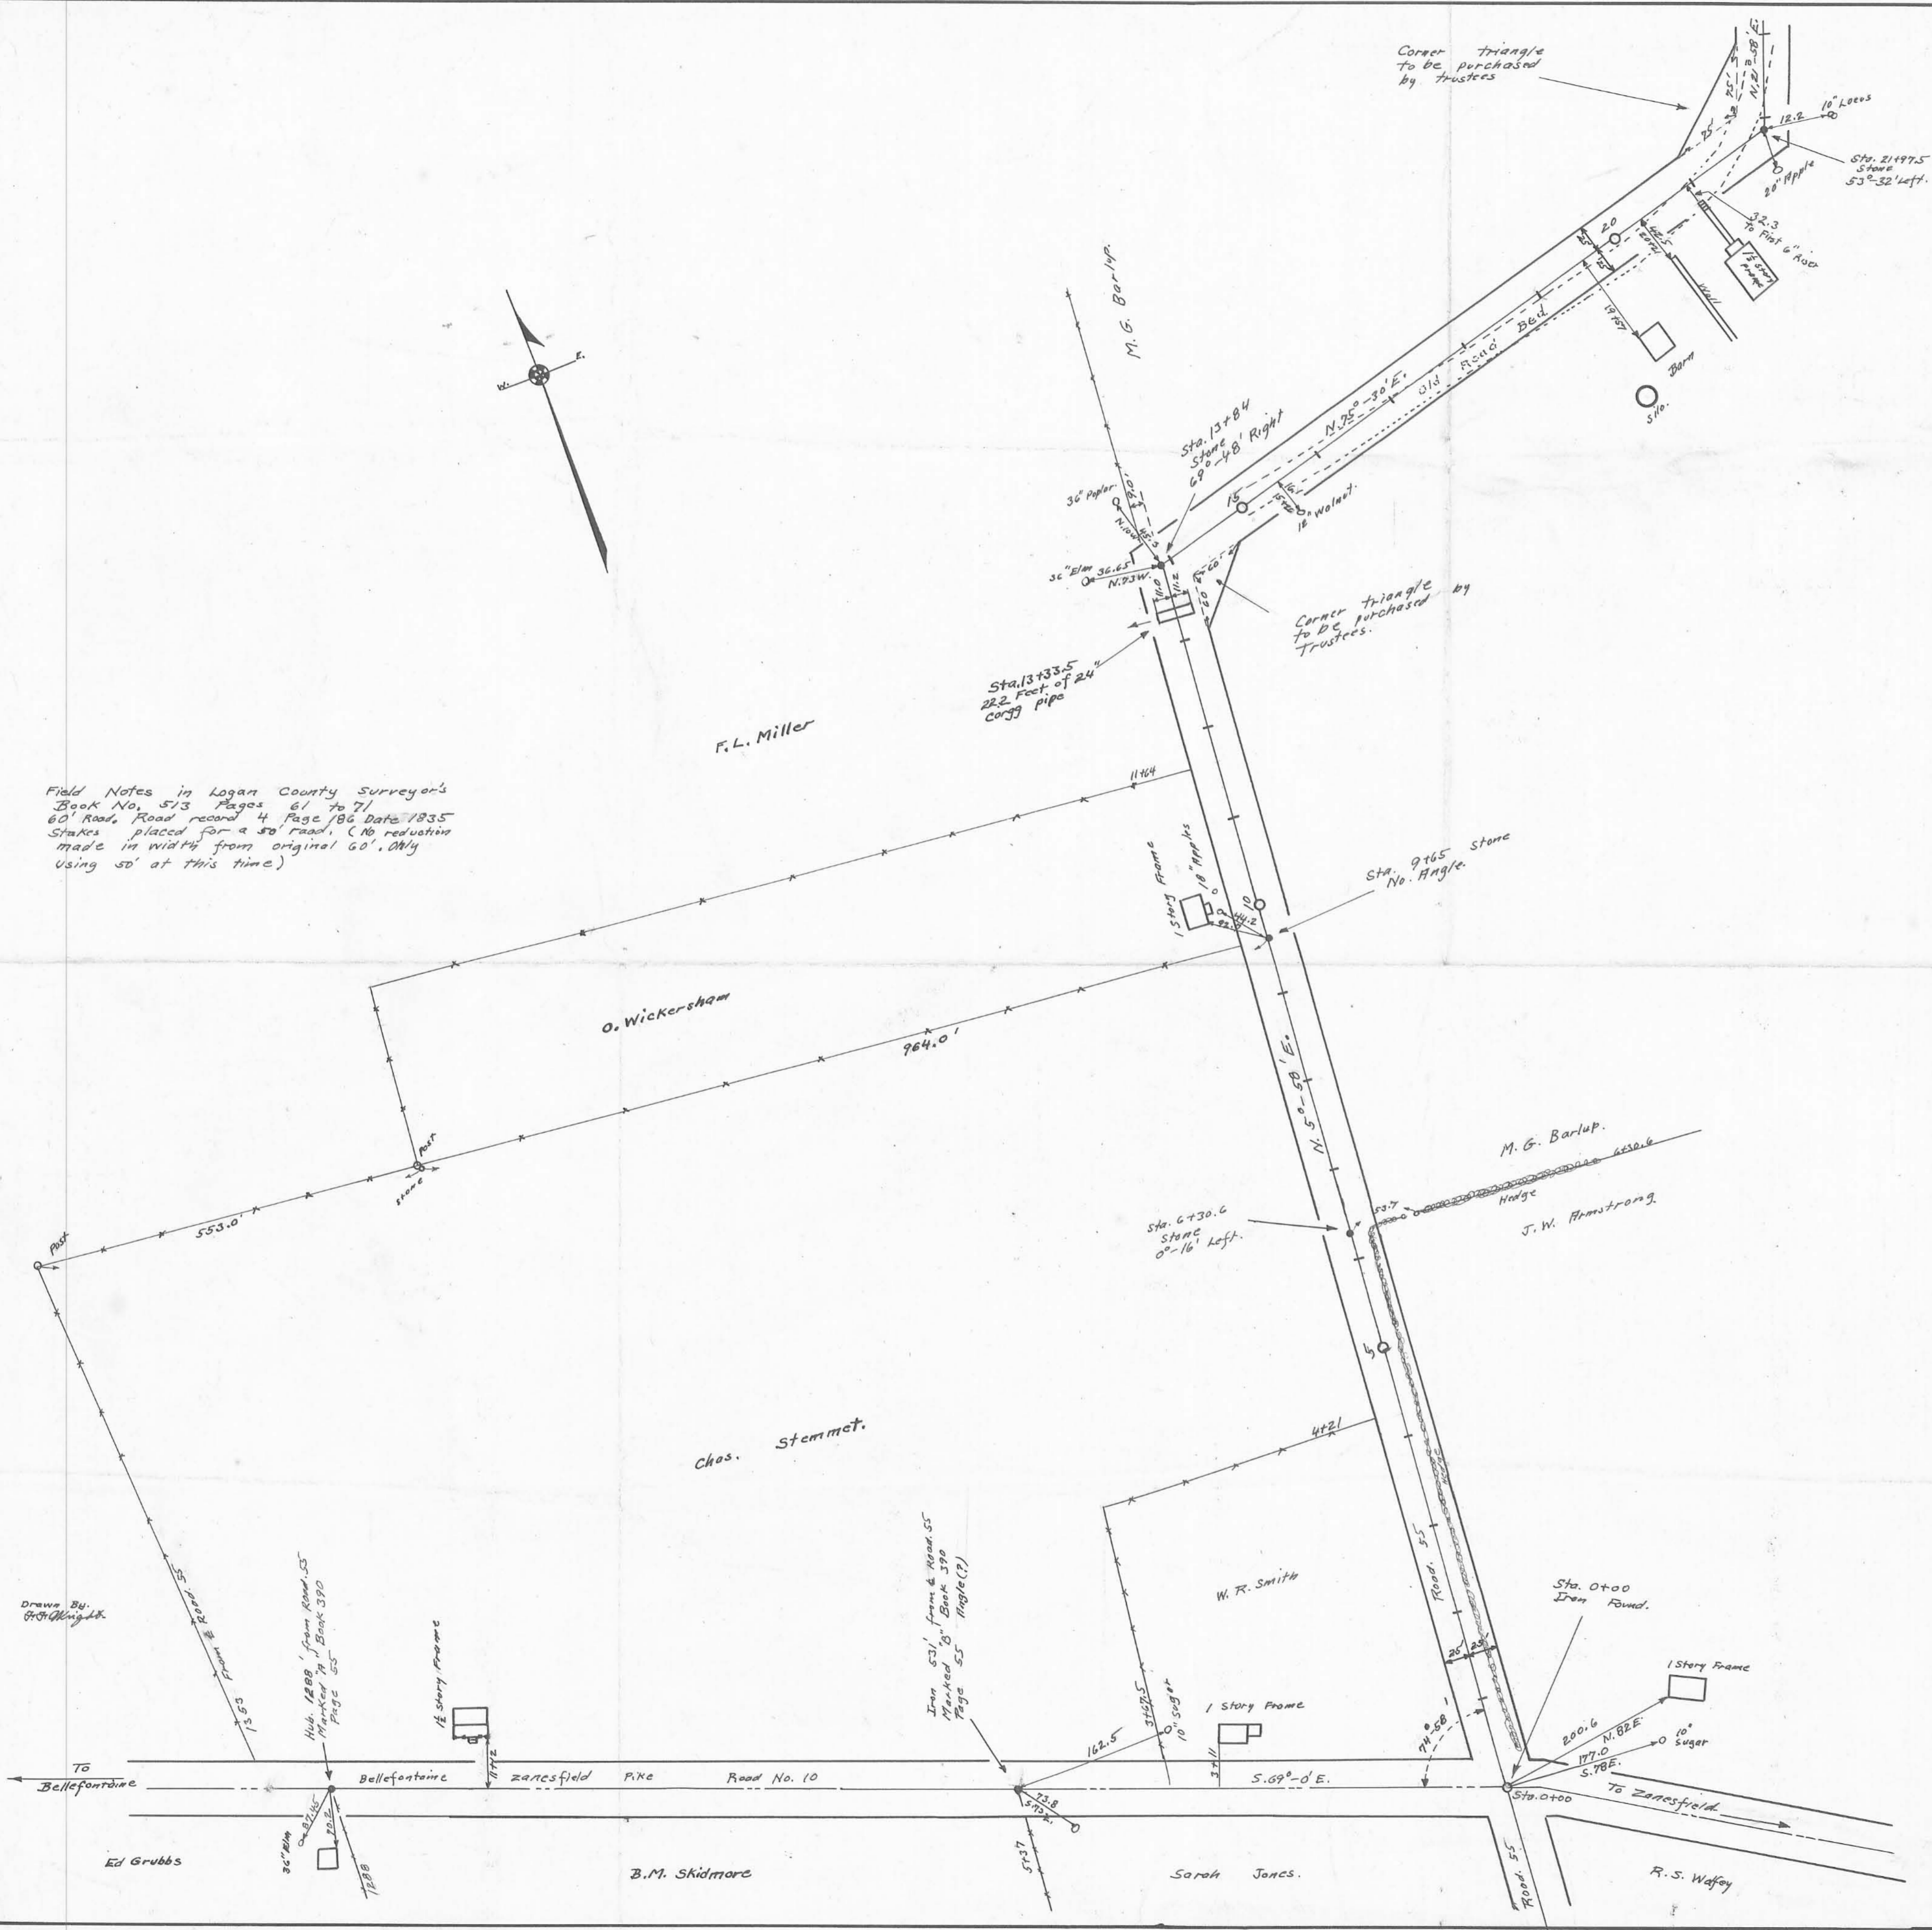

X-55A

X-55A

